


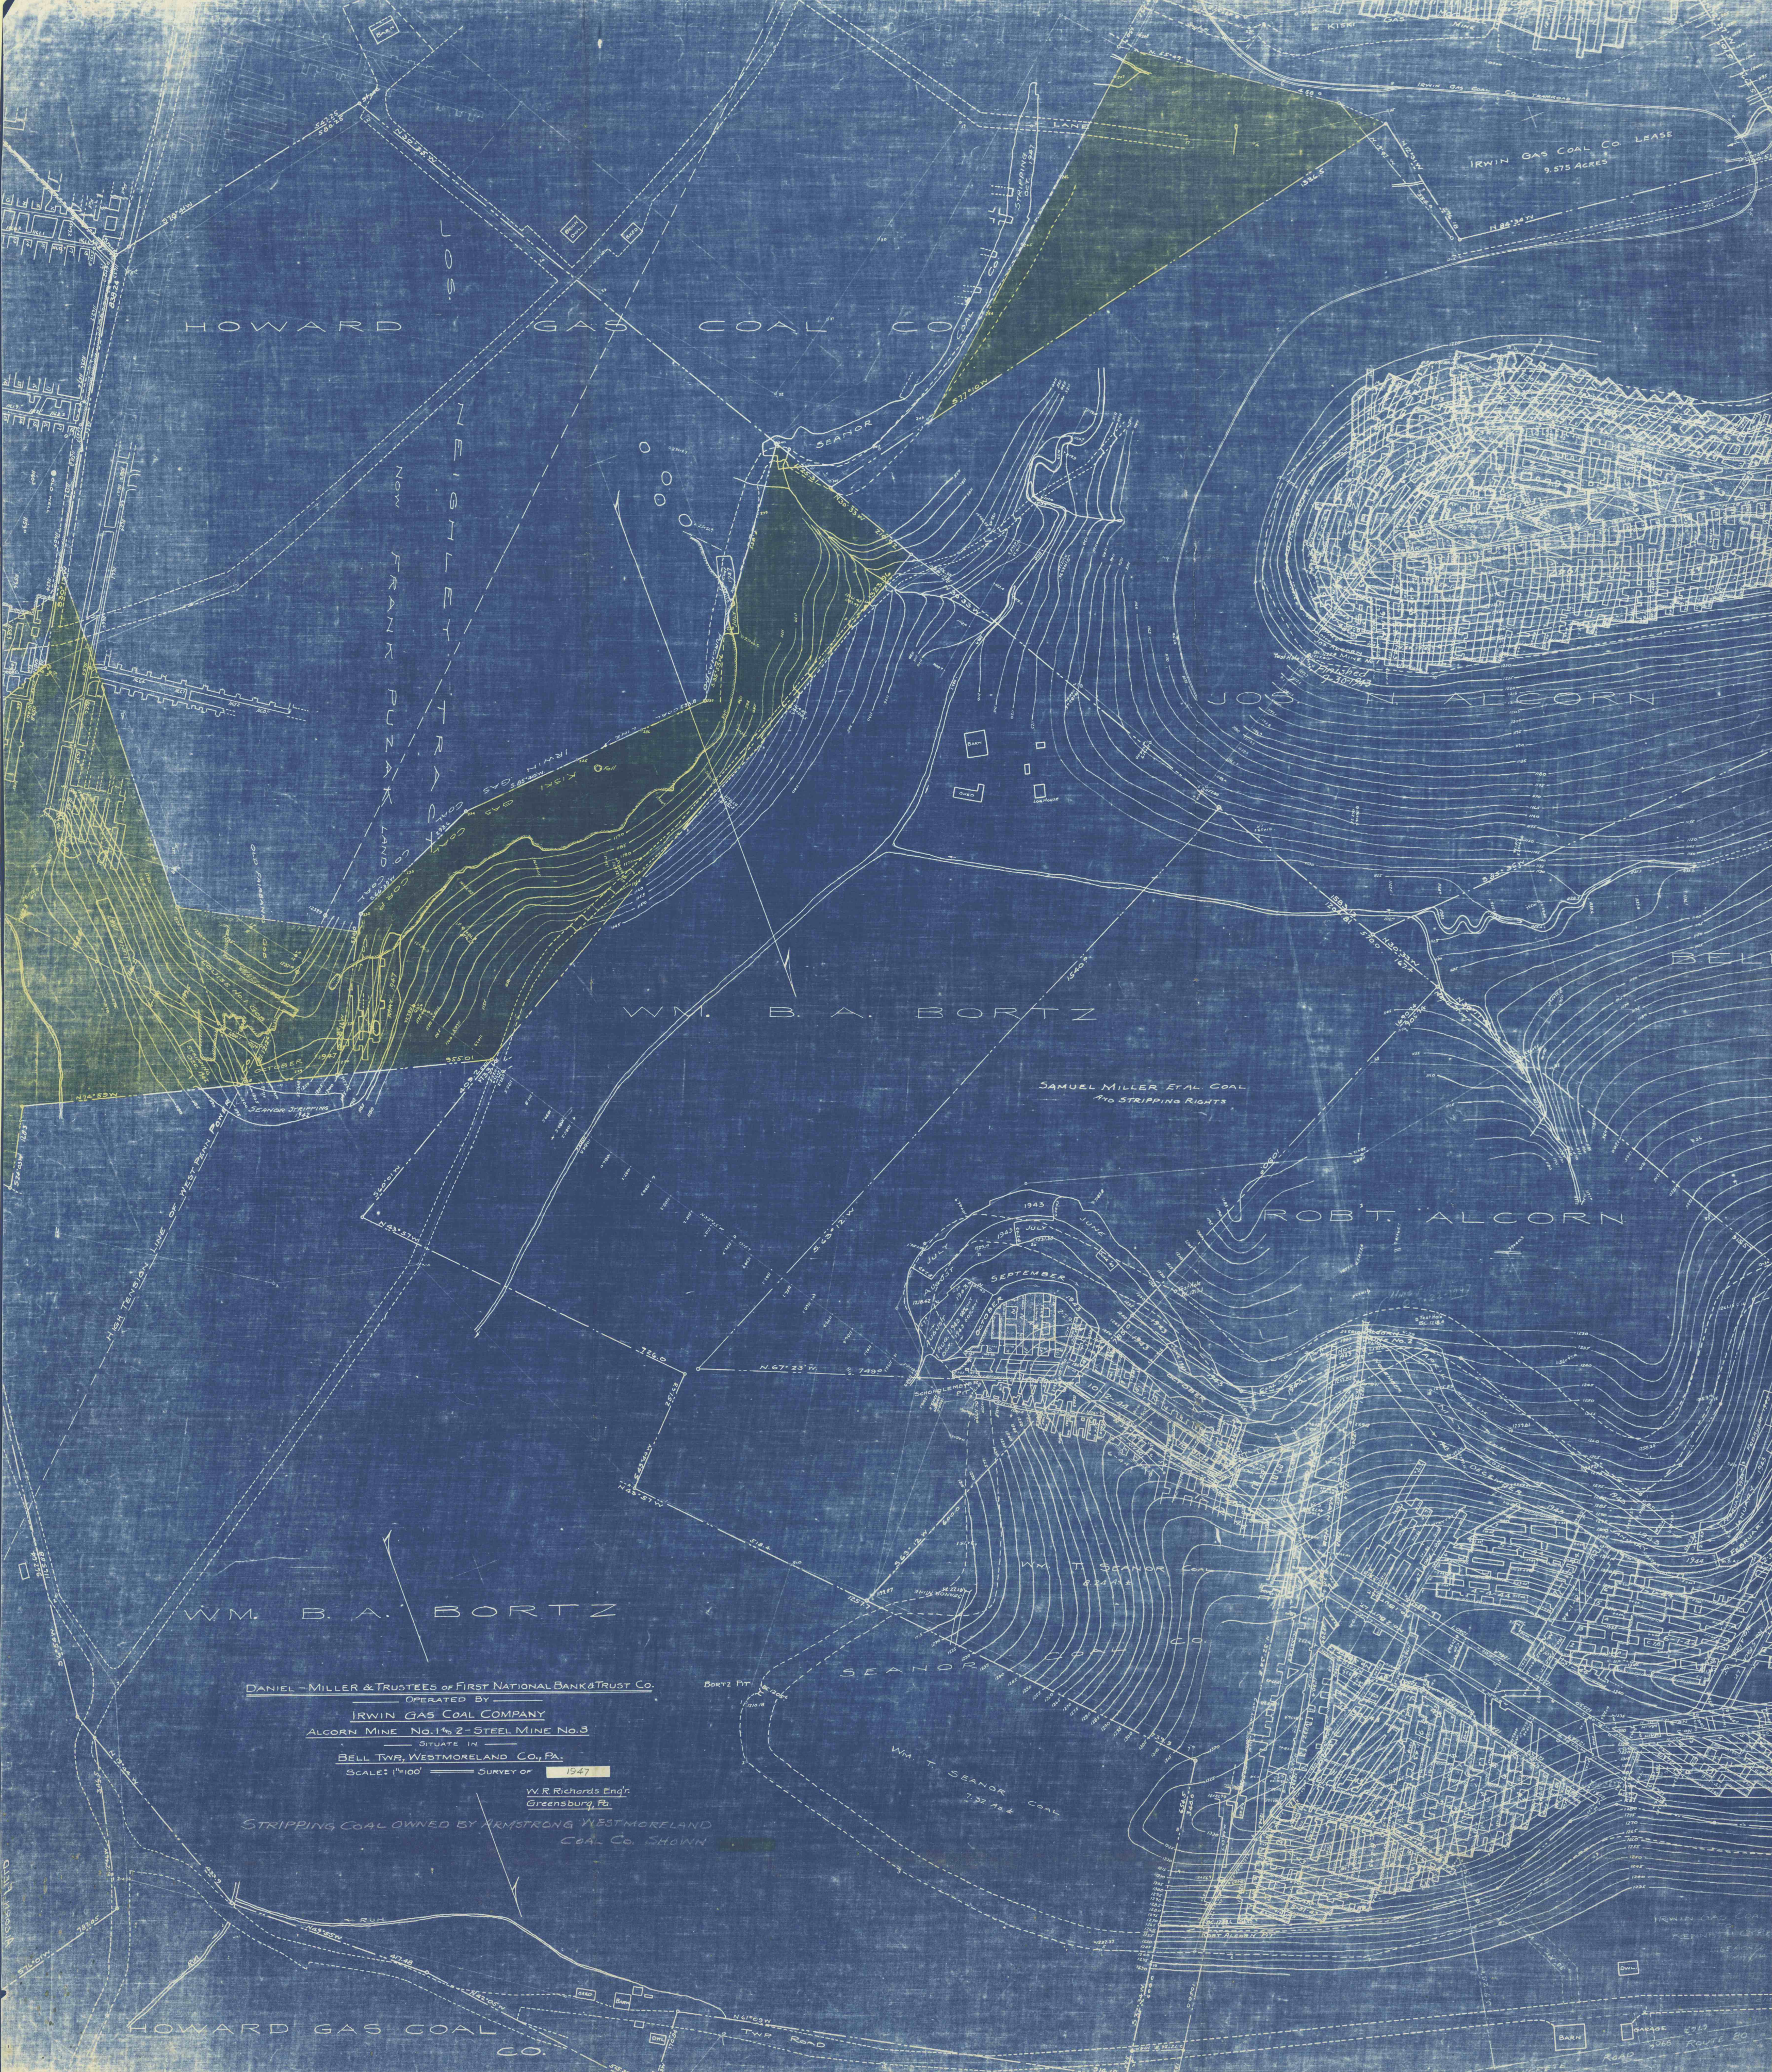

HOWARD GAS COAL CO.

IRWIN GAS COAL CO. LEASE
9.575 ACRES

NEIGHLETT TRACT
NEW FRANK PUNAK LAND CO.

JOHN ALCORN

WM. B. A. BORTZ

SAMUEL MILLER ETAL COAL
AND STRIPPING RIGHTS

ROBT. ALCORN

WM. B. A. BORTZ

DANIEL MILLER & TRUSTEES OF FIRST NATIONAL BANK & TRUST CO.
OPERATED BY
IRWIN GAS COAL COMPANY
ALCORN MINE No. 1 & 2 - STEEL MINE No. 3
SITUATE IN
BELL TWP., WESTMORELAND CO., PA.
SCALE: 1"=100' SURVEY OF 1947

W. R. Richards Eng'r.
Greensburg, Pa.

STRIPPING COAL OWNED BY ARMSTRONG WESTMORELAND
COAL CO. SHOWN

SEABOR COAL CO.

WM. T. SEABOR COAL
7.32 ACRES

HOWARD GAS COAL
CO.

TWP. ROAD

CONCRETE ROAD 3066 ROUTE 80