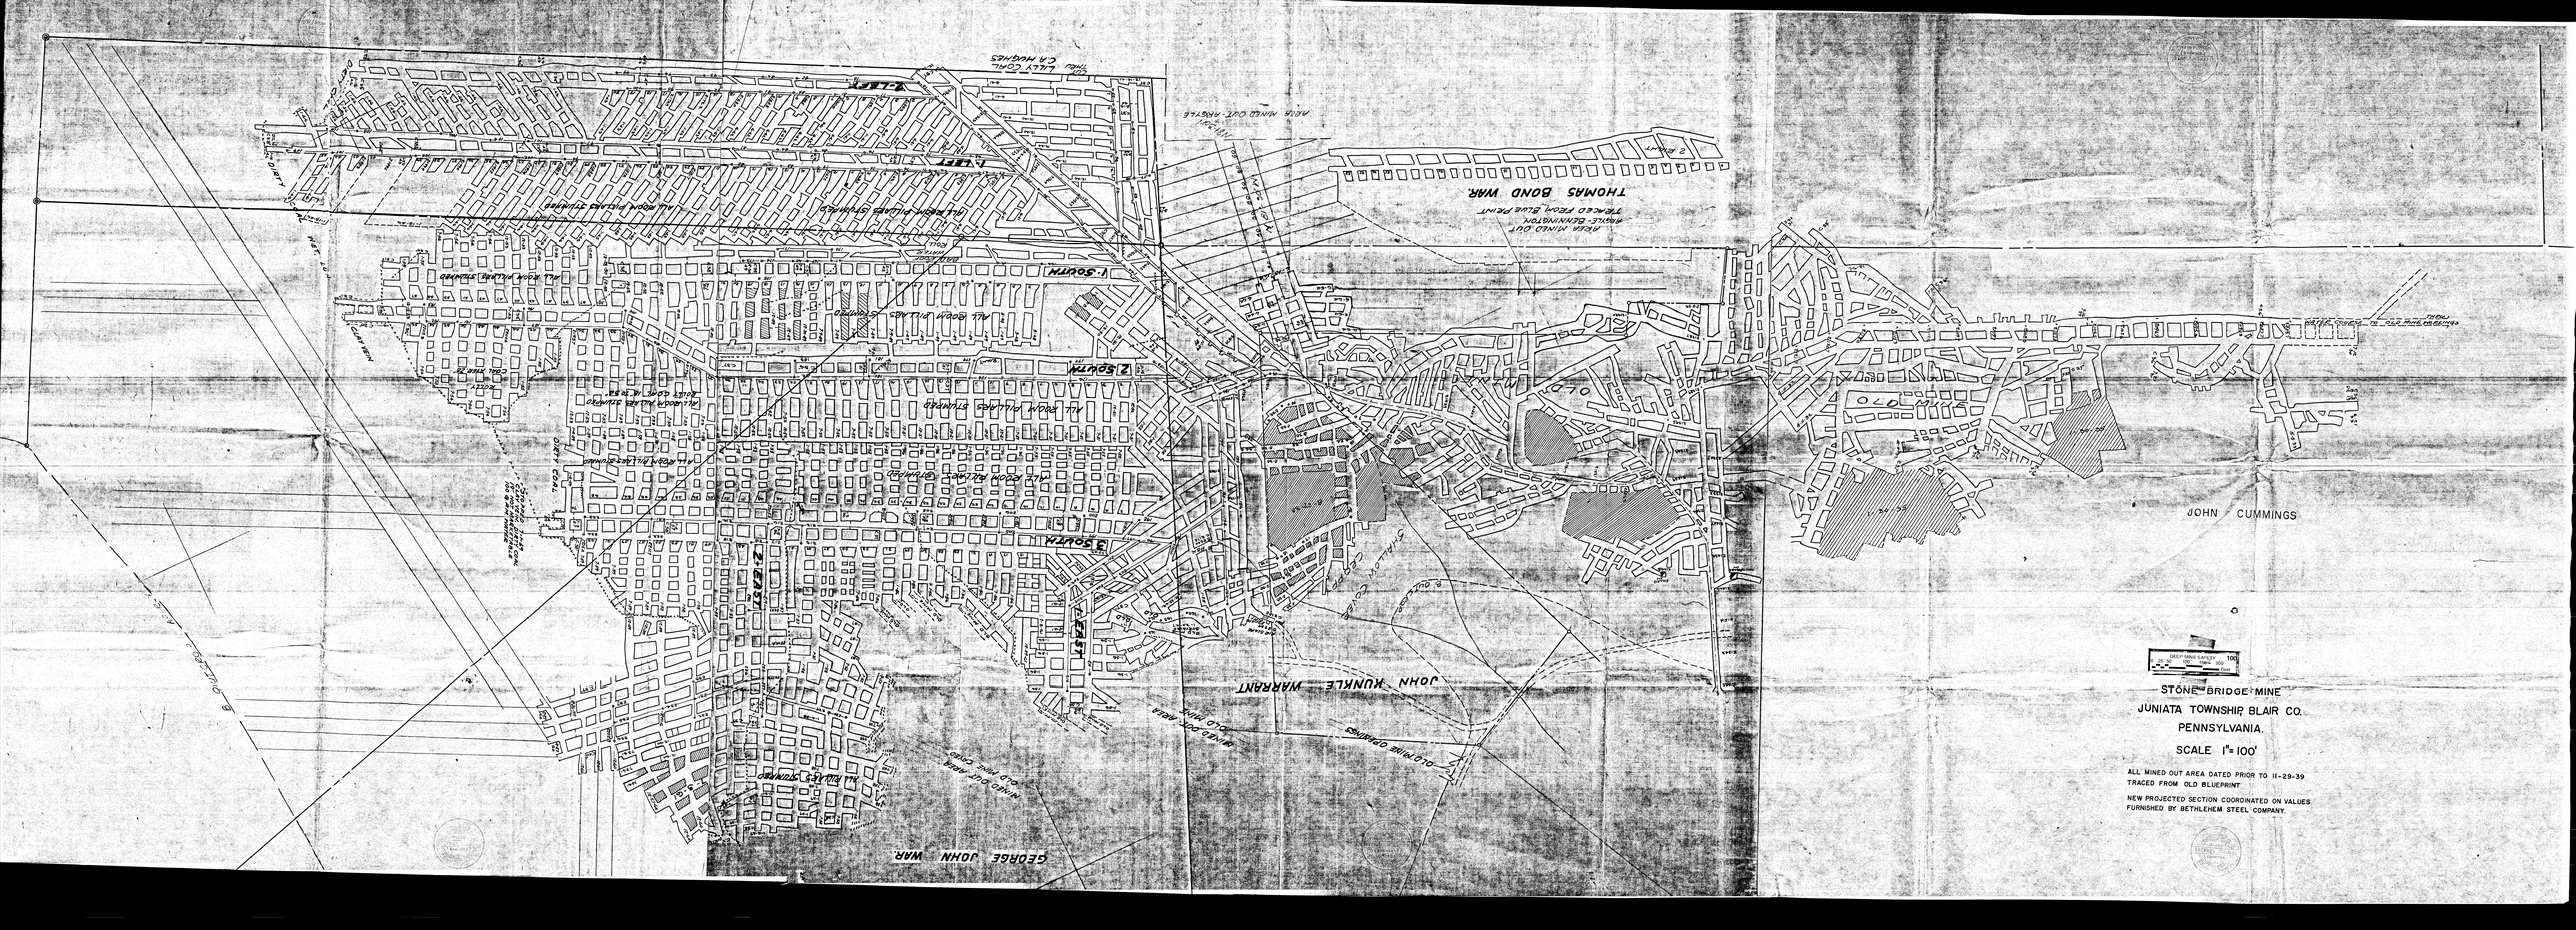
JOHN CUMMINGS
JOHN KUNKLE WARRANT
GEORGE JOHN WAR
THOMAS BOND WAR
1 SOUTH
2 SOUTH
3 SOUTH
1 EAST
2 EAST
