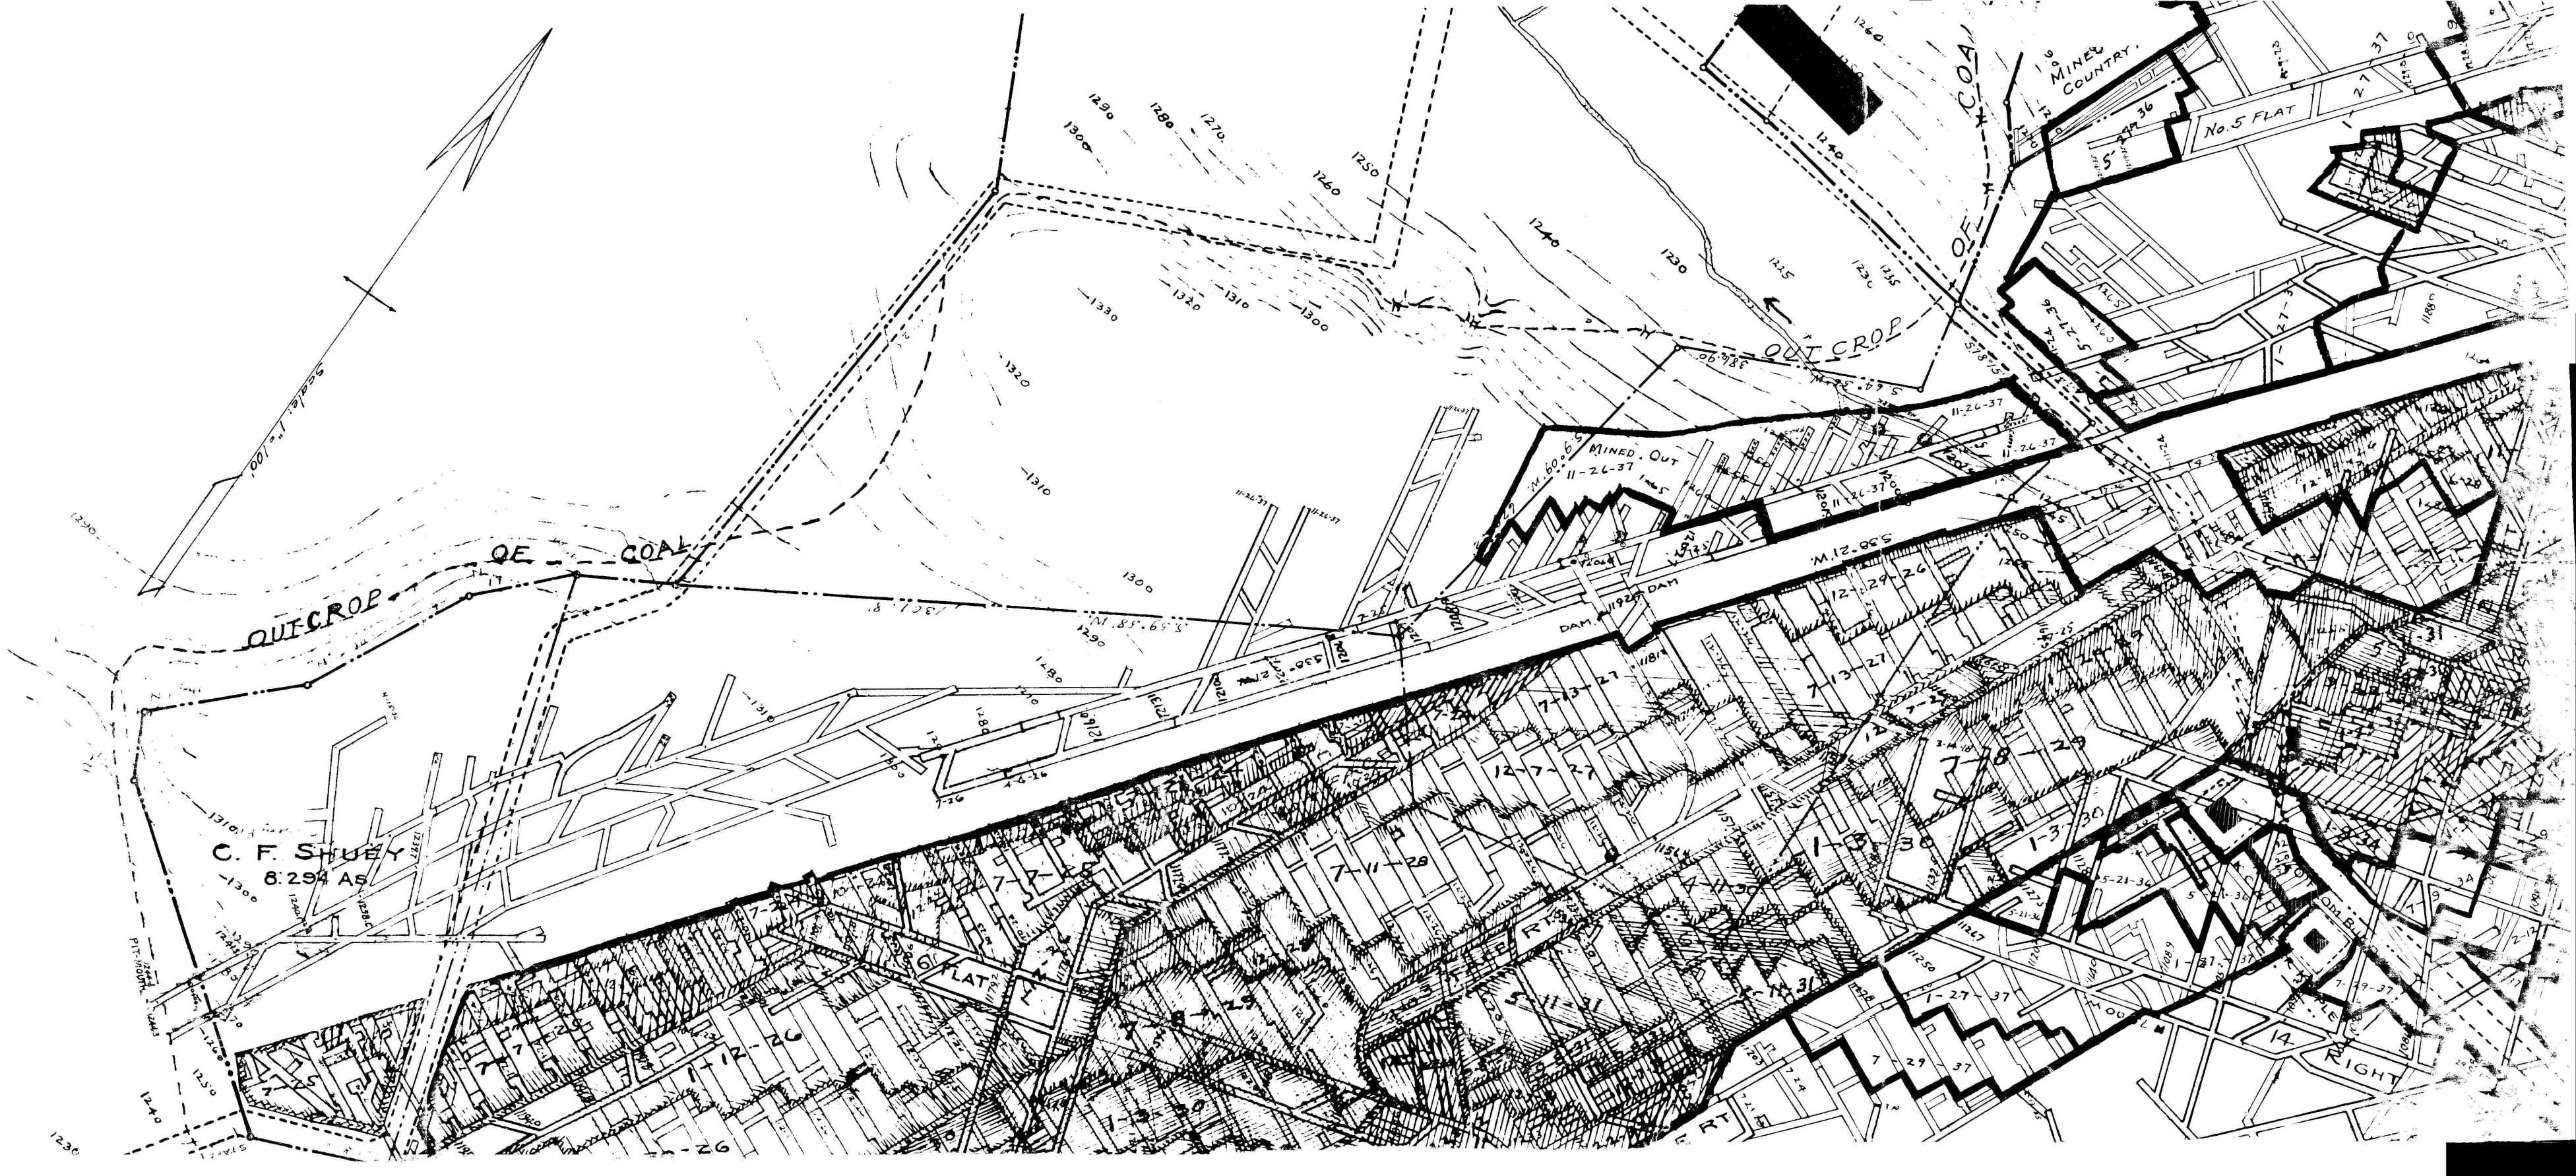
OUTCROP OF COAL
OUTCROP
MINED OUT 11-24-37
No. 5 FLAT
No. 6 FLAT
C. F. SHUEY
8.294 As
DAM
RIGHT