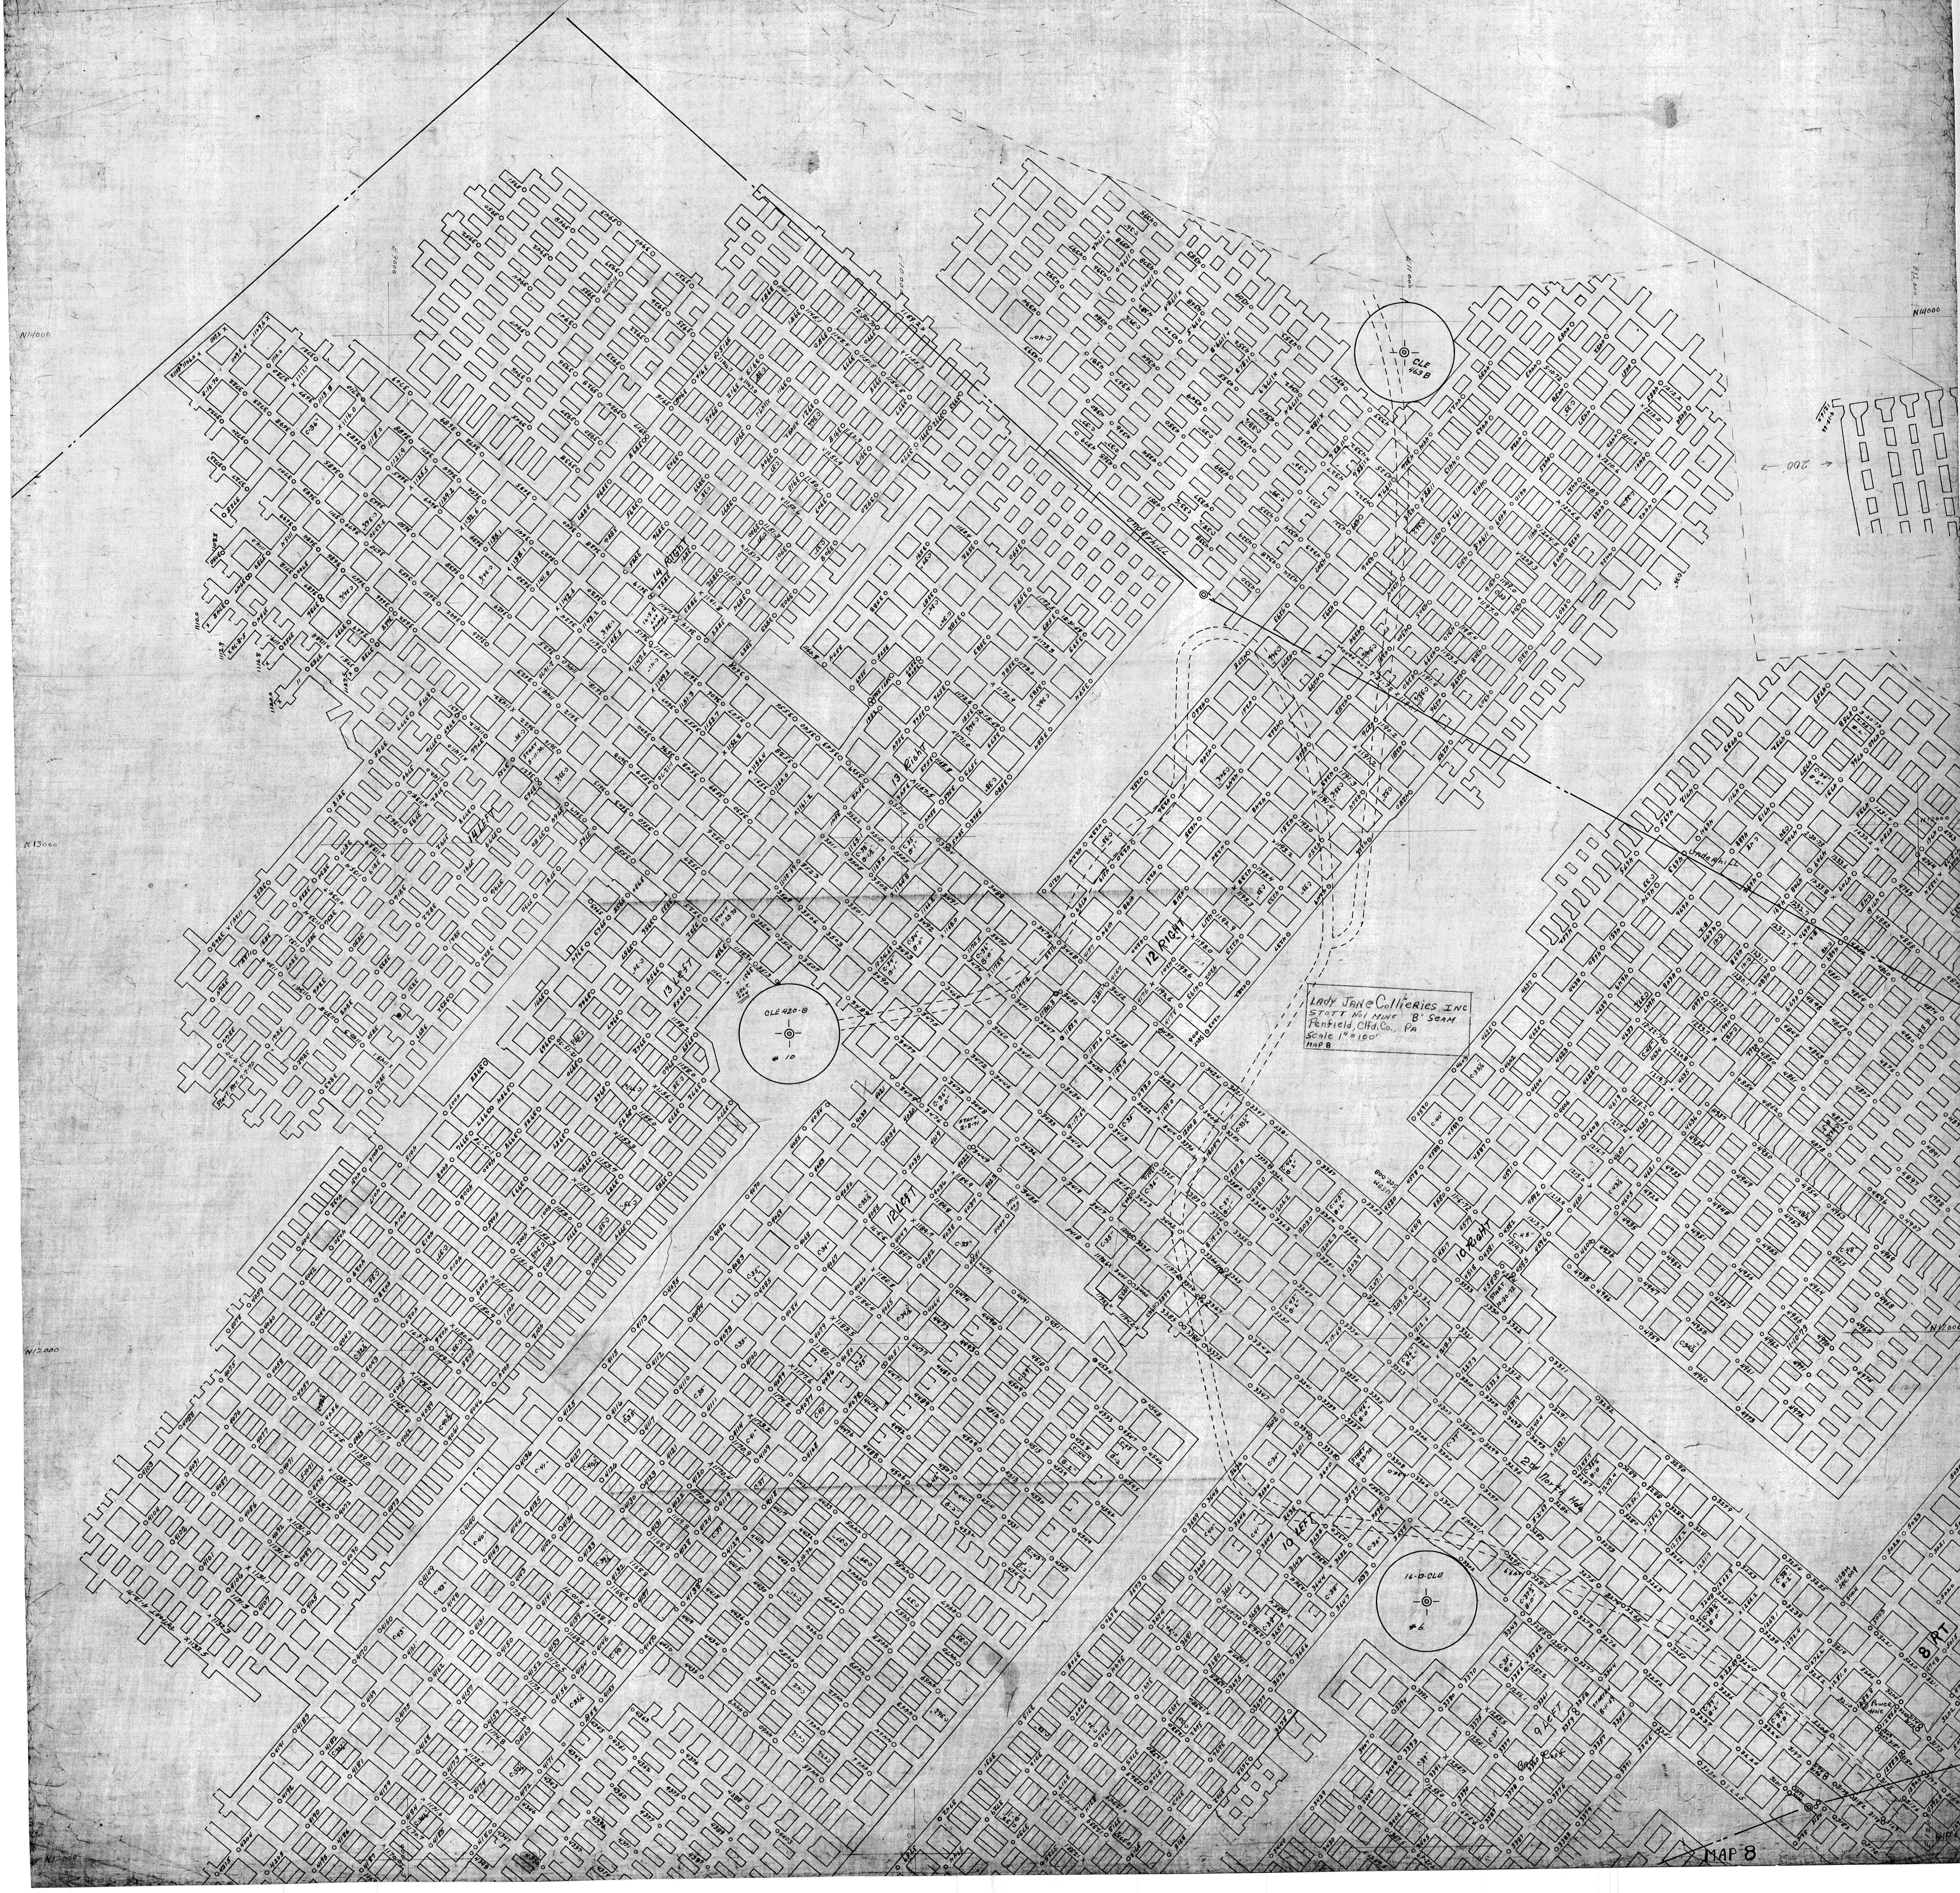

Lady Jane Collieries Inc
STOTT No1 Mine "B" Seam
Penfield, Clfd. Co. Pa
Scale 1" = 100'
MAP 8

N14000
E9000
E10000
E11000
E12000
N13000
N12000
14 Right
14 Left
13 Right
13 Left
12 Right
12 Left
10 Right
10 Left
9 Left
2nd North Hole
8 RT
CLE 463 B
CLE 420-B
#10
16-B-CLE
#6
Underhill
Moved out 7-21-72
200
Power Hole
Bad Roof
USBM Sec. 008
USBM Sec. 009
Start 7-7-70
Start 5-11-70
Start 11-23-70
Start 2-8-71
Start 2-23-70
Start 10-30-72
Started 8-11-69
Retreat 4-12-71
MAP 8