




FINAL MINE MAP

STANFORD
DOVERSPIKE BROS. COAL CO.
P.O. BOX 211 PUNXSUTAWNEY, PA 15767
PORTER, FWP, JEFFERSON CO.
SUGARCAMP No. 2
SCALE: 1" = 200'
EXHIBIT "B"

- LEGEND**
- PERMIT AREA
 - PROPERTY LINES
 - PROPERTY OWNERS
 - CONTIGUOUS PROPERTY OWNERS
 - PRE 1966 DWELLINGS
 - DWELLINGS
 - PUBLIC BUILDINGS
 - L.K. COAL CONTOURS
 - L.K. COAL OUTCROP
 - GAS LINE
 - GAS WELL
 - MAJOR ELECTRIC LINE
 - WATER WELL
 - SPRING
 - DRILL HOLE
 - EMPOUNDMENT
 - CEMETERY
 - MINE OPENINGS, NOT SEALED
 - MINE OPENINGS, SEALED
 - STREAMS

- SURVEY STATION
- SUPPORT AREA (No Second Mining)
- IMPOUNDED WATER (In Mine)
- CONTEMPLATED MINE 2/15/93 TO 2/15/94
- 6 MONTH PROJECTIONS
- GAS WELL BARRIER (No Mining Within Barrier Unless Approved)
- PILLARS REMOVED

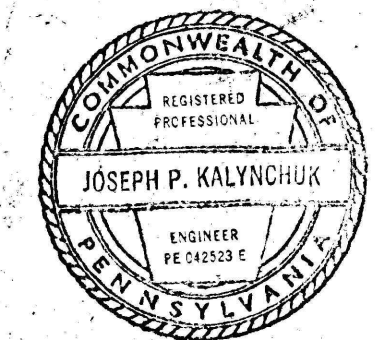

Joseph P. Kalynchuk
5-4-93

DOVERSPIKE BROS. COAL CO.
SUGARCAMP No. 2 MINE
SCALE: 1" = 200'
DATE: _____
 INTAKE AIR
 RETURN AIR
 PRIMARY ESCAPEWAY
 SECONDARY ESCAPEWAY
 BELT LINE
 B-E POINTS (Approved)
 B-E POINTS (Proposed)
 STOPPING
 STOPPING W/ DOOR
 CHECK CURTAIN
 REGULATOR
 DOUBLE DOORS (Equip. doors)
 OVERCAST
 REGULATING OR RUN-THROUGH CHECK
 Survey is closed loop, Accuracy is 1:10000
 Individuals responsible for information:
 Mark Pansy, Engineer & Larry Smith, Superintendent