

N 284,000

N 283,000

N 282,000

N 281,000

E 1,594,000

N 280,000

E 1,595,000

E 1,596,000

E 1,597,000

E 1,598,000

E 1,599,000

FINAL MINE MAP



STANFORD

DOVERSPIKE BROS. COAL CO.
R.D. 4 BOX 271 PUNXSUTAWNEY, PA 15767
PORTER TWP., JEFFERSON CO.

SUGARCAMP No. 2

SHEET 5 OF 16


SCALE: 1" = 200'

EXHIBIT "B"

LEGEND

- | | | |
|----------------------------|-----|---------------------------|
| PERMIT AREA | ✱ | GAS WELL |
| PROPERTY LINES | —E— | MAJOR ELECTRIC LINE |
| PROPERTY OWNERS | ○ | WATER WELL |
| CONTIGUOUS PROPERTY OWNERS | ○ | SPRING |
| PRE 1966 MINEINGS | ○ | DRILL HOLE |
| 12 MINEINGS | ○ | IMPOUNDMENT |
| 22 PUBLIC BUILDINGS | ○ | CEMETERY |
| 1000 L.K. COAL CONTOURS | ○ | MINE OPENINGS, NOT SEALED |
| L.K. COAL OUTCROP | ○ | MINE OPENINGS, SEALED |
| 6 GAS LINE | ○ | STREAMS |

- | | |
|-----|---|
| △12 | SURVEY STATION |
| □ | SUPPORT AREA (No Second Mining) |
| □ | IMPOUNDED WATER (In Mine) |
| --- | CONTINGUATED MINING 2/15/93 TO 2/15/94 |
| --- | 6 MONTH PRO |
| --- | GAS WELL BARRIER (No Mining Within Barrier Unless Approved) |

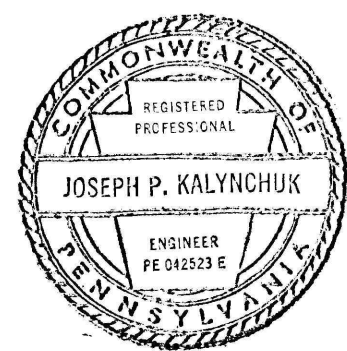

Joseph P. Kalynduk
5-4-93
SIGNATURE

DOVERSPIKE BROS. COAL CO.

SUGARCAMP No. 2 MINE

SCALE: 1" = 200'

DATE:

- | | | | |
|---|-----------------------|---|-----------------------------|
| → | INTAKE AIR | □ | STOPPING W/ DOOR |
| → | RETURN AIR | □ | CHECK CURTAIN |
| → | PRIMARY ESCAPEWAY | □ | REGULATOR |
| → | SECONDARY ESCAPEWAY | □ | DOUBLE DOORS (Equip. doors) |
| → | BELT LINE | □ | OVERCAST |
| △ | B-E POINTS (Approved) | | |
| △ | B-E POINTS (Proposed) | | |
| → | STOPPING | | |
- Survey is closed loop, Accuracy is 1:10000
Individuals responsible for information:
Mark Penny, Engineer & Larry Smith, Superintendent