


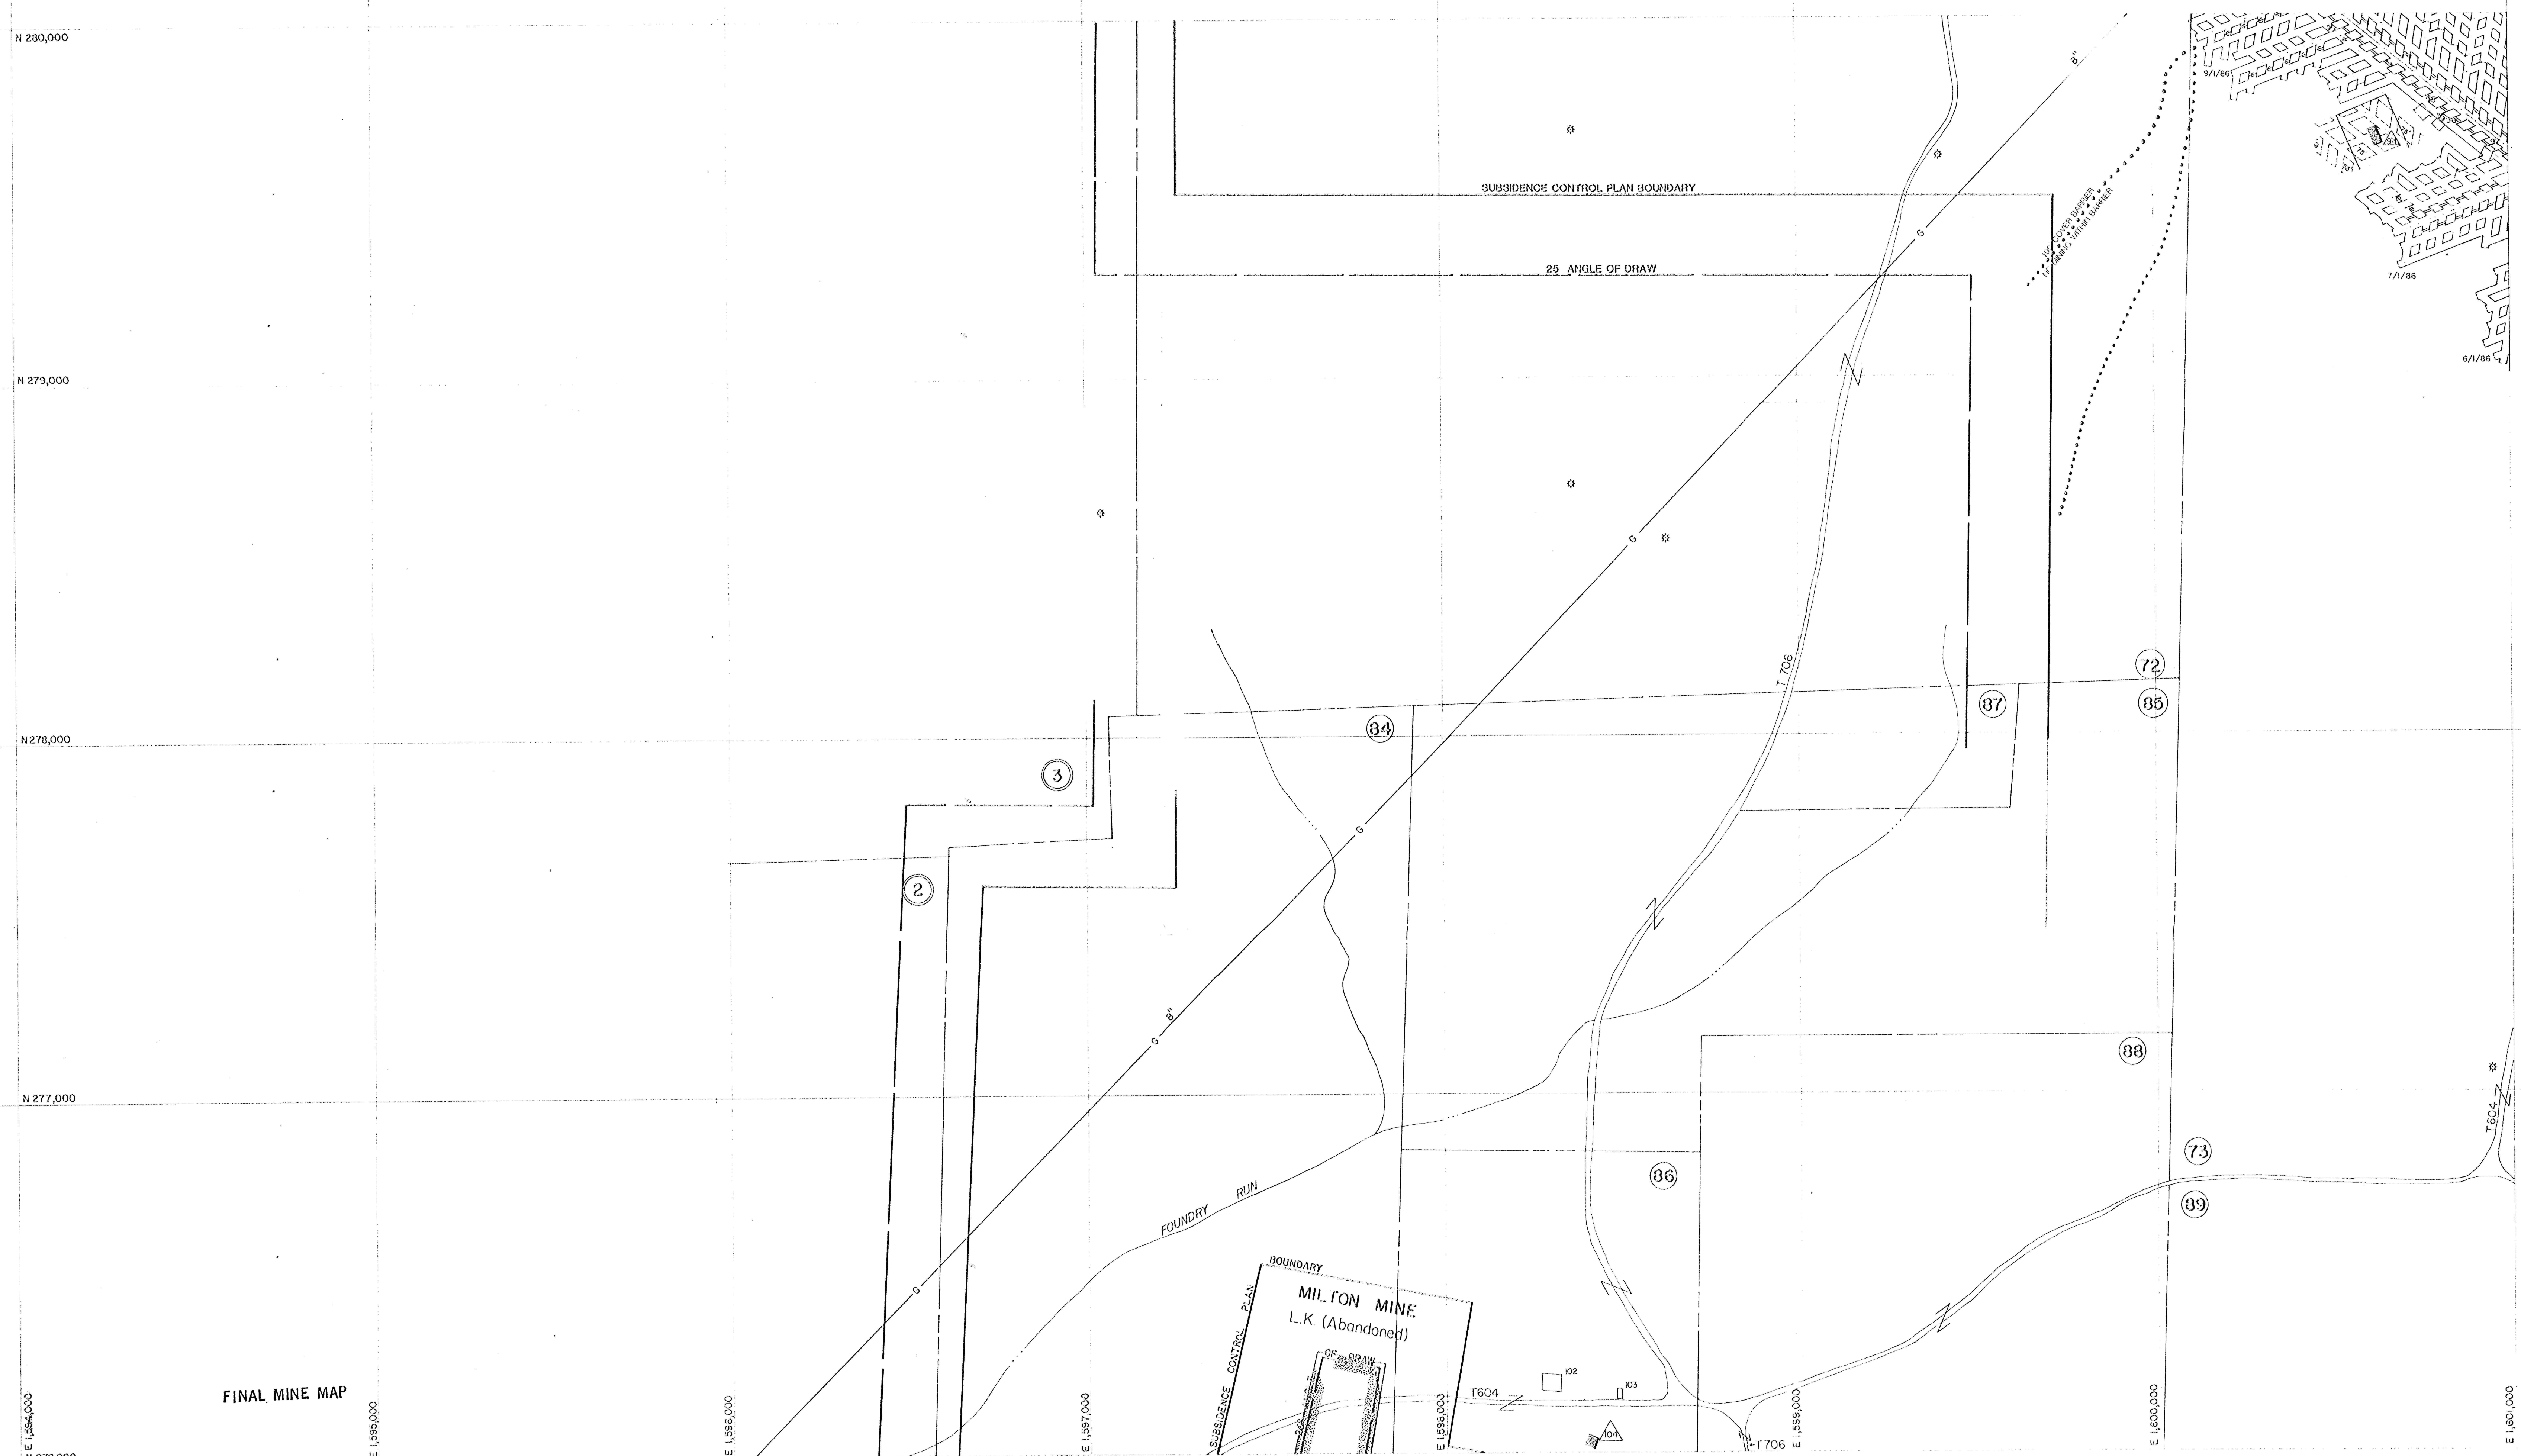

FINAL MINE MAP

**STANFORD**  
PORTER TWP., JEFFERSON CO.  
Doverspike Bros. Coal Co.  
R.D. 4 Box 271 Piquette, PA 15767

**SUGARCAMP No. 2**

SHEET No. 9 OF 16 SCALE 1" = 200'

**EXHIBIT "B"**

**LEGEND**

Permit Area  
Underground Workings  
Township Boundary  
County Boundary  
Test Borehole  
Crop Lines  
Surface Workings  
Mine Openings, Not Sealed  
Mine Openings, Sealed  
Property Lines  
Pre 1966 Dwellings  
Water Monitoring Point  
Background Sample  
Dora #6 Mine  
Major Linear

Post 1966 Dwellings  
Cemeteries  
Structures  
Major Electric Lines  
Pipelines  
Gas Wells  
Water Wells  
Streams  
Lakes or Ponds  
Water Treatment Facilities  
Contiguous Property  
Coal Contours  
Spring  
Minor Linear


**LEGEND continued**

Water  
6 Month Projections  
Support Area  
Contemplated Mining  
Survey Station  
GAS WELL BARRIER

2115193 TO 2115194  
(No Mining Within Barrier Unless Approved)

**COMMONWEALTH OF PENNSYLVANIA**  
REGISTERED PROFESSIONAL ENGINEER  
JOSEPH P. KALYNCHUK  
No. 042537 E

*Joseph P. Kalynchuk*  
5-4-83

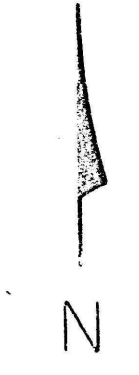

**DOVERSPIKE BROS. COAL CO.**  
SUGARCAMP No. 2 MINE  
SCALE: 1"=200'

DATE: \_\_\_\_\_

|                       |                            |
|-----------------------|----------------------------|
| INTAKE AIR            | STOPPING W/ DOOR           |
| RETURN AIR            | CHECK CURTAIN              |
| PRIMARY ESCAPEWAY     | REGULATOR                  |
| SECONDARY ESCAPEWAY   | DOUBLE DOORS(Equip. doors) |
| BELT LINE             | OVERCAST                   |
| B-E POINTS (Approved) |                            |
| B-E POINTS (Proposed) |                            |
| STOPPING              |                            |

Survey is closed loop, Accuracy is 1:10000  
Individuals responsible for information:  
Mark Pennsy, Engineer & Larry Smith, Superintendent