


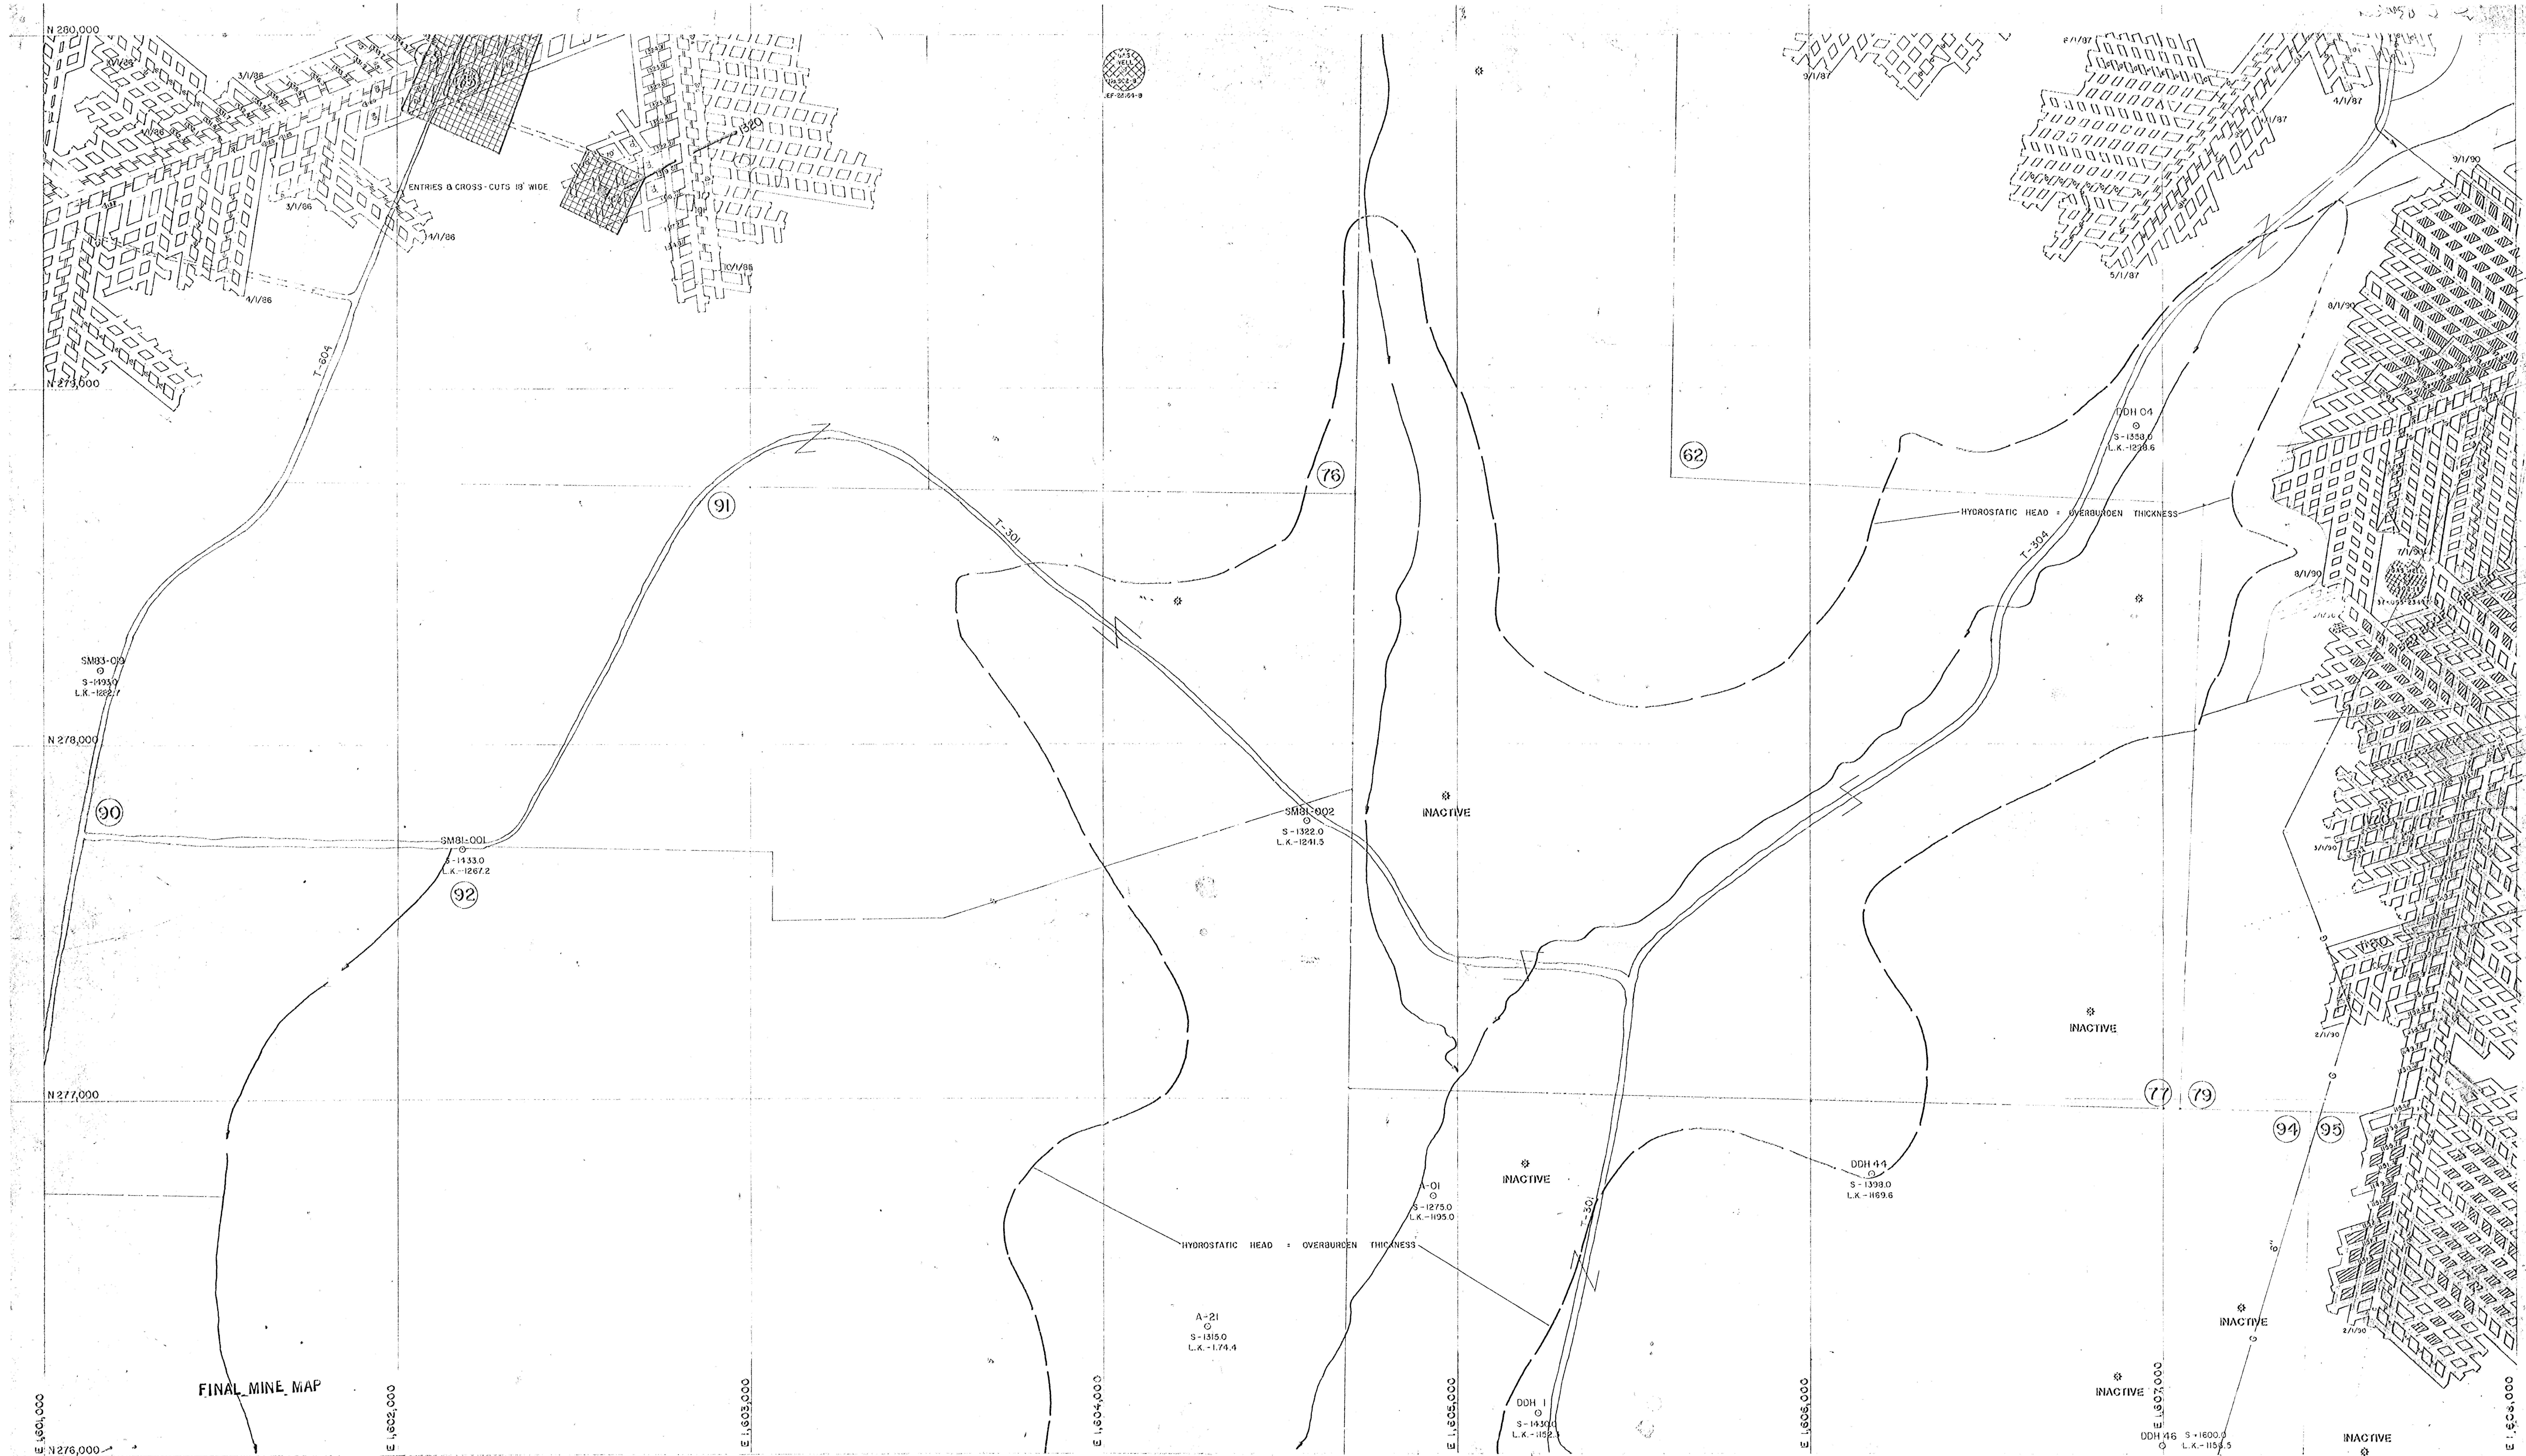

STANFORD
PORTER TWP., JEFFERSON CO.
Doverpike Bros. Coal Co.
Box 211, Piquette, PA 15781
SUGARCAMP No. 2
SHEET No. 19 of 18 SCALE 1" = 200'
EXHIBIT B

LEGEND

Permit Area	Post 1966 Dwellings
Underground Workings	Cemeteries
Township Boundary	Structures
County Boundary	Major Electric Lines
Test Borehole	Pipelines
Crop Lines	Gas Wells
Surface Workings	Water Wells
Mine Openings, Not Sealed	Lakes or Ponds
Mine Openings, Sealed	Water Treatment Facilities
Property Lines	Contiguous Property
Pre 1966 Dwellings	Coal Contours
Water Monitoring Point	Spring
Background Sample	Minor Lines
Dora #6 Mine	
Major Linear	

LEGEND continued

Water	No Scale
6 Month Projections	2/15/93 TO 2/15/94
Support Area	(No Mining within barrier unless approved)
Contemplated Mining	
Survey Station	
GAS WELL BARRIER	
PILLARS REMOVED	

JOSEPH P. KALYNCHUK
REGISTERED PROFESSIONAL ENGINEER
5-4-93

DOVERSPIKE BROS. COAL CO.
SUGARCAMP No. 2 MINE
SCALE: 1" = 200'

DATE:	INTAKE AIR	STOPPING W/ DOOR
	RETURN AIR	CHECK CURTAIN
	PRIMARY ESCAPEWAY	REGULATOR
	SECONDARY ESCAPEWAY	DOUBLE DOORS (Equip. doors)
	BELT LINE	OVERCAST
	B-E POINTS (Approved)	
	B-E POINTS (Proposed)	
	STOPPING	

Survey is closed loop. Accuracy is 1:10000.
Individuals responsible for information:
Mark Pagny, Engineer & Larry Smith, Superintendent