


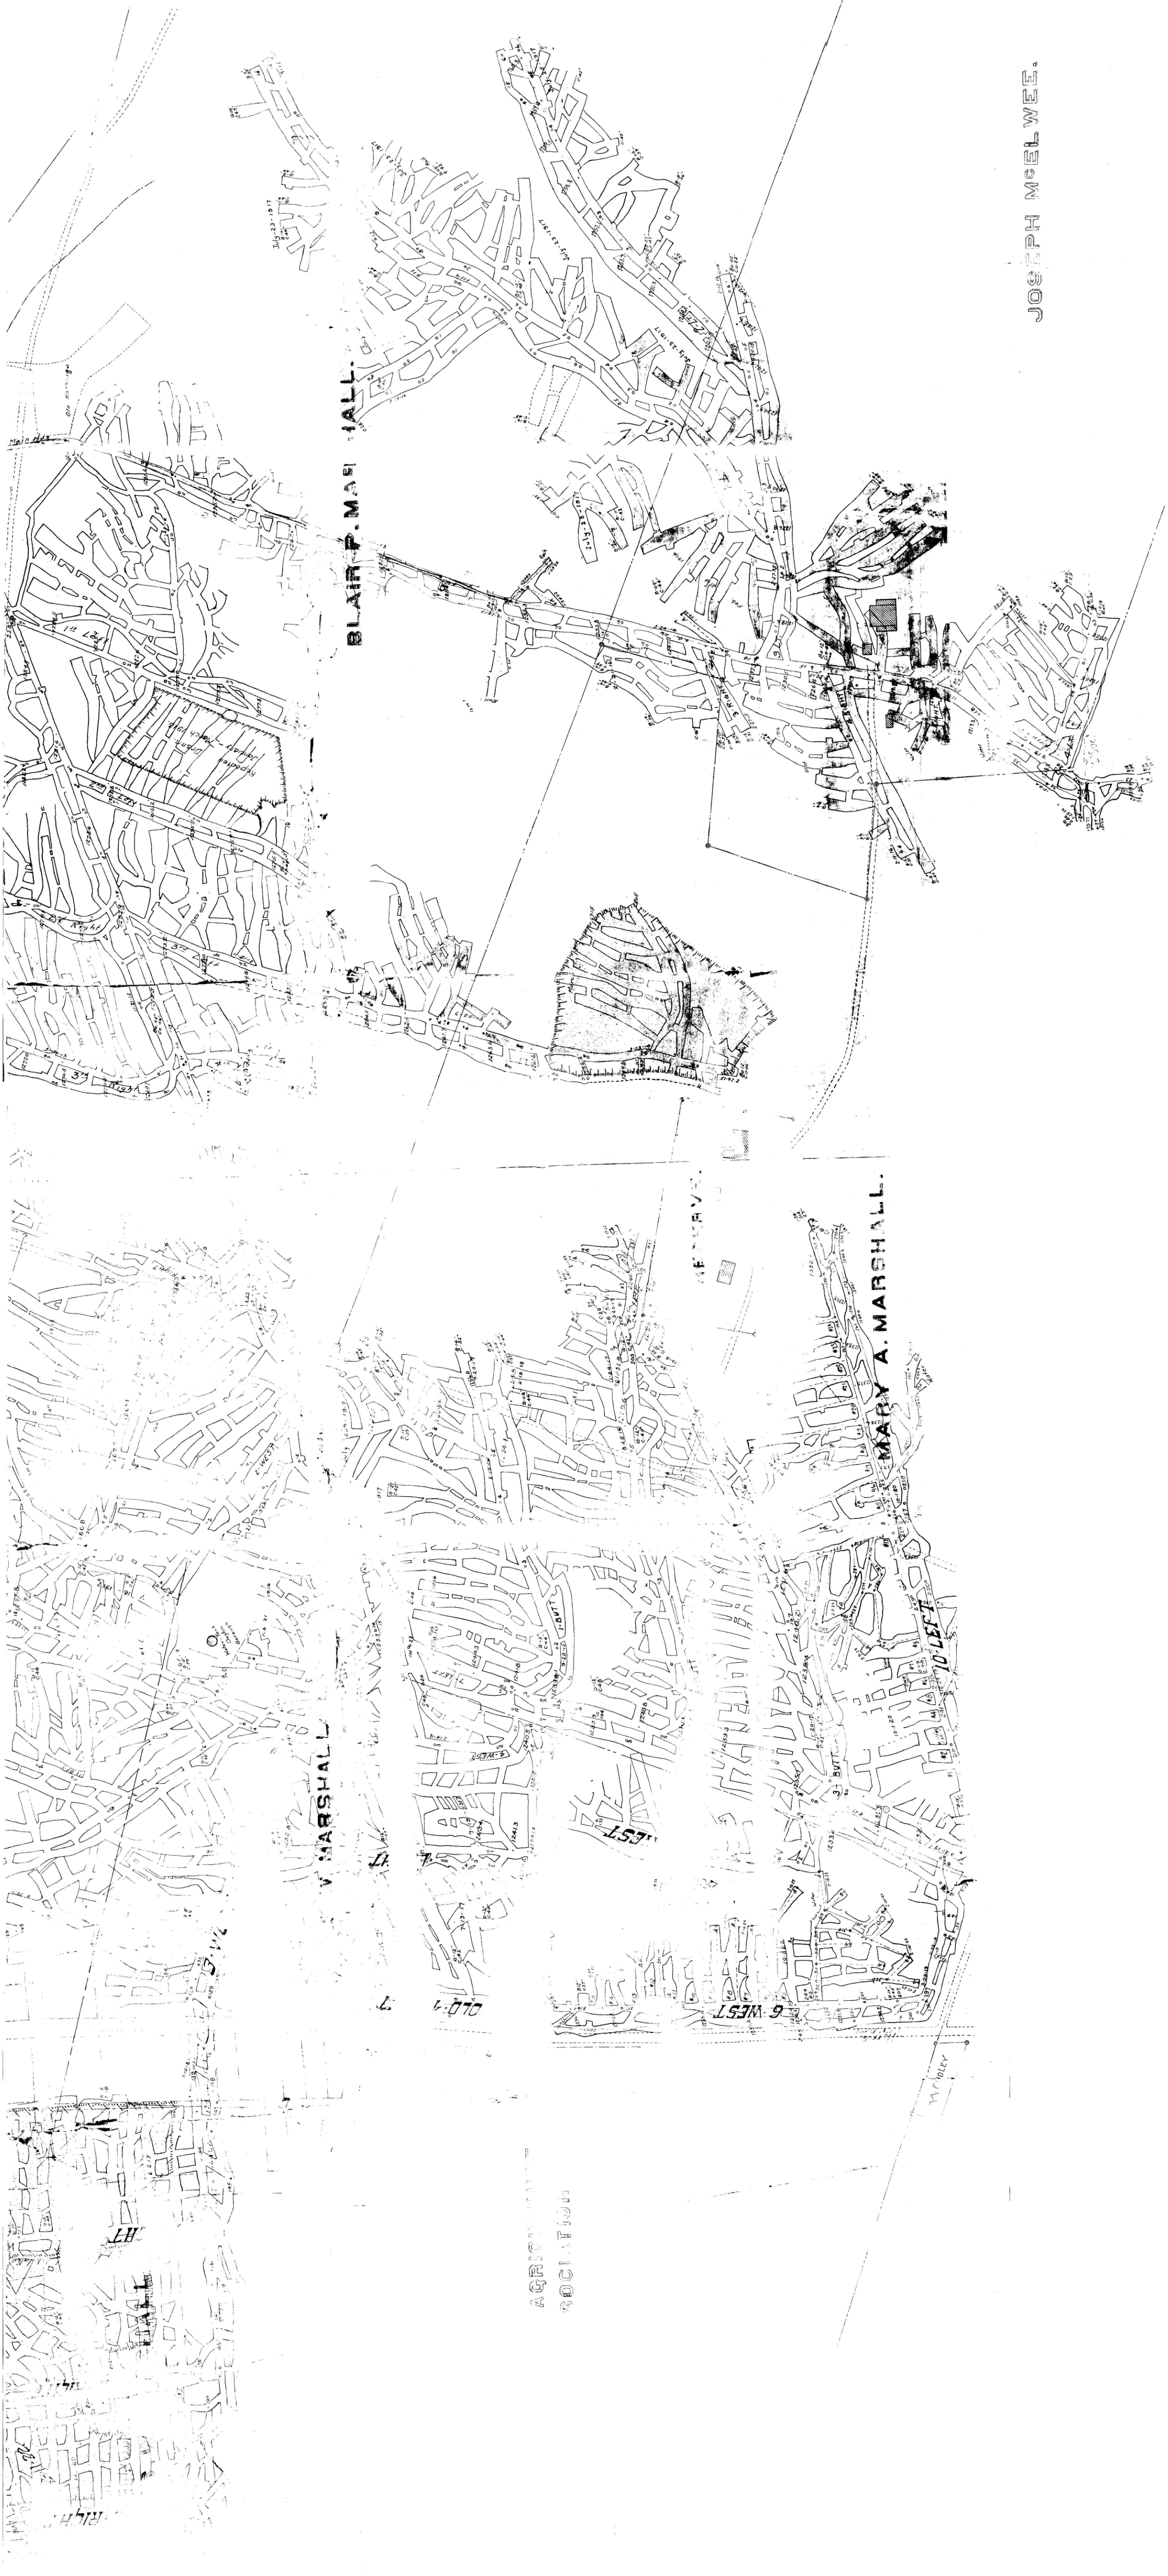

JOSEPH McELWEE.