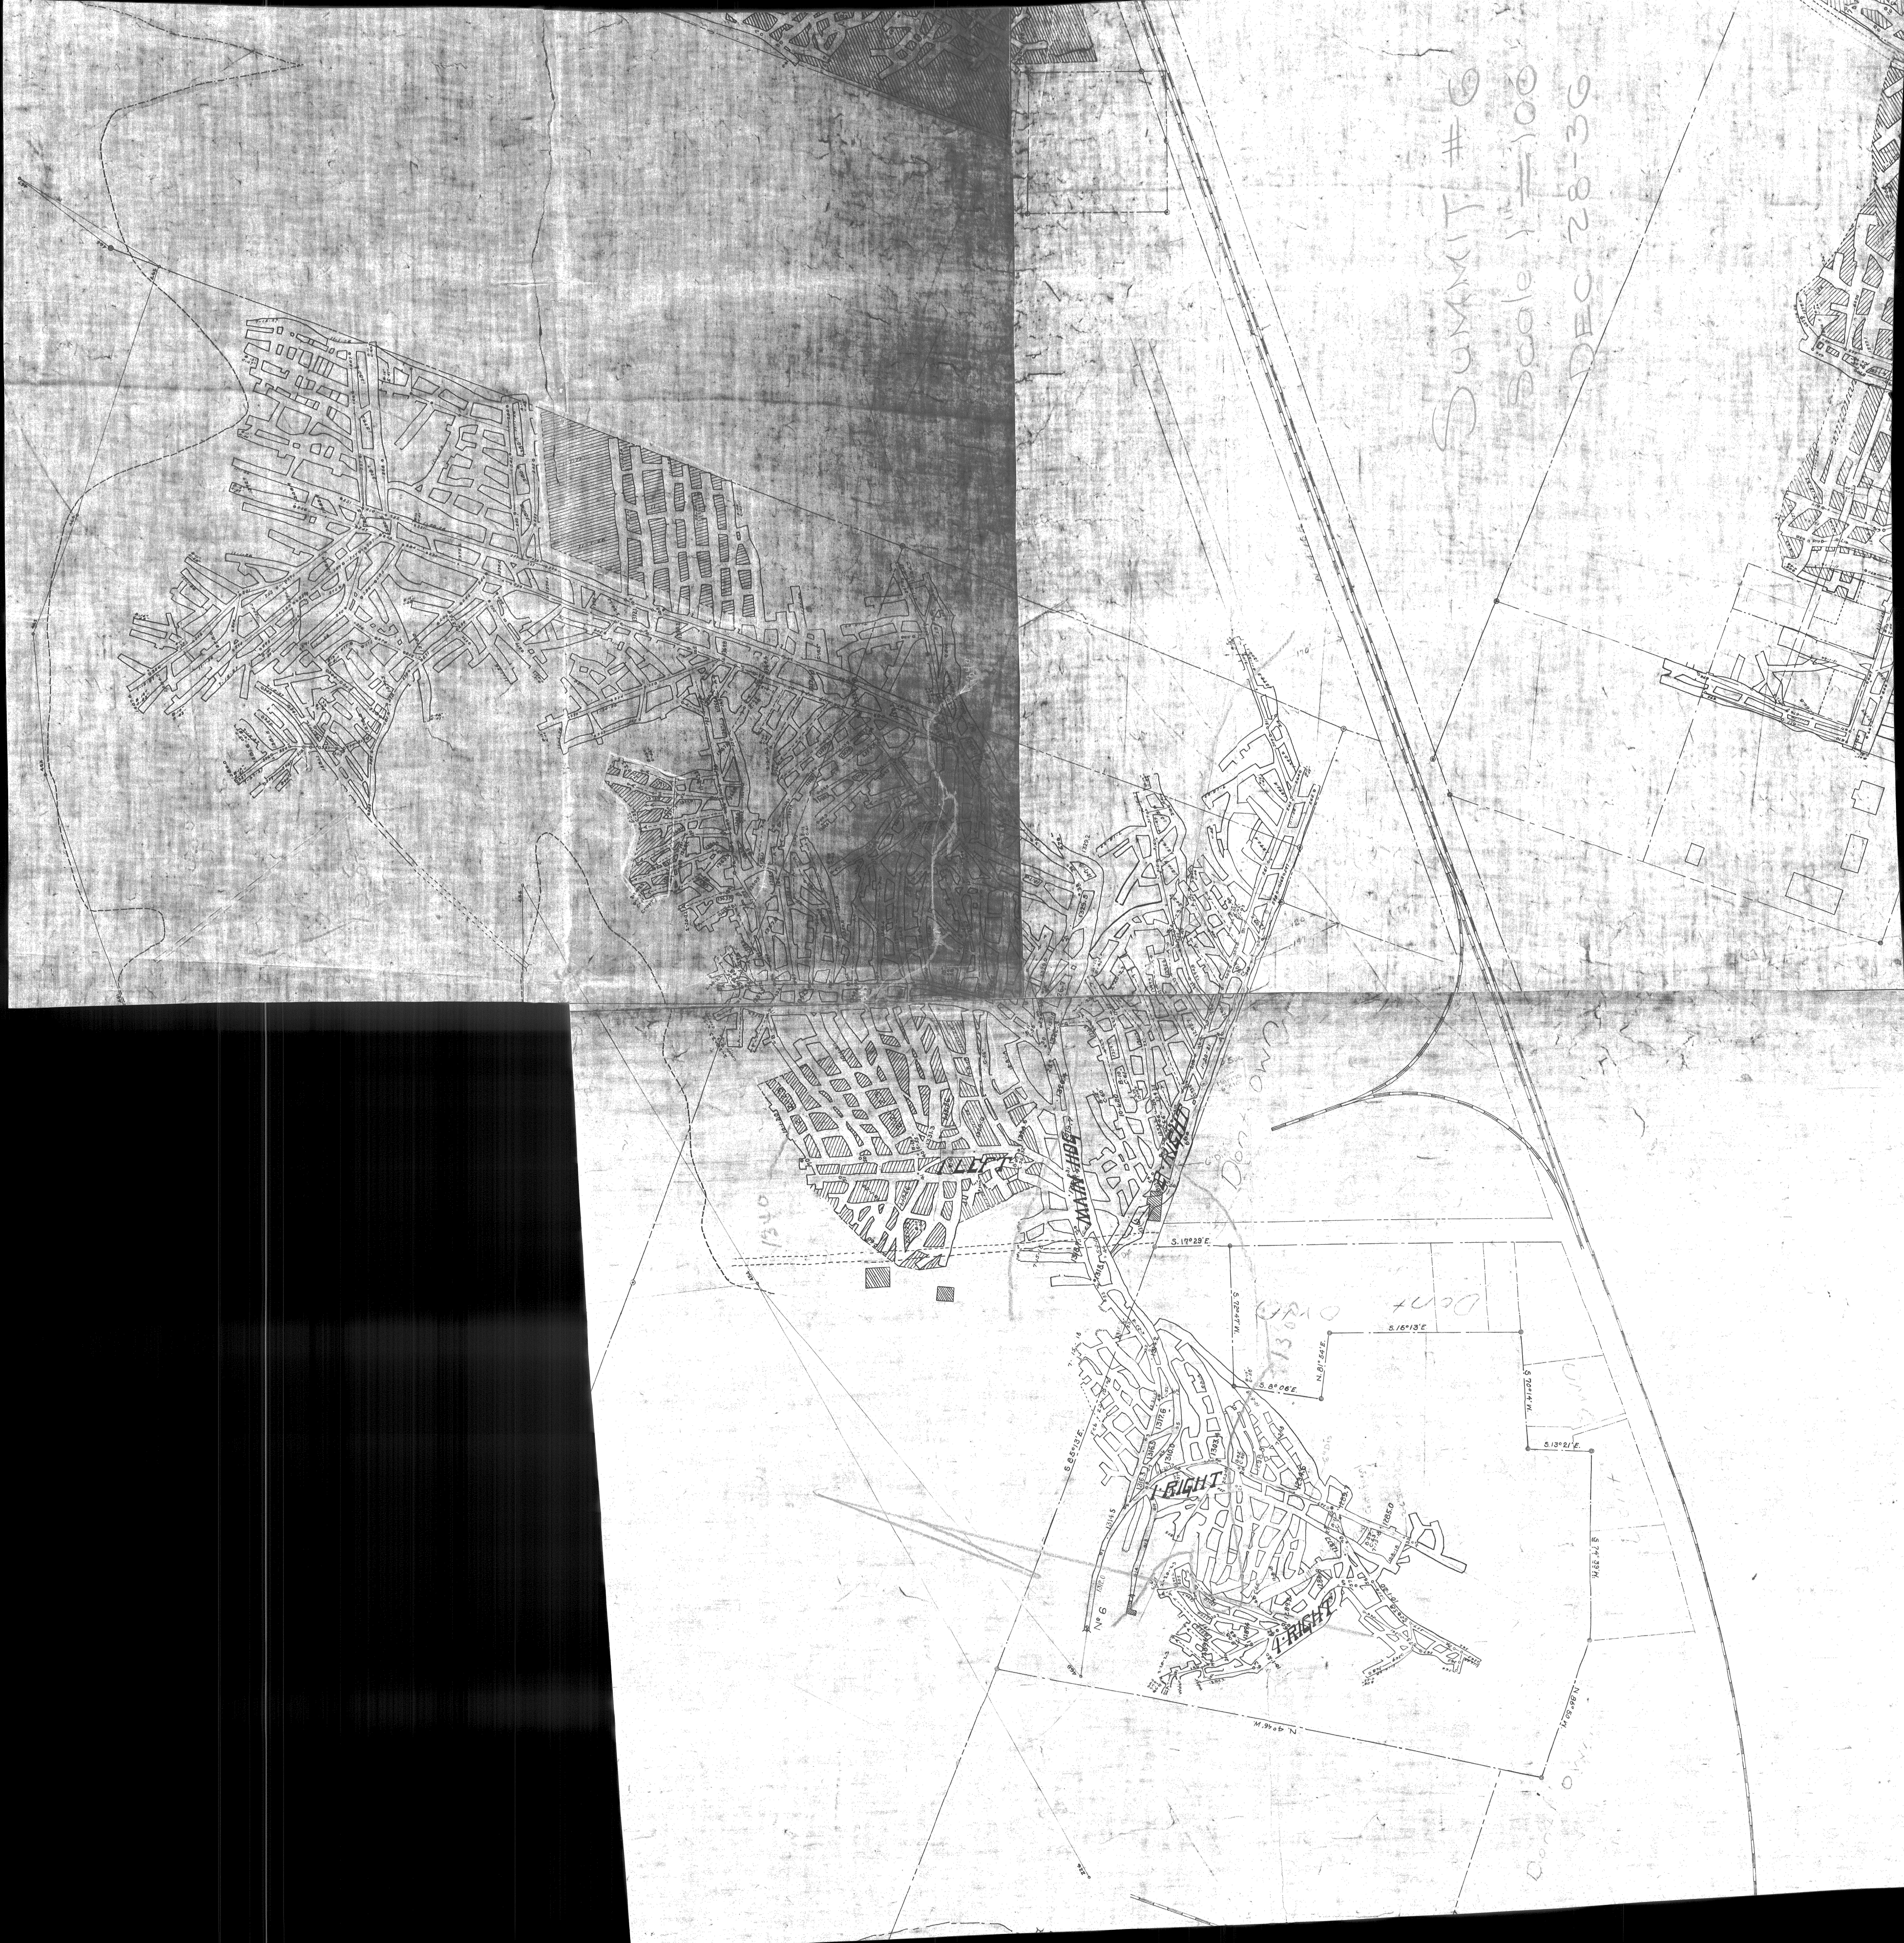
SUMMIT #6
Scale 1"=100'
DEC 28-36
1 LEFT
MAIN HDG
2 RIGHT
1 RIGHT
4 RIGHT
No 6
1340
1360
Don't own
Don't own
Don't own
170'
S.17°29'E.
S.72°47'W.
S.16°13'E.
N.81°54'E.
S.8°06'E.
S.70°14'W.
S.13°21'E.
S.74°33'W.
N.86°50'W.
N.40°46'W.
S.85°13'E.
1318.1
1317.6
1316.5
1316.3
1314.5
1312.0
1310.0
1303.4
1285.0
1289.5
1289.8