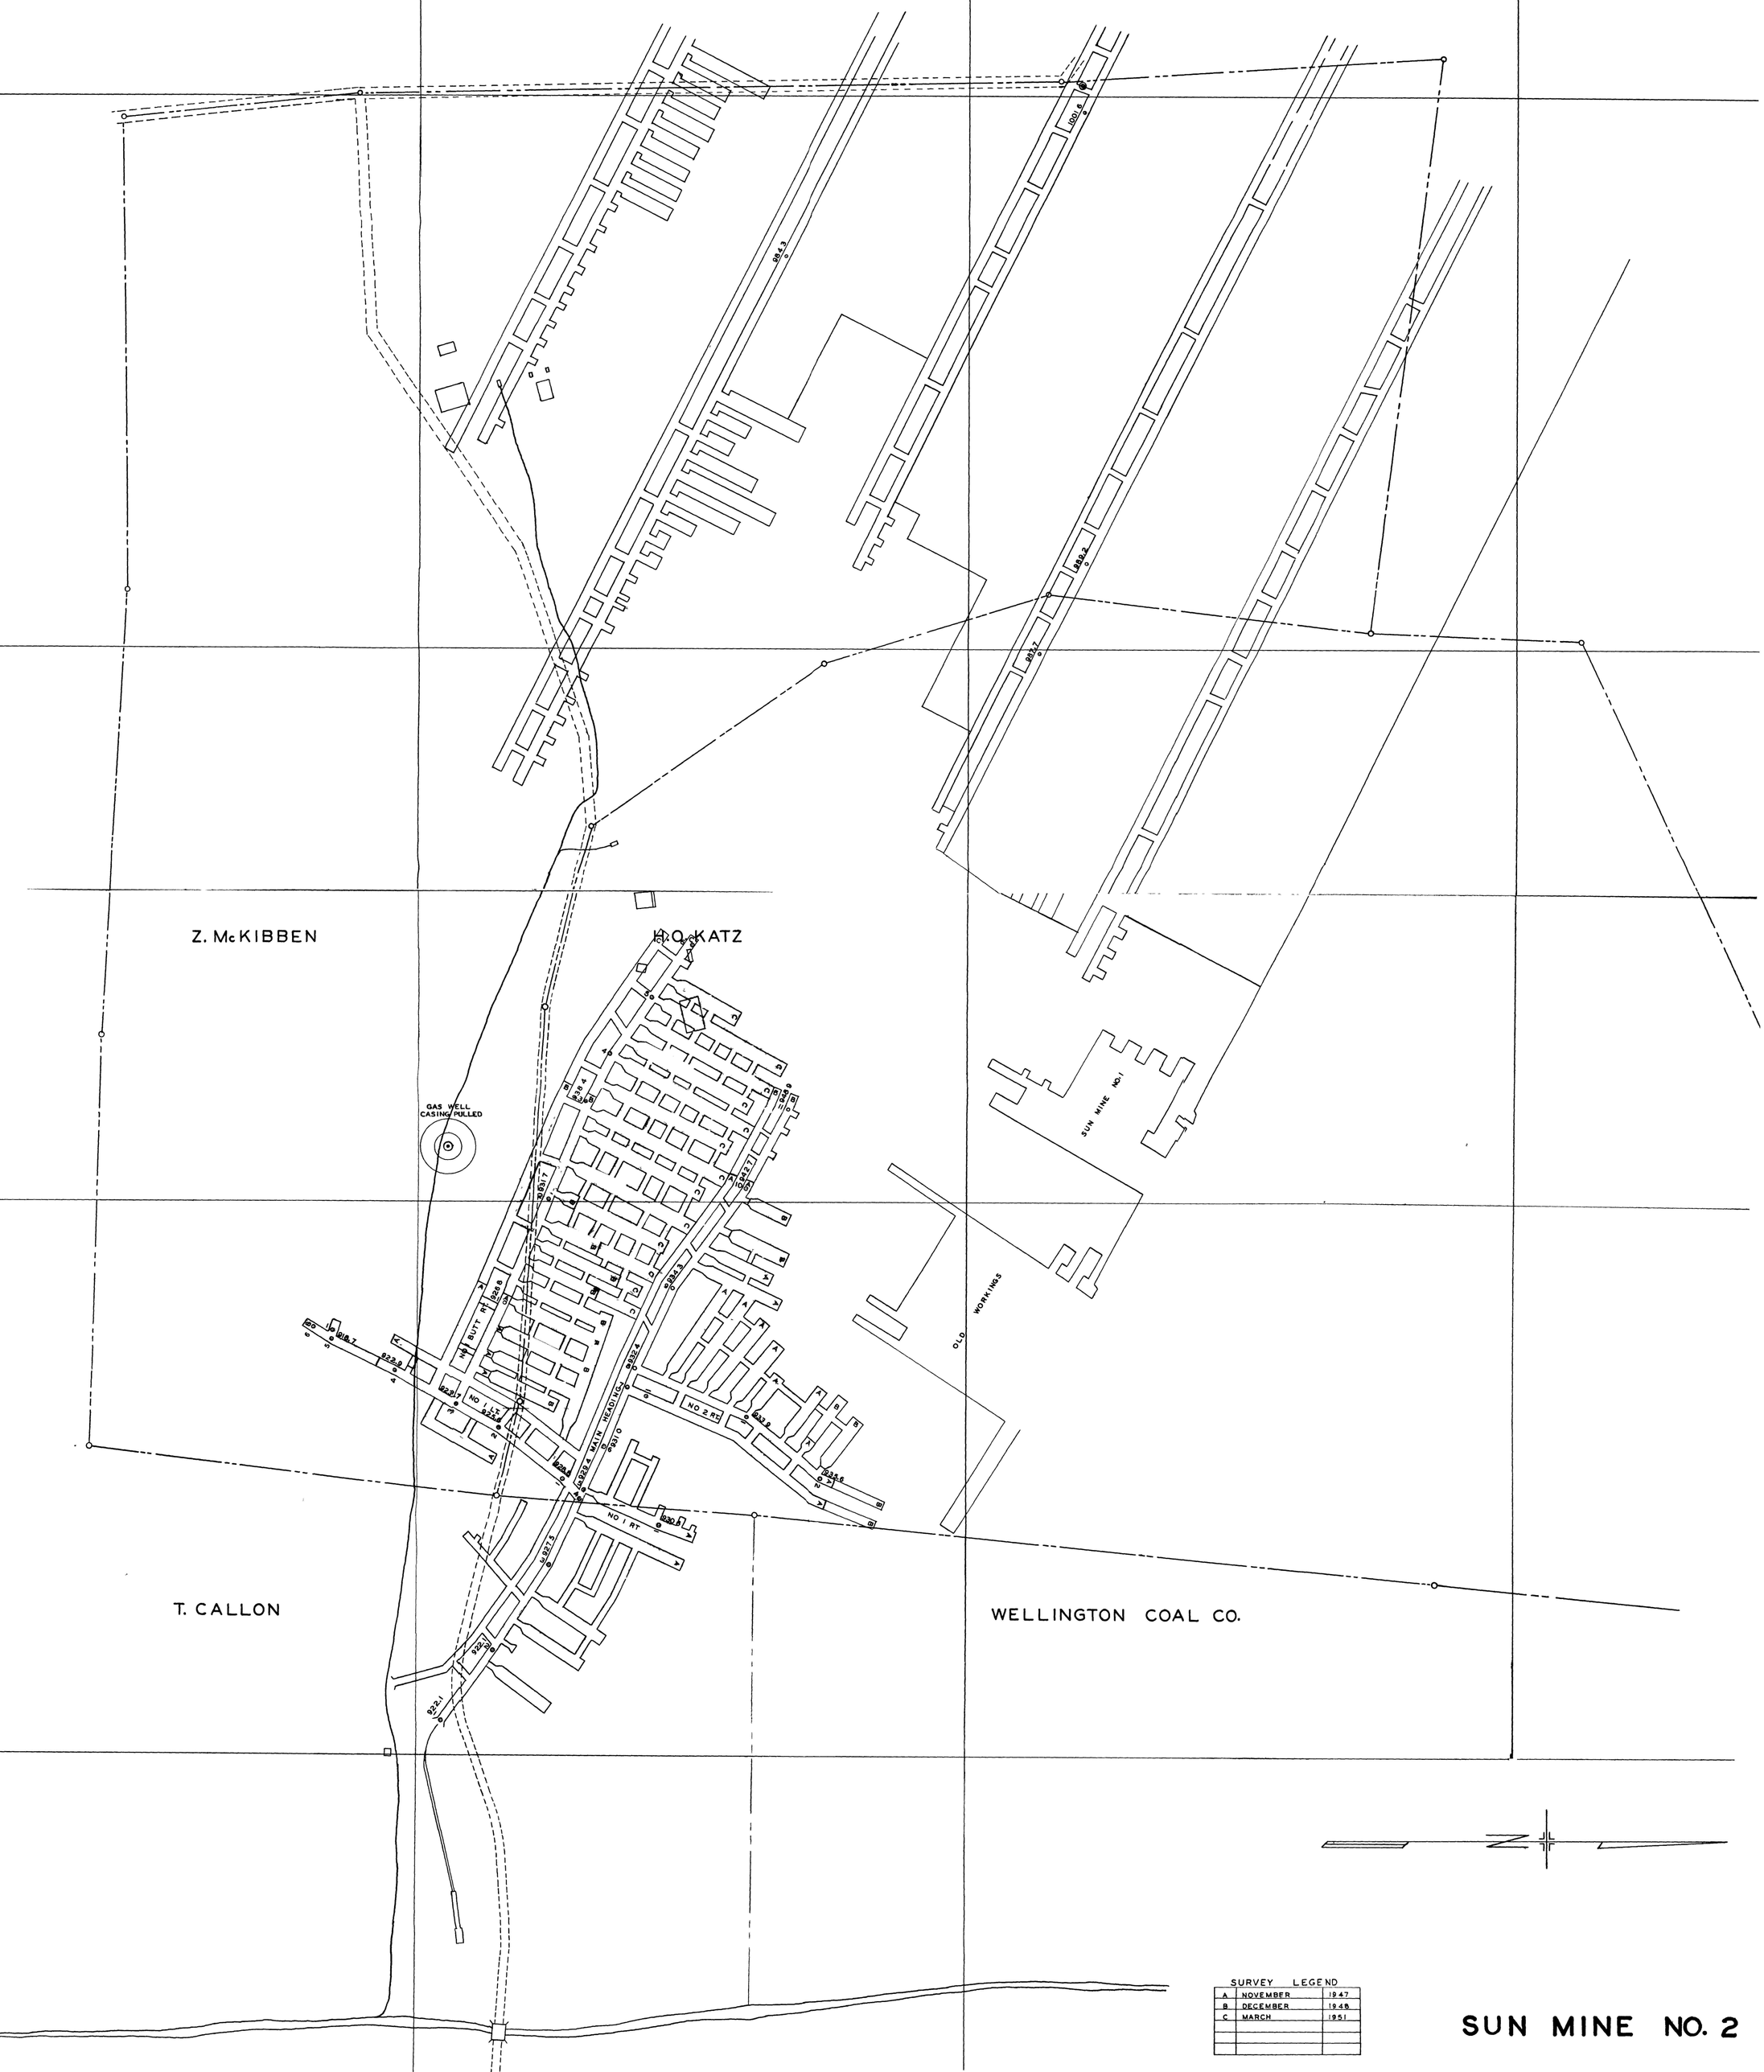
Z. McKIBBEN
R.O. KATZ
T. CALLON
WELLINGTON COAL CO.
GAS WELL CASING PULLED
SUN MINE NO. 1
OLD WORKINGS
NO 1 BUTT RT
NO 1 RT
NO 2 RT
MAIN HEADING
N
SURVEY LEGEND
A NOVEMBER 1947
B DECEMBER 1948
C MARCH 1951
SUN MINE NO. 2