


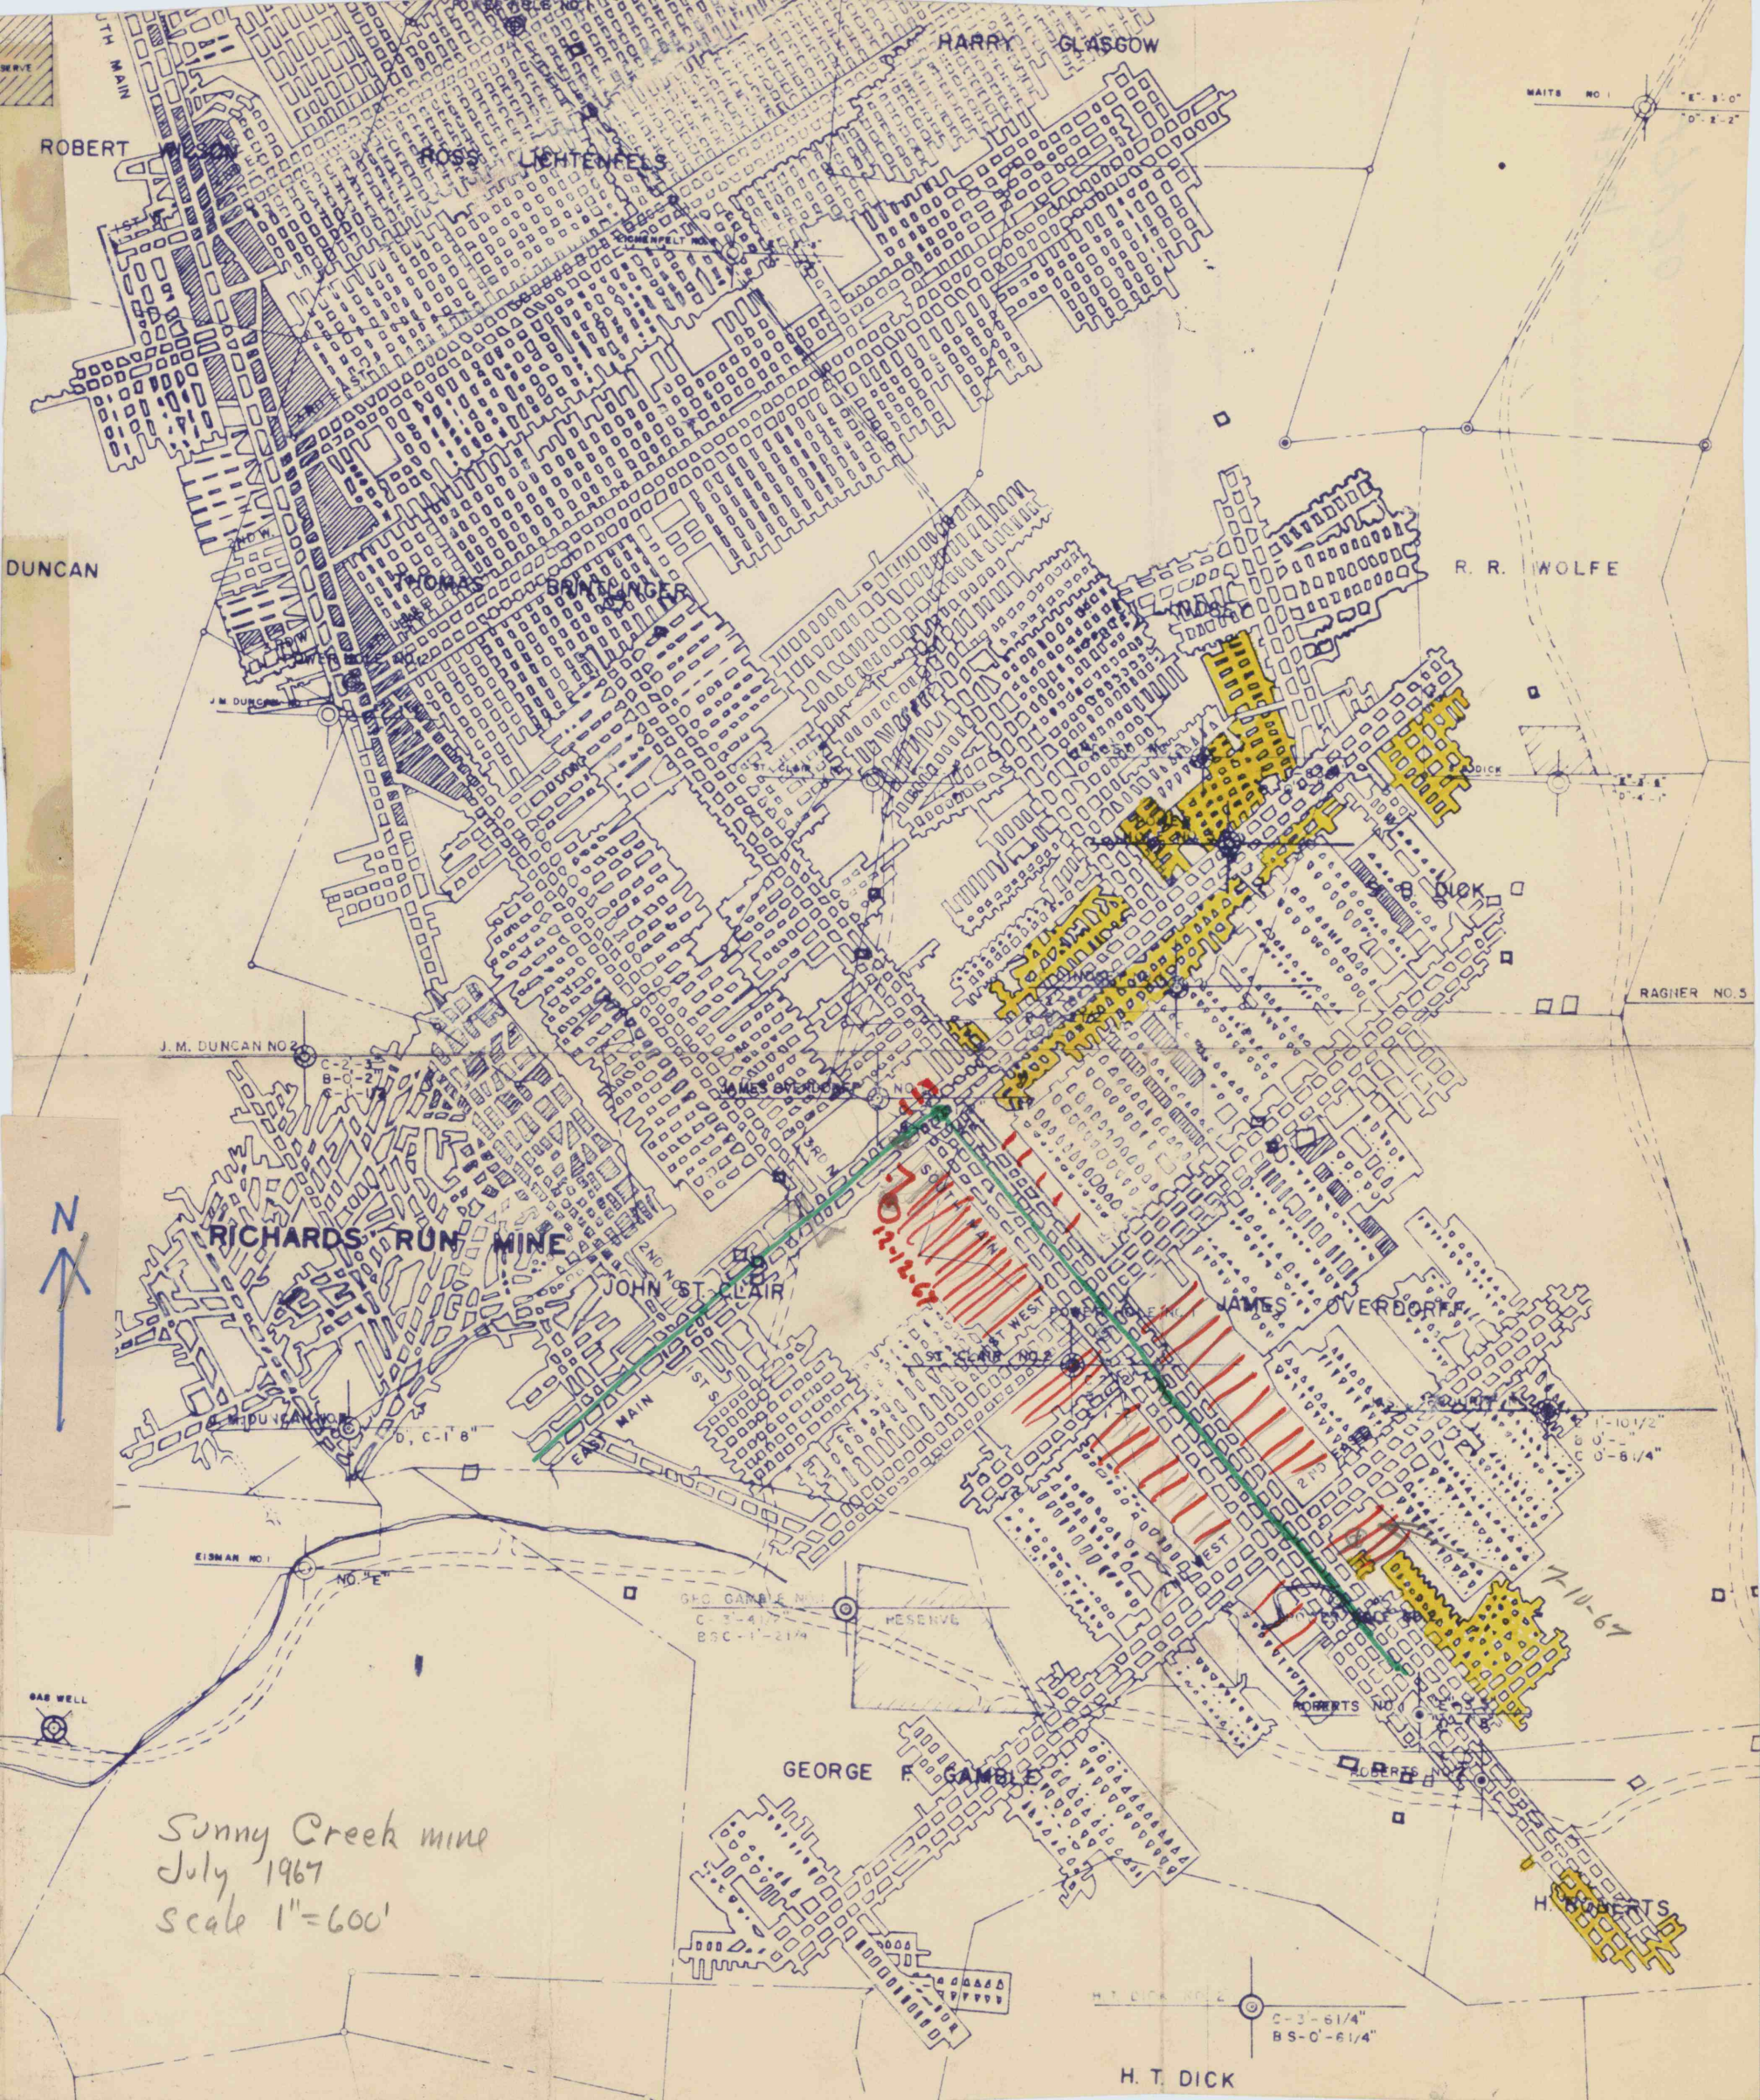

ROBERT

ROSS

LICHTENFELS

HARRY GLASGOW

MAITS NO. 1
"E" 8' 0"
"O" 2' 2"

DUNCAN

R. R. WOLFE

THOMAS

BRANTNER

J. M. DUNCAN NO. 2

RICHARDS RUN MINE

JOHN ST. CLAIR

JAMES OVERDORT

JAMES OVERDORT

EISMAN NO. 1

NO. "E"

GEORGE GAMBLE NO. 1
C-3-4 1/2"
BS-C-1'-2 1/4"

RESERVE

GEORGE F. GAMBLE

ROBERTS NO. 1

ROBERTS NO. 2

H. T. DICK

H. T. DICK NO. 1

C-3-6 1/4"
BS-C-6 1/4"

H. T. DICK

Sunny Creek mine
July 1967
scale 1"=600'