


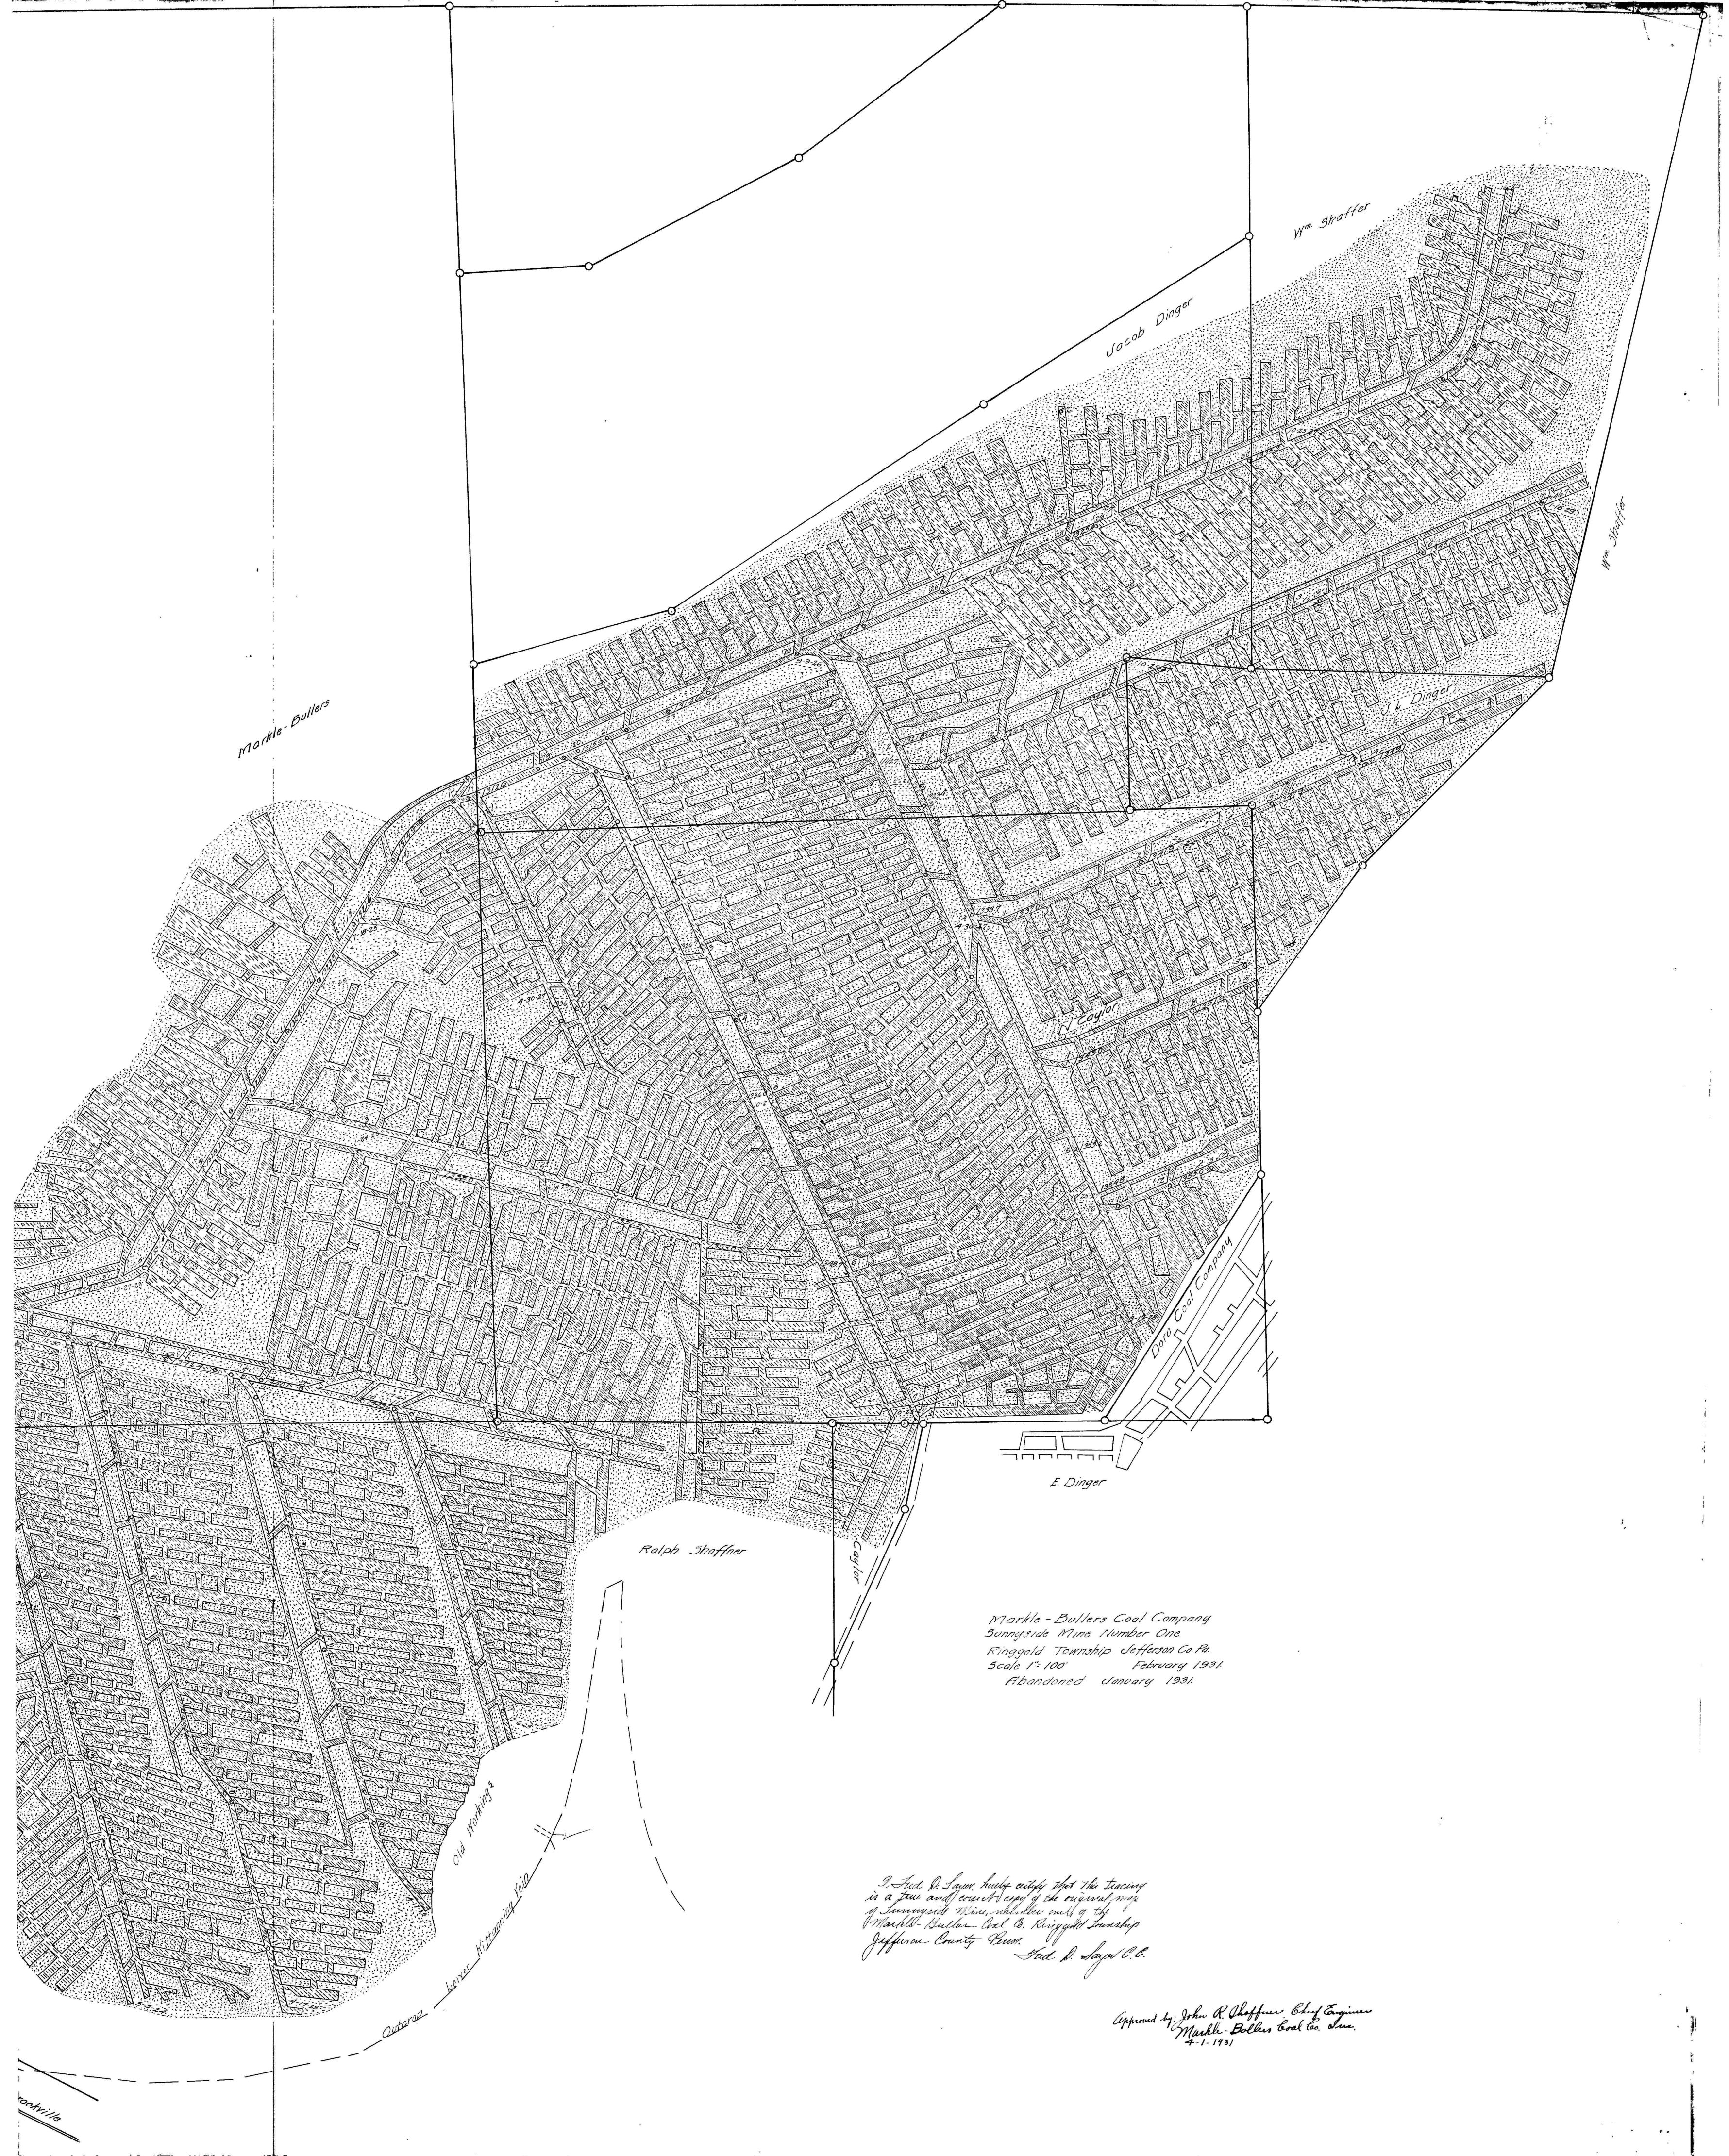

Markle-Bullers

Jacob Dinger

Wm. Shaffer

Wm. Shaffer

Caylor

E. Dinger

Ralph Shaffer

Caylor

Dora Coal Company

Old Working

Antwerp - Jones-Kittanning Rd.

Markle-Bullers Coal Company
Sunnyside Mine Number One
Ringgold Township Jefferson Co. Pa.
Scale 1"=100' February 1931
Abandoned January 1931.

I find R. L. Shaw's map of this territory is a true and correct copy of the original map of Sunnyside Mine, which was made by Markle-Bullers Coal Co., Ringgold Township, Jefferson County, Penn. Feb. 1, 1931.

Approved by John R. Shaffer, Chief Engineer
Markle-Bullers Coal Co., Inc.
4-1-1931