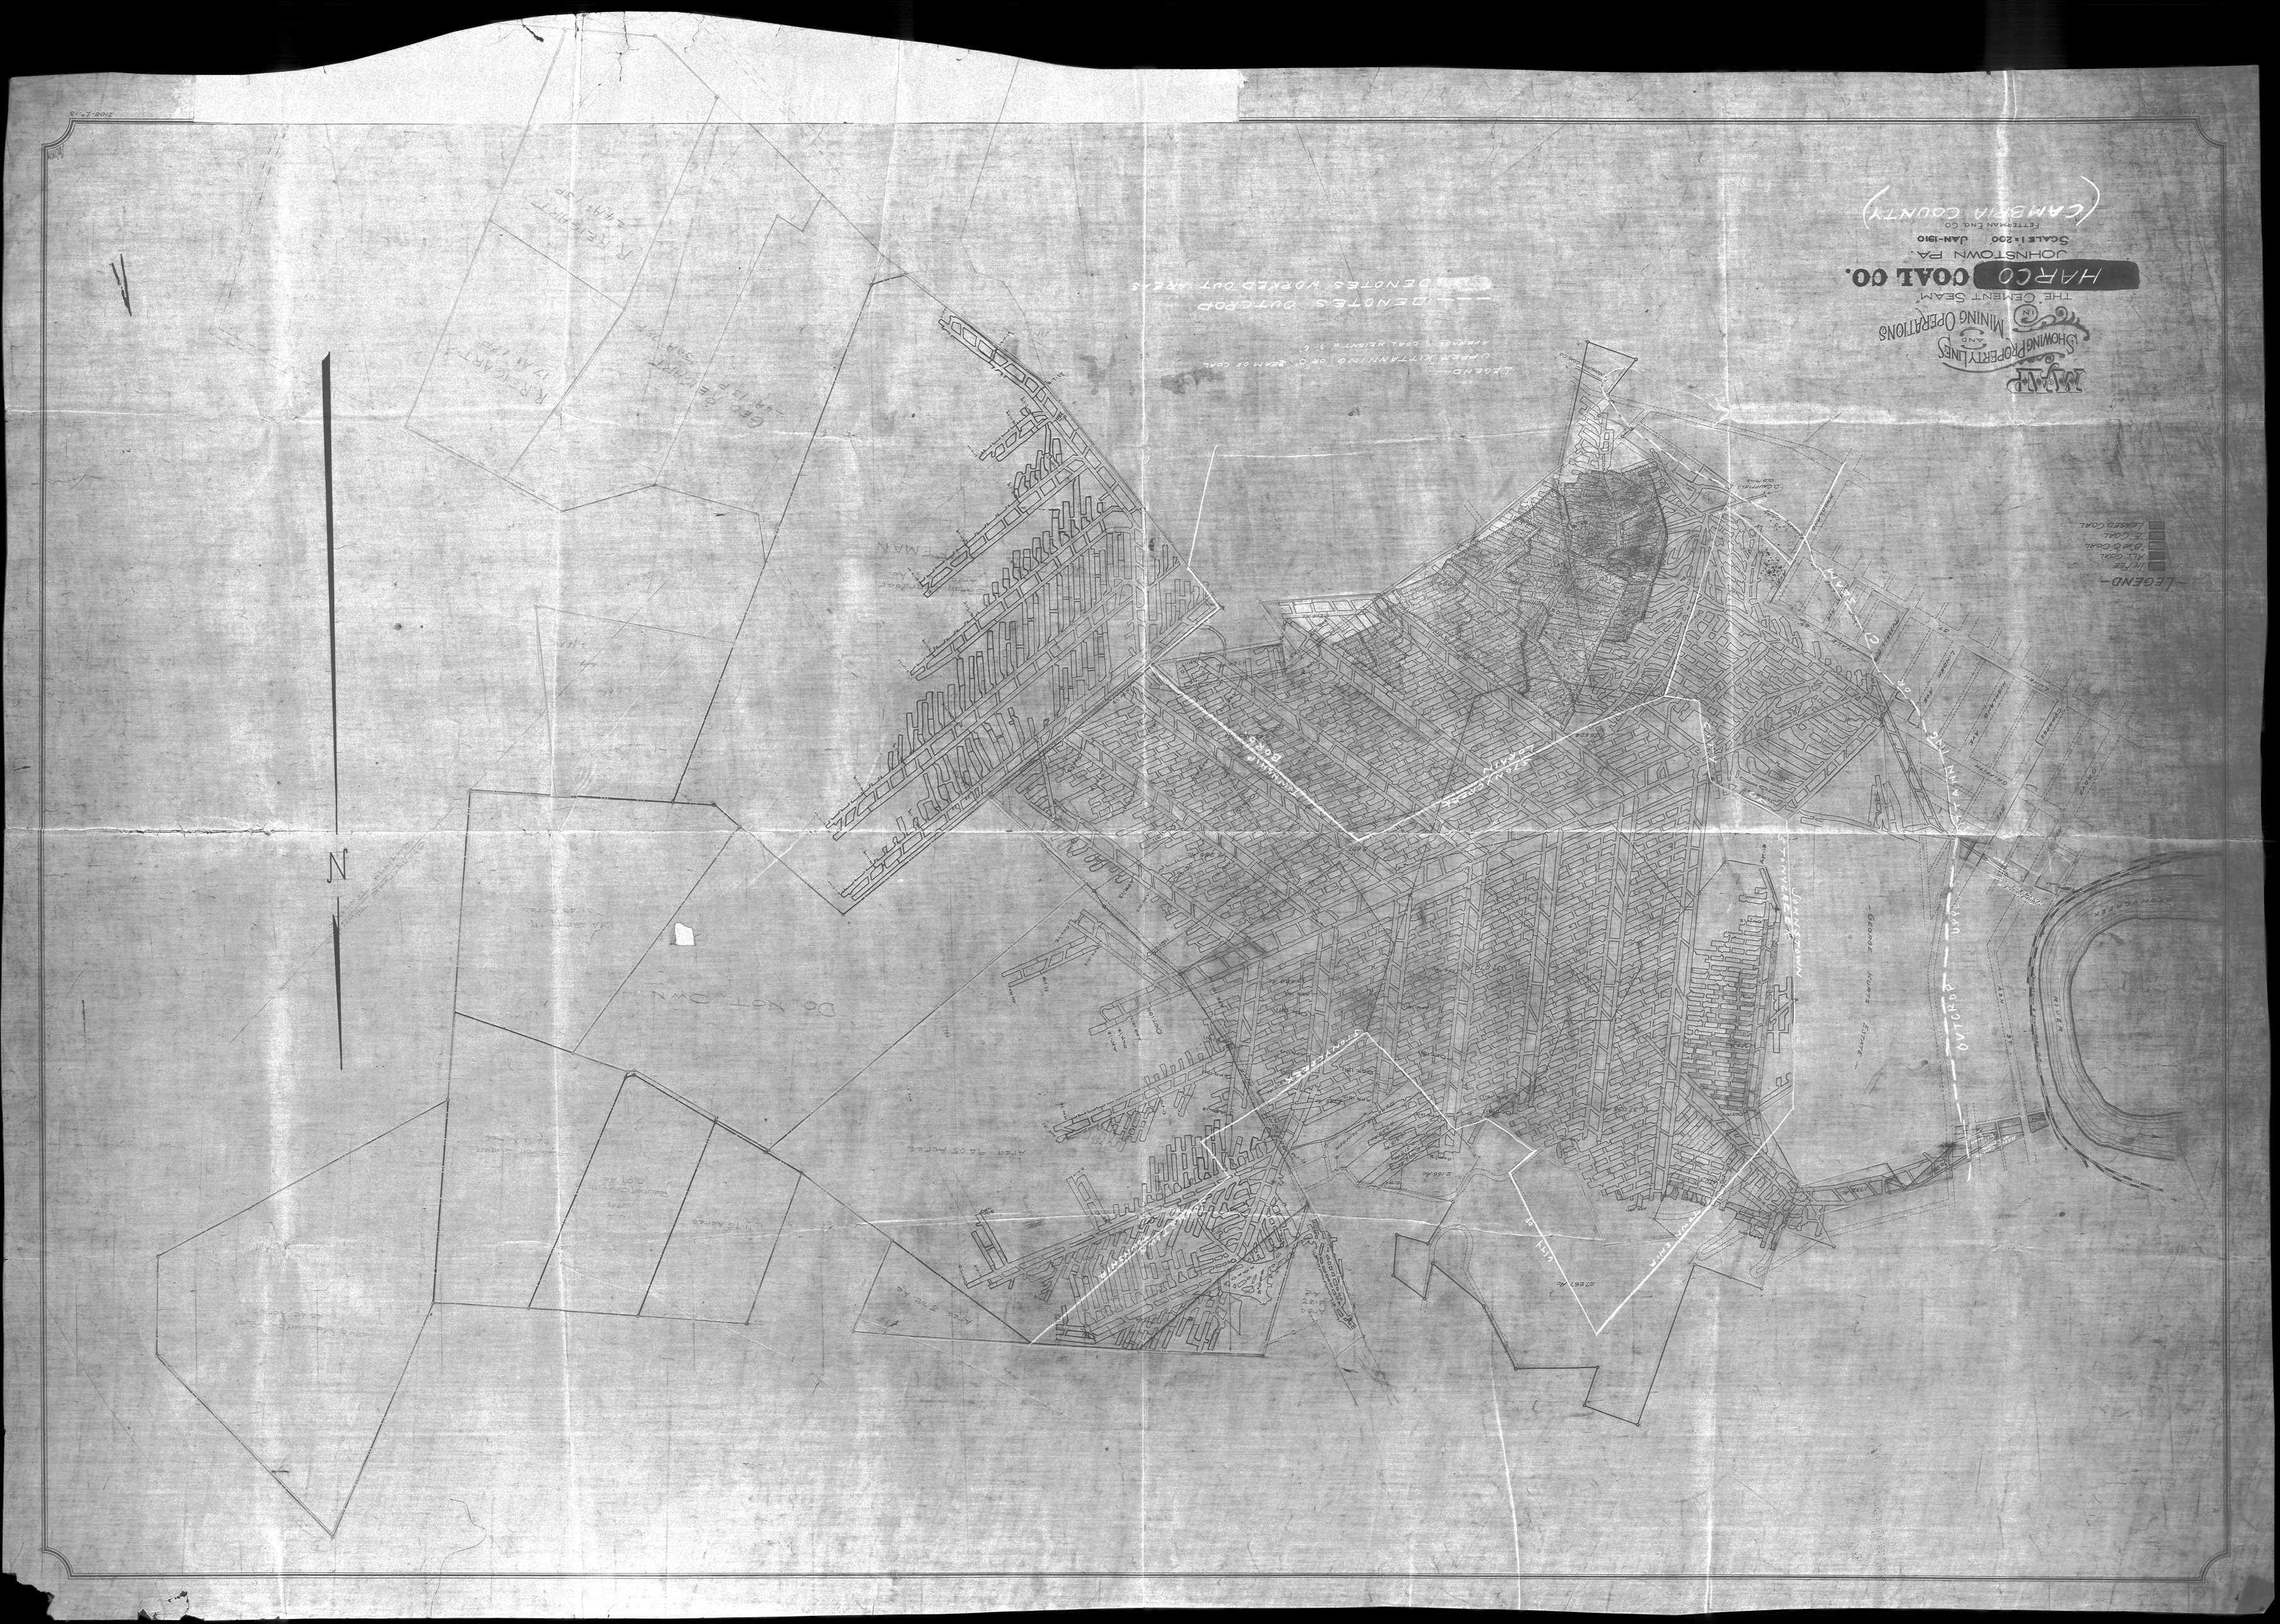

HARCO COAL CO.
JOHNSTOWN PA.
SCALE 1=200 JAN-1910
FETTERMAN ENG. CO.
(CAMBRIA COUNTY)
THE CEMENT SEAM
SHOWING PROPERTY LINES AND MINING OPERATIONS
LEGEND
UPPER KITTANNING OR C SEAM OF COAL
AVERAGE COAL HEIGHT = 3' 6"
DENOTES OUTCROP
DENOTES WORKED OUT AREAS
LEGEND
IN FEE
ALL COAL
B & C COAL
E COAL
LEASED COAL
N