
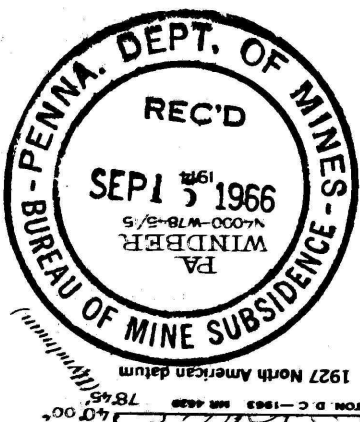


FOR SALE BY U. S. GEOLOGICAL SURVEY, WASHINGTON 25, D. C.
A FOLDER DESCRIBING TOPOGRAPHIC MAPS AND SYMBOLS IS AVAILABLE ON REQUEST
Sept 7-1966 K.E. ERICHSON R.F. 57674

DAVID W. SYDNOR
MINE 419

Surveyed in 1913-1914.
Control by Geo. Hawkins and T.A. Green.
Topography by Robert M. Brown, Oscar Jones.
Frank Sutton, Geographer in Charge.
R.B. Marshall, Chief Geographer.

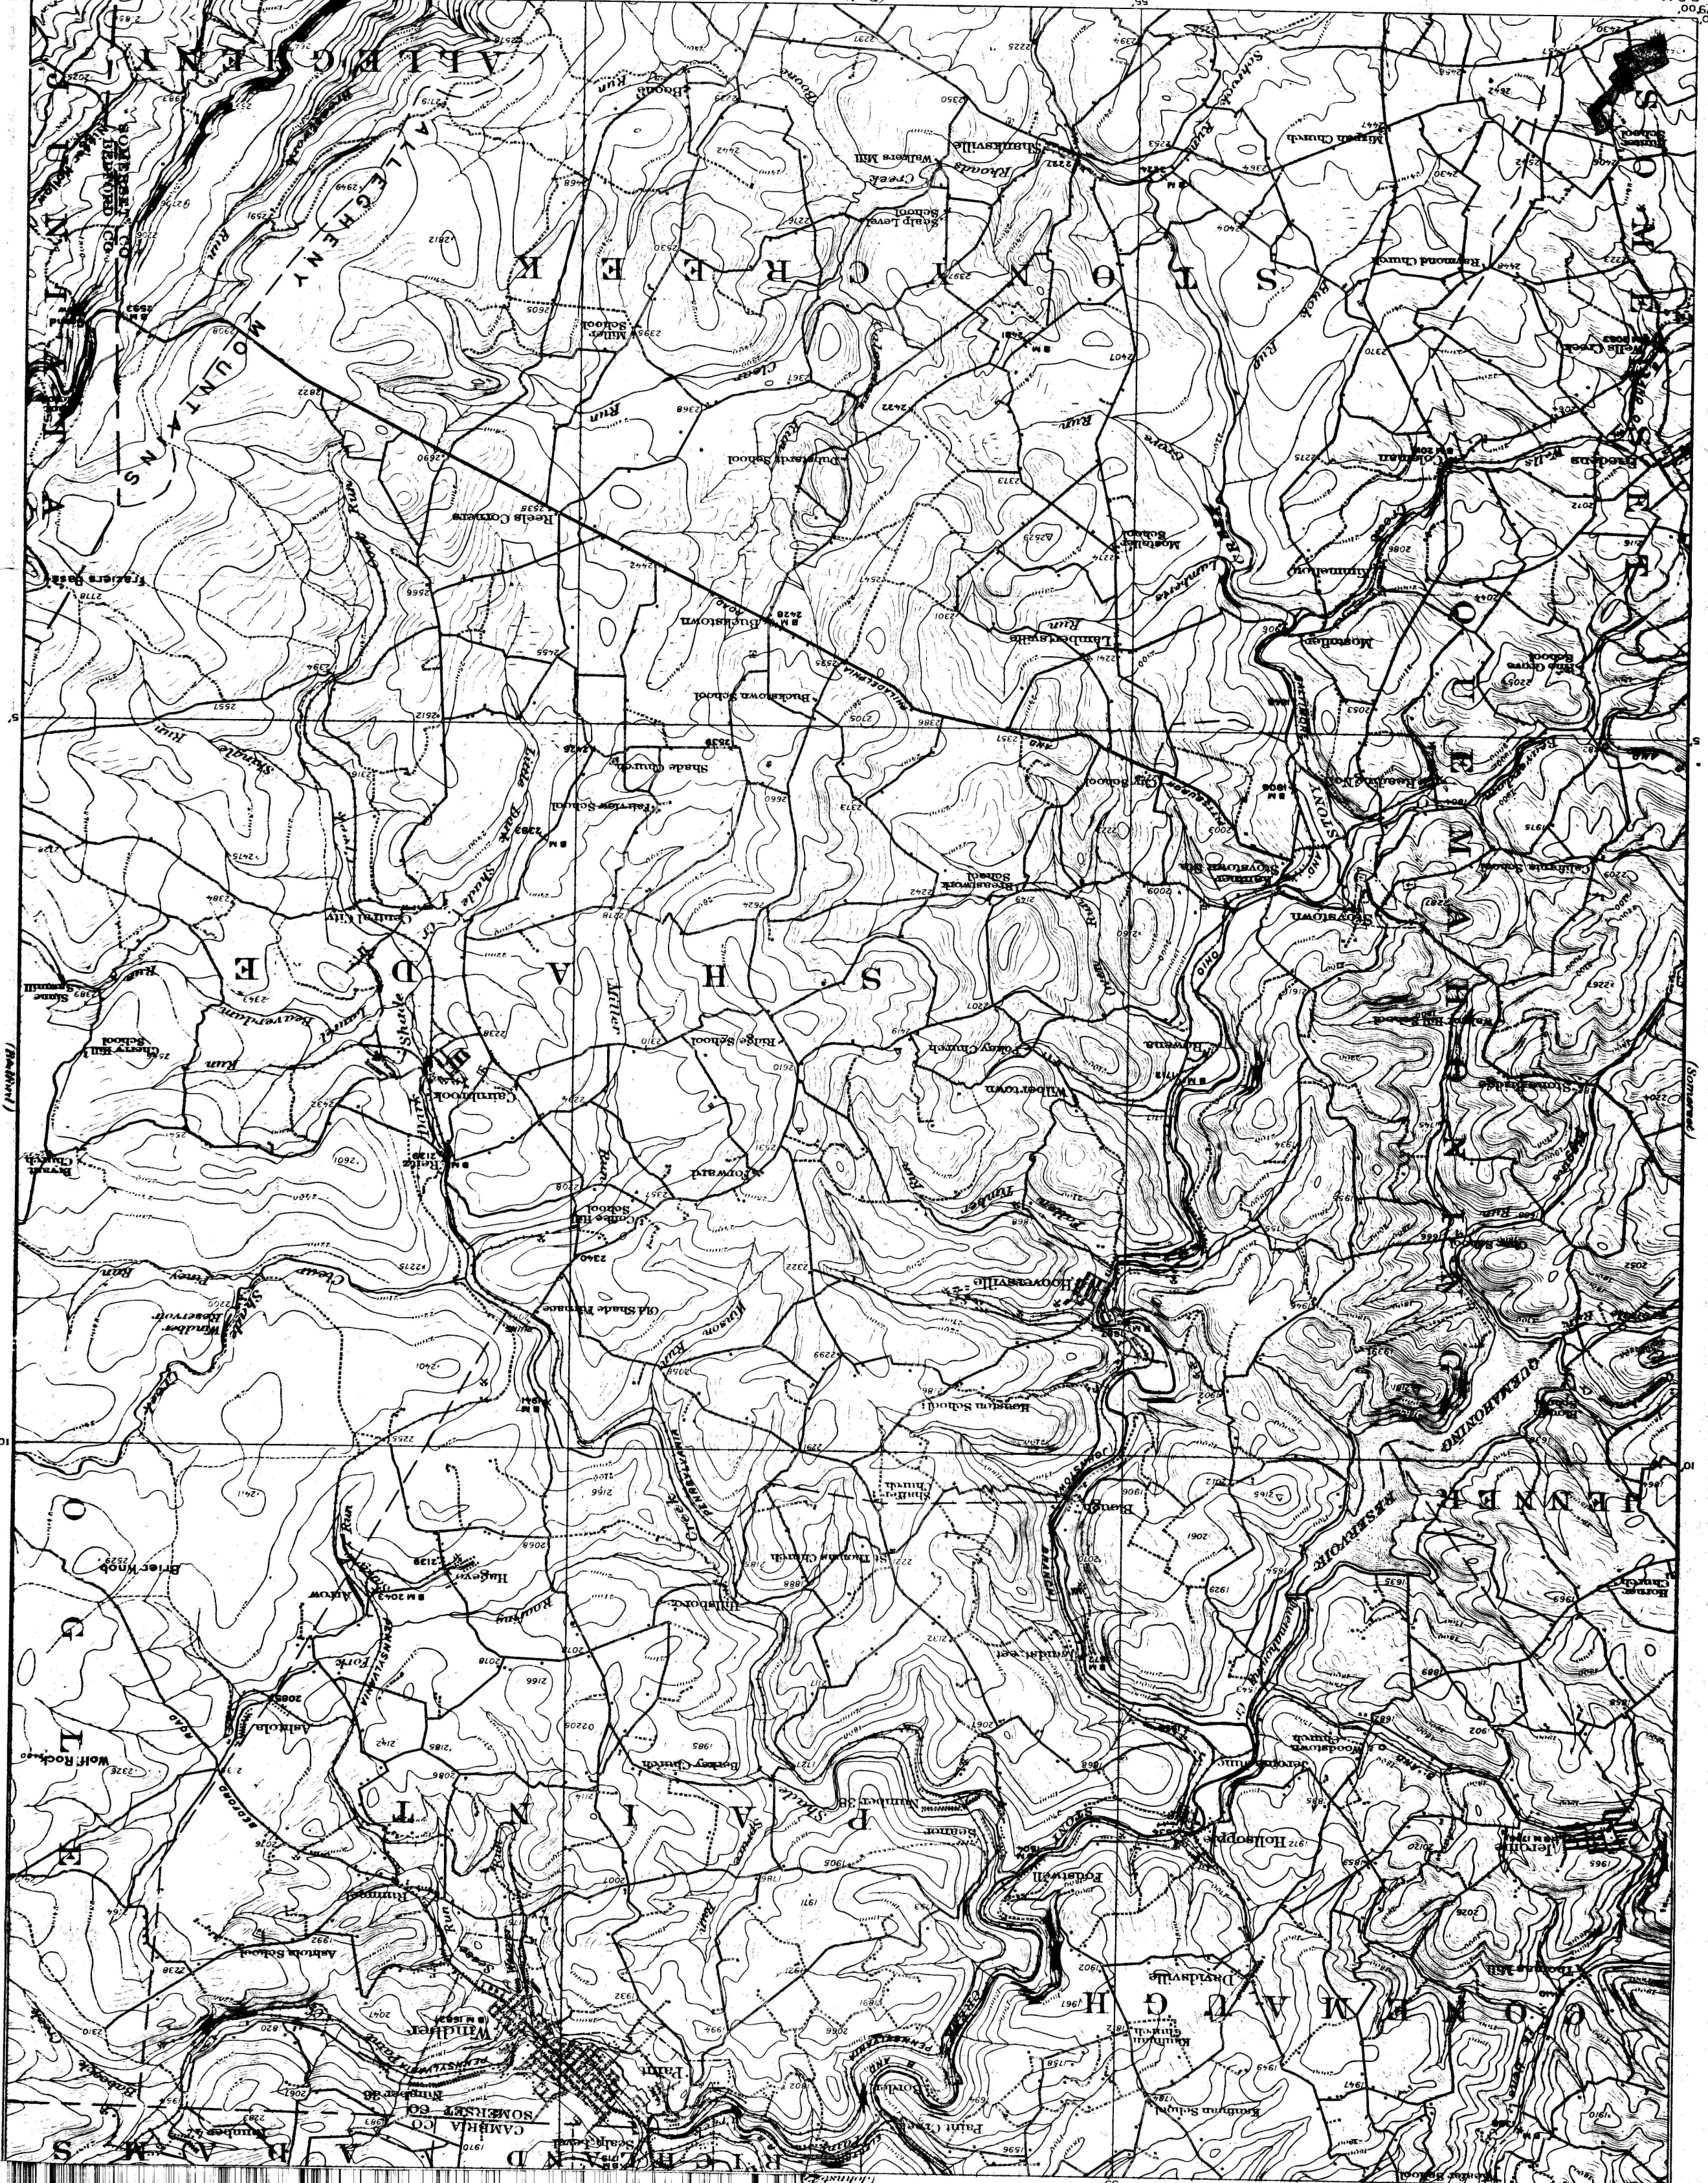

FIELD COPY

UNITED STATES
DEPARTMENT OF THE INTERIOR
GEOLOGICAL SURVEY
STATE OF PENNS
REPRESENTED
DEPARTMENT OF INTER
TOPOGRAPHIC AND GEO