


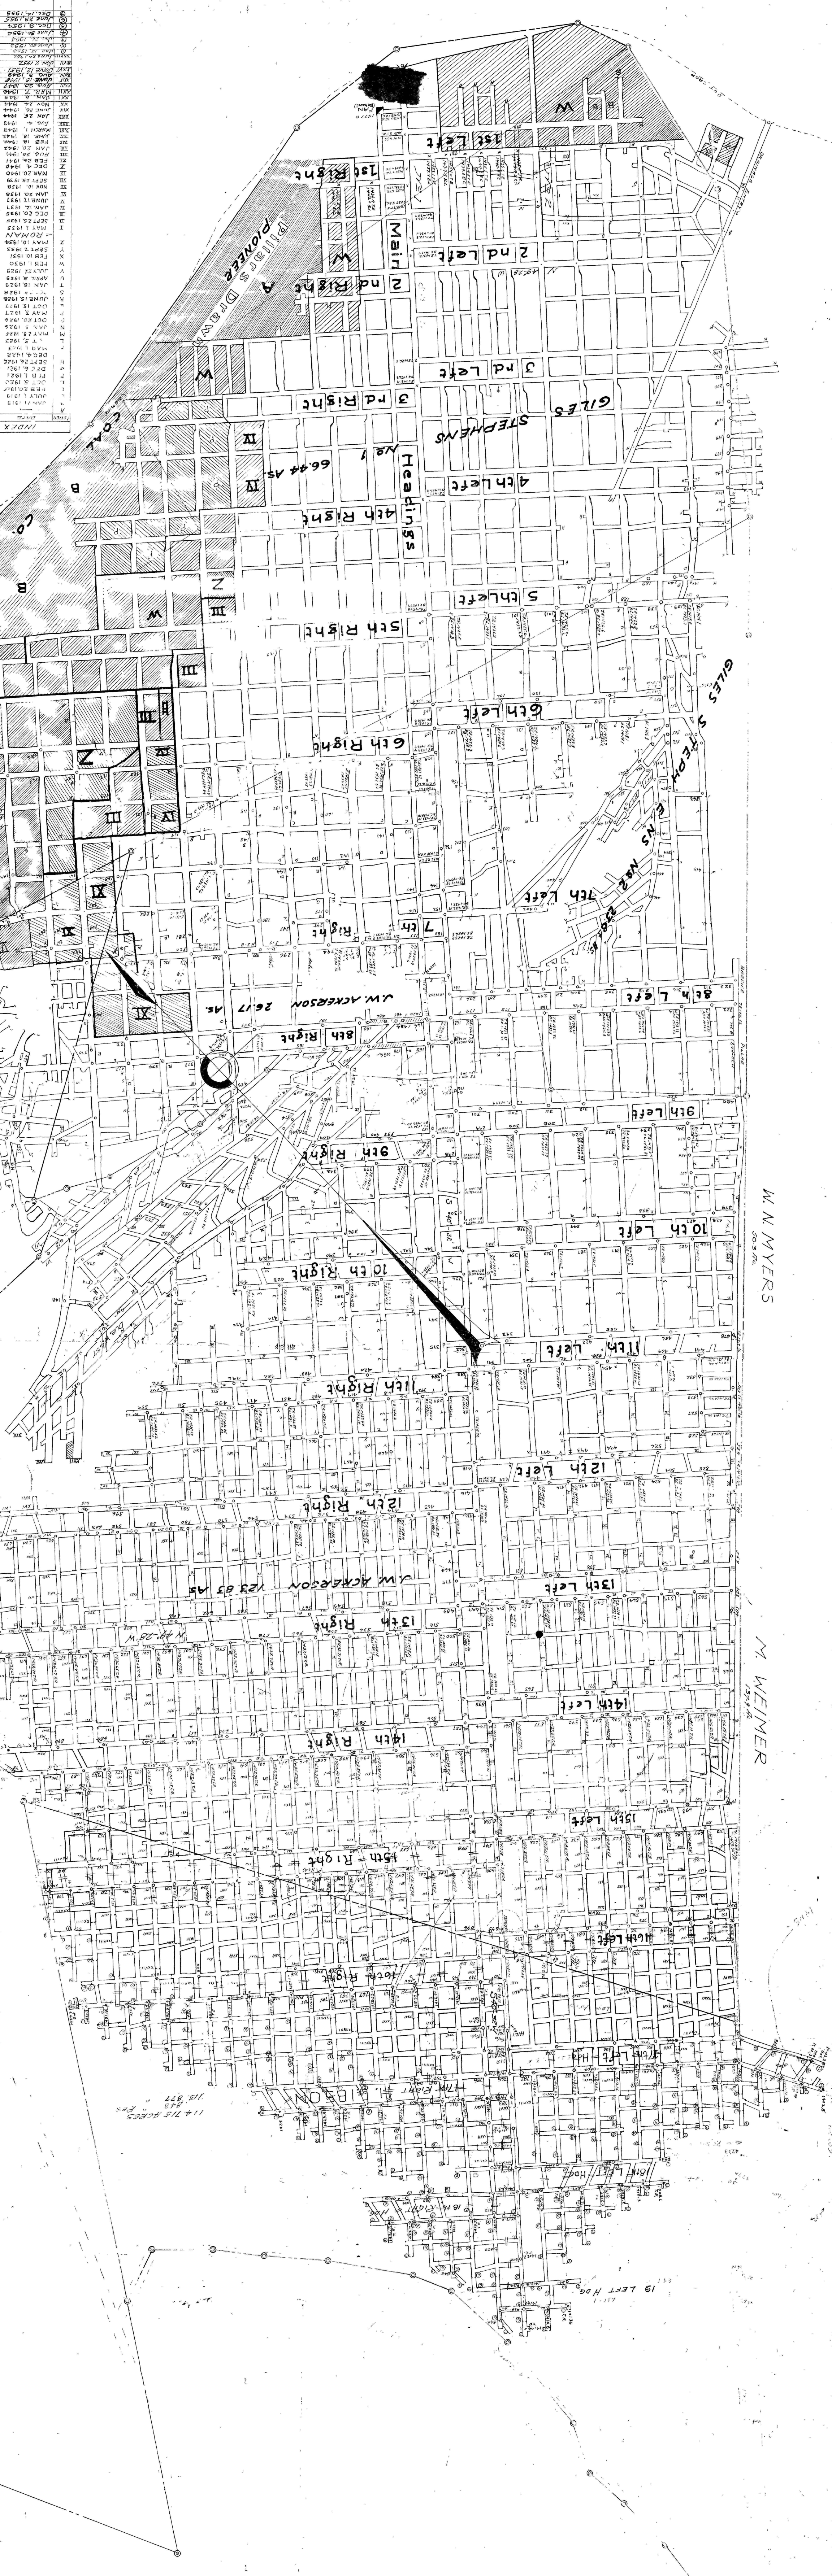

INDEX
1st Left
2nd Left
3rd Left
4th Left
5th Left
6th Left
7th Left
8th Left
9th Left
10th Left
11th Left
12th Left
13th Left
14th Left
15th Left
16th Left
17th Left
18th Left
19th Left
1st Right
2nd Right
3rd Right
4th Right
5th Right
6th Right
7th Right
8th Right
9th Right
10th Right
11th Right
12th Right
13th Right
14th Right
15th Right
16th Right

W. N. MYERS
1903

M. WEINER
1907

Pioneer's Drive
Main
Leaning
66.44 AS
IV
III
II
I

U.W. ACKERSON 26.17 AS
11th Left
12th Left
13th Left
14th Left
15th Left
16th Left
17th Left
18th Left
19th Left

U.W. ACKERSON 123.63 AS
11th Right
12th Right
13th Right
14th Right
15th Right
16th Right
17th Right
18th Right
19th Right

11.4 7.15 REES
113.977
11.4 7.15 REES