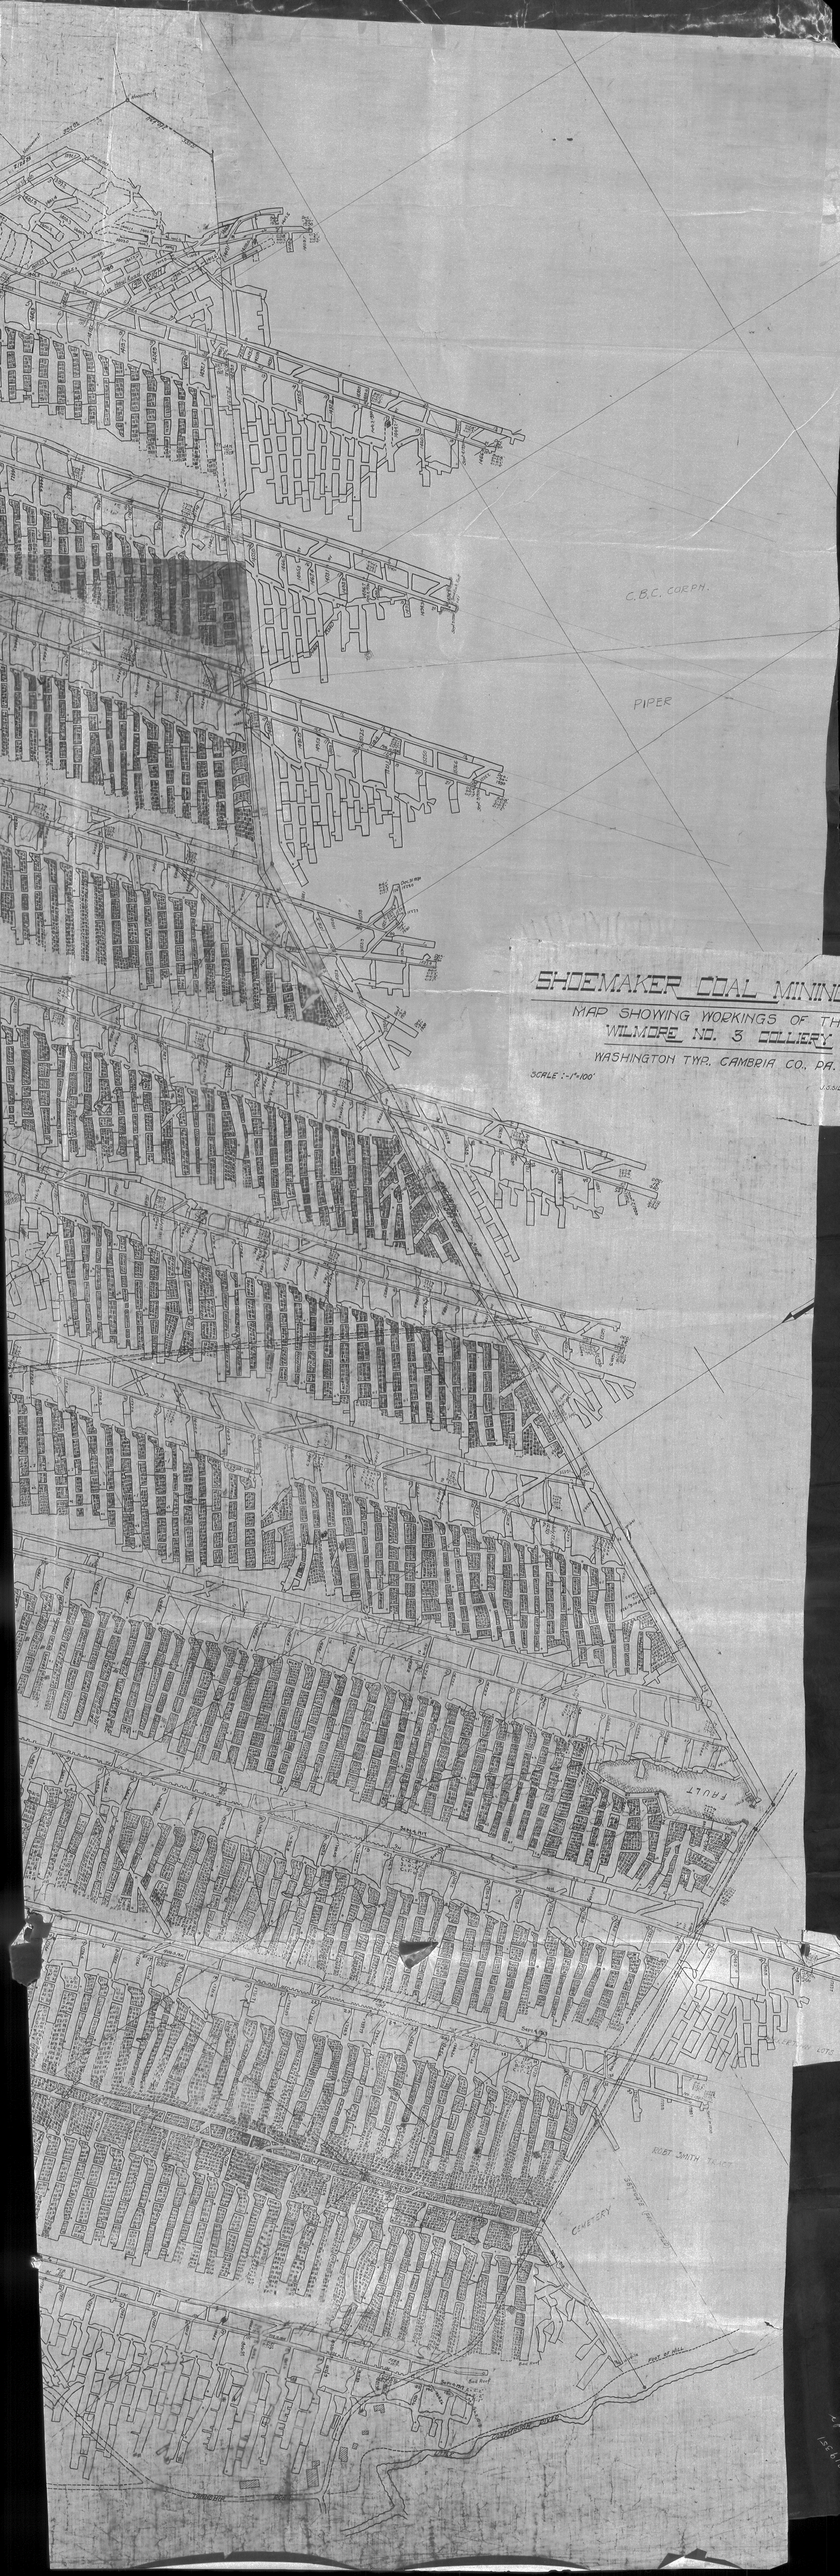
C.B.C. CORP'N.
PIPER
SHOEMAKER COAL MINING
MAP SHOWING WORKINGS OF THE
WILMORE NO. 3 COLLIERY
WASHINGTON TWP. CAMBRIA CO., PA.
SCALE :- 1"=100'
FAULT
ROBT. SMITH TRACT
CEMETERY