

Elizabeth Orris
Tract No 453

Wm. A. Jones
Tract No 452

Emmett Johnson
Tract No 454
N.M.
Fred Marshall

Dunlop Coal Co

Josiah Frye
Tract No 460

Henry Blough
Tract No 456
N.M.
GEISTOWN LIONS CLUB

W. F. Allison
Tract No 455

COMPLETION MAP
I HEREBY CERTIFY THIS IS A TRUE AND CORRECT COPY OF
WYATT NO 7 MINE AS OF JUNE 10-1968 OPERATED BY
WINDBER HIGH GRADE COAL CO, SITUATE RICHLAND TWP, CAMBRIA CO, PENNA.
THIS MINE HAS CLOSED, DUE TO THE TAKING OF A RIGHT OF WAY FOR US 215


YE ECKHART RPE 7074

LEGEND
MINING COMPLETED
MONTHS ADVANCE
PROPERTY LINE

WINDBER HIGH GRADE COAL CO

WYATT NO 7 MINE
C PRIME SEAM

RICHLAND TWP CAMBRIA CO, PENNA
SCALE 1"=100' DEC 11 1952

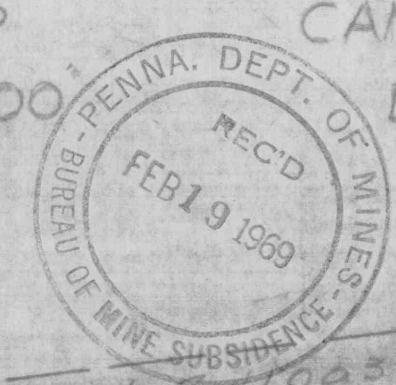

State Highway

To Windber

To WALSALL 2 MI

APPLICATION # 2945-211
JUN 16 1969
RICHLAND TWP CAMBRIA CO