


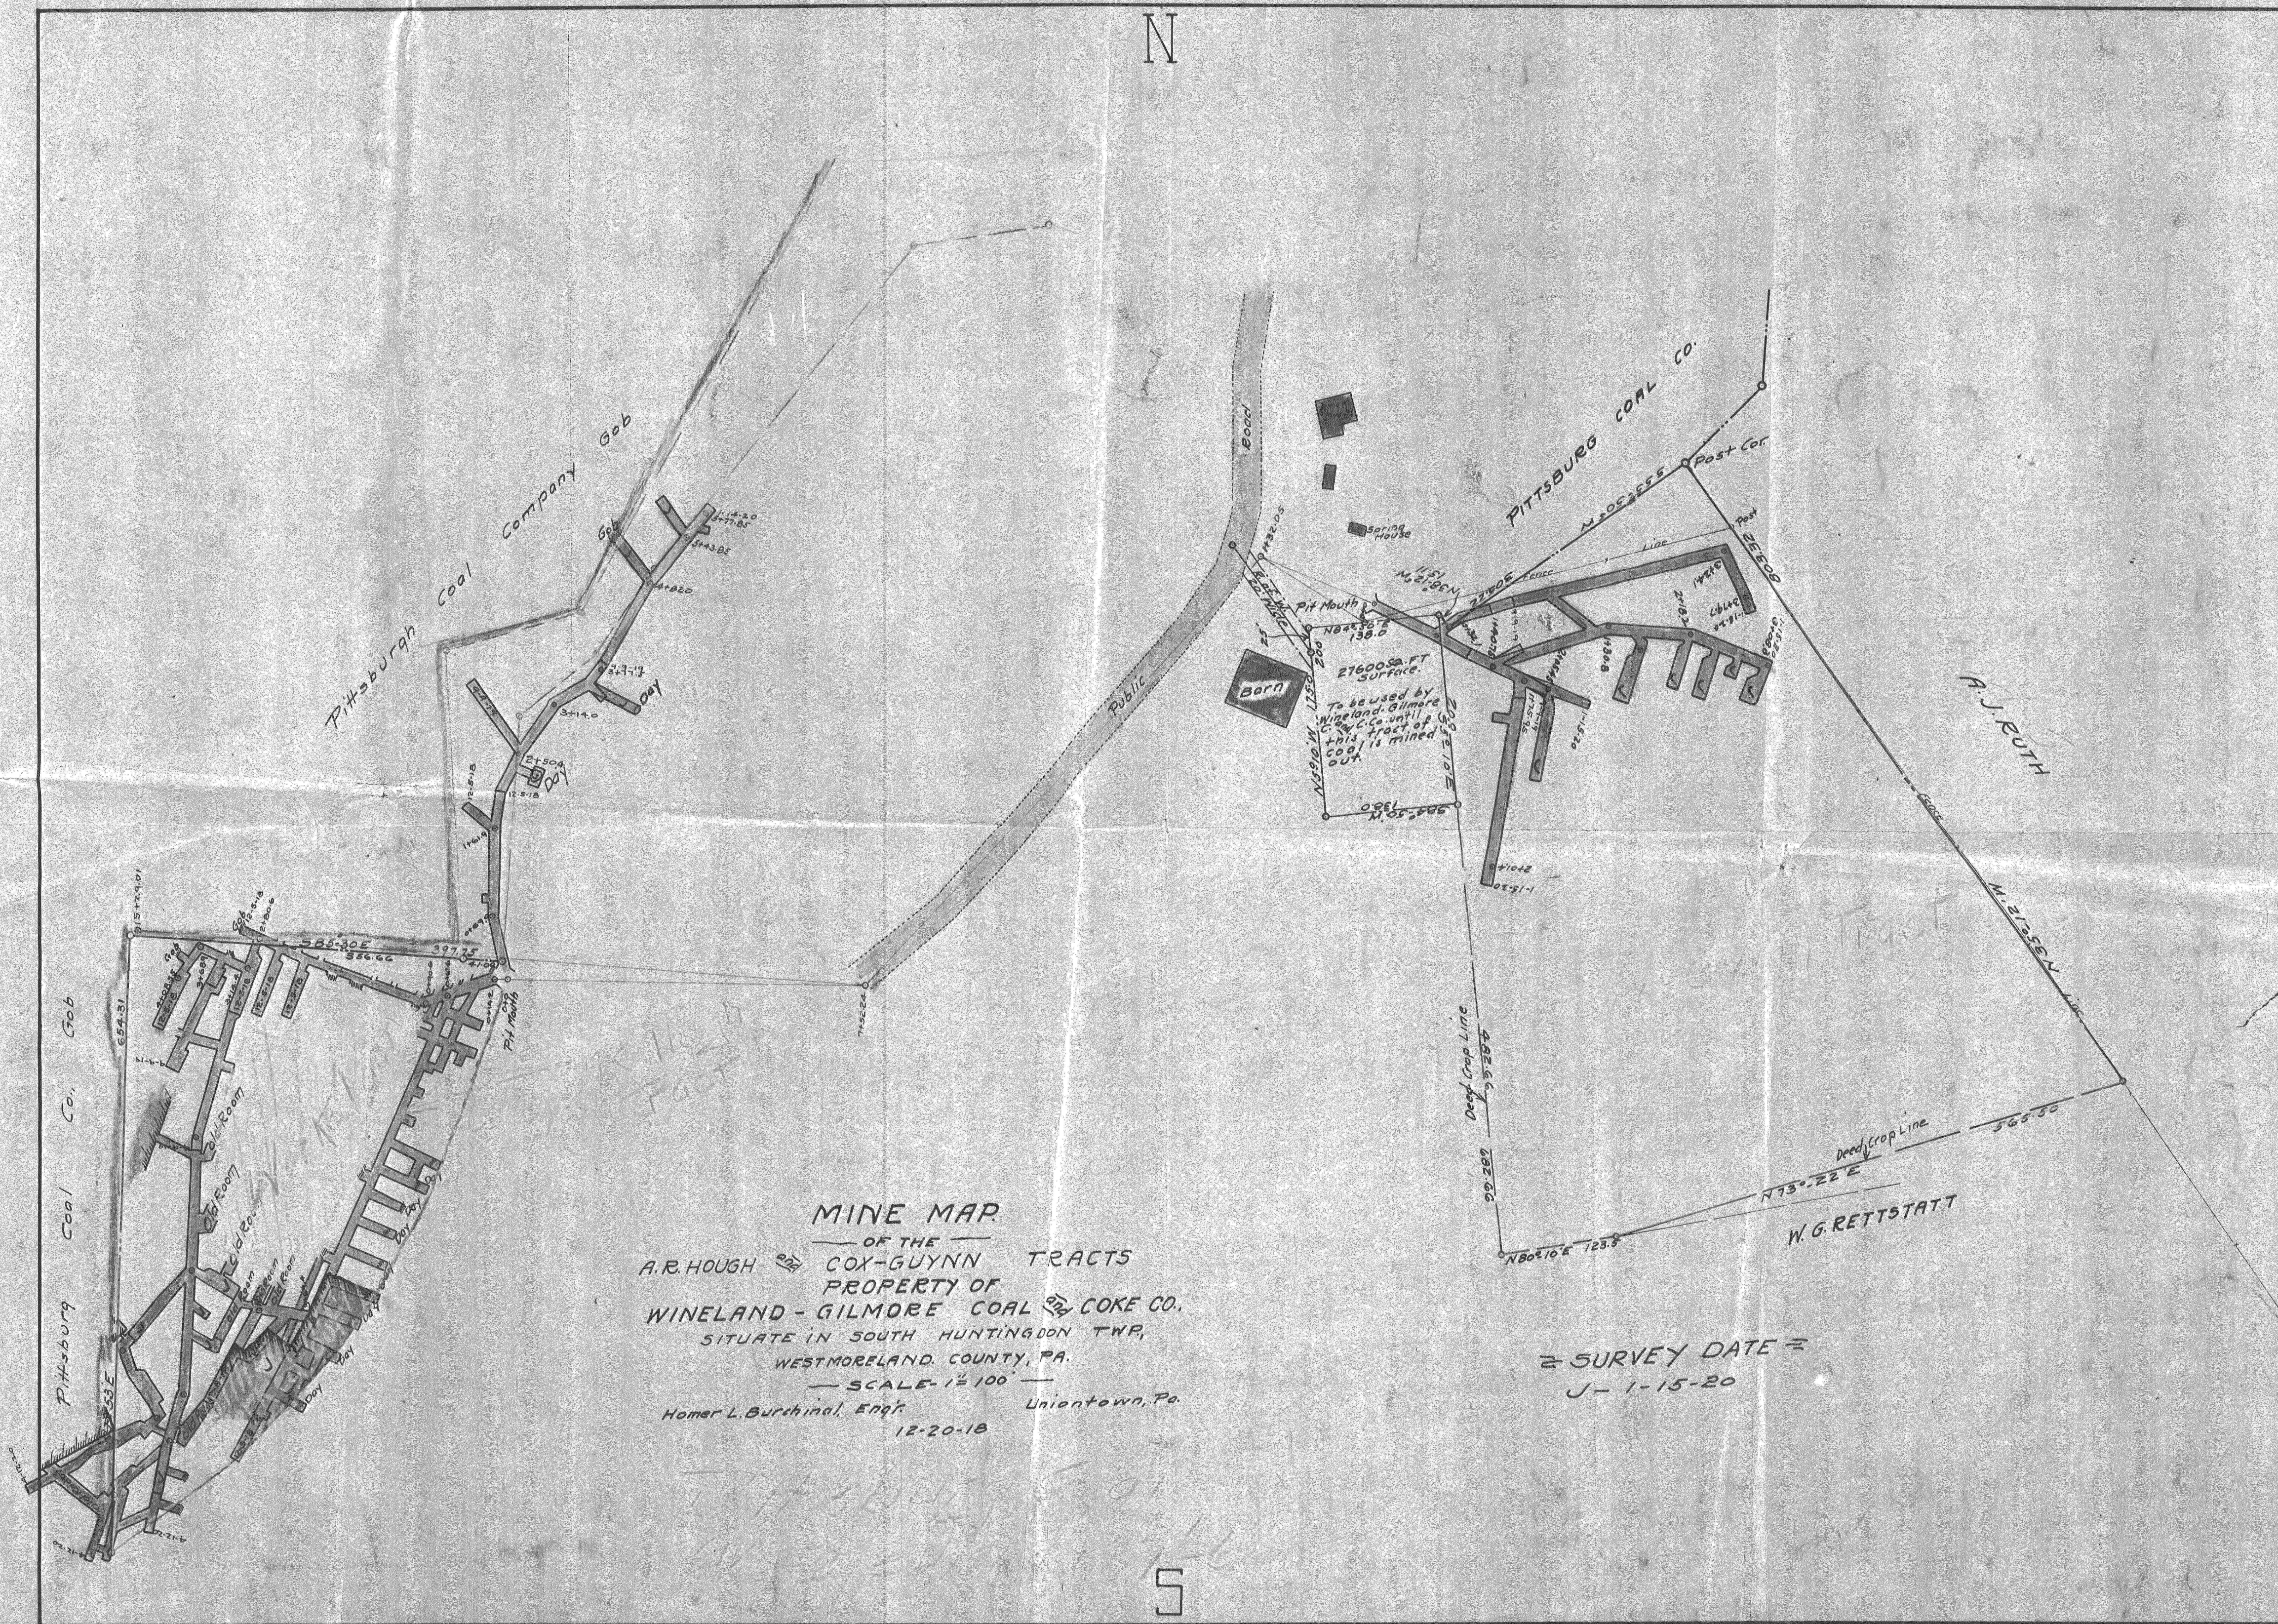

MINE MAP
 OF THE
 A.R. HOUGH & COX-GUYN TRACTS
 PROPERTY OF
 WINELAND - GILMORE COAL & COKE CO.
 SITUATE IN SOUTH HUNTINGDON TWP,
 WESTMORELAND COUNTY, PA.
 SCALE - 1/2" = 100'
 Homer L. Burdinal, Engr.
 12-20-18
 Uniontown, Pa.

SURVEY DATE =
 J - 1-15-20

1 MINE OPENING
 WINMORE