


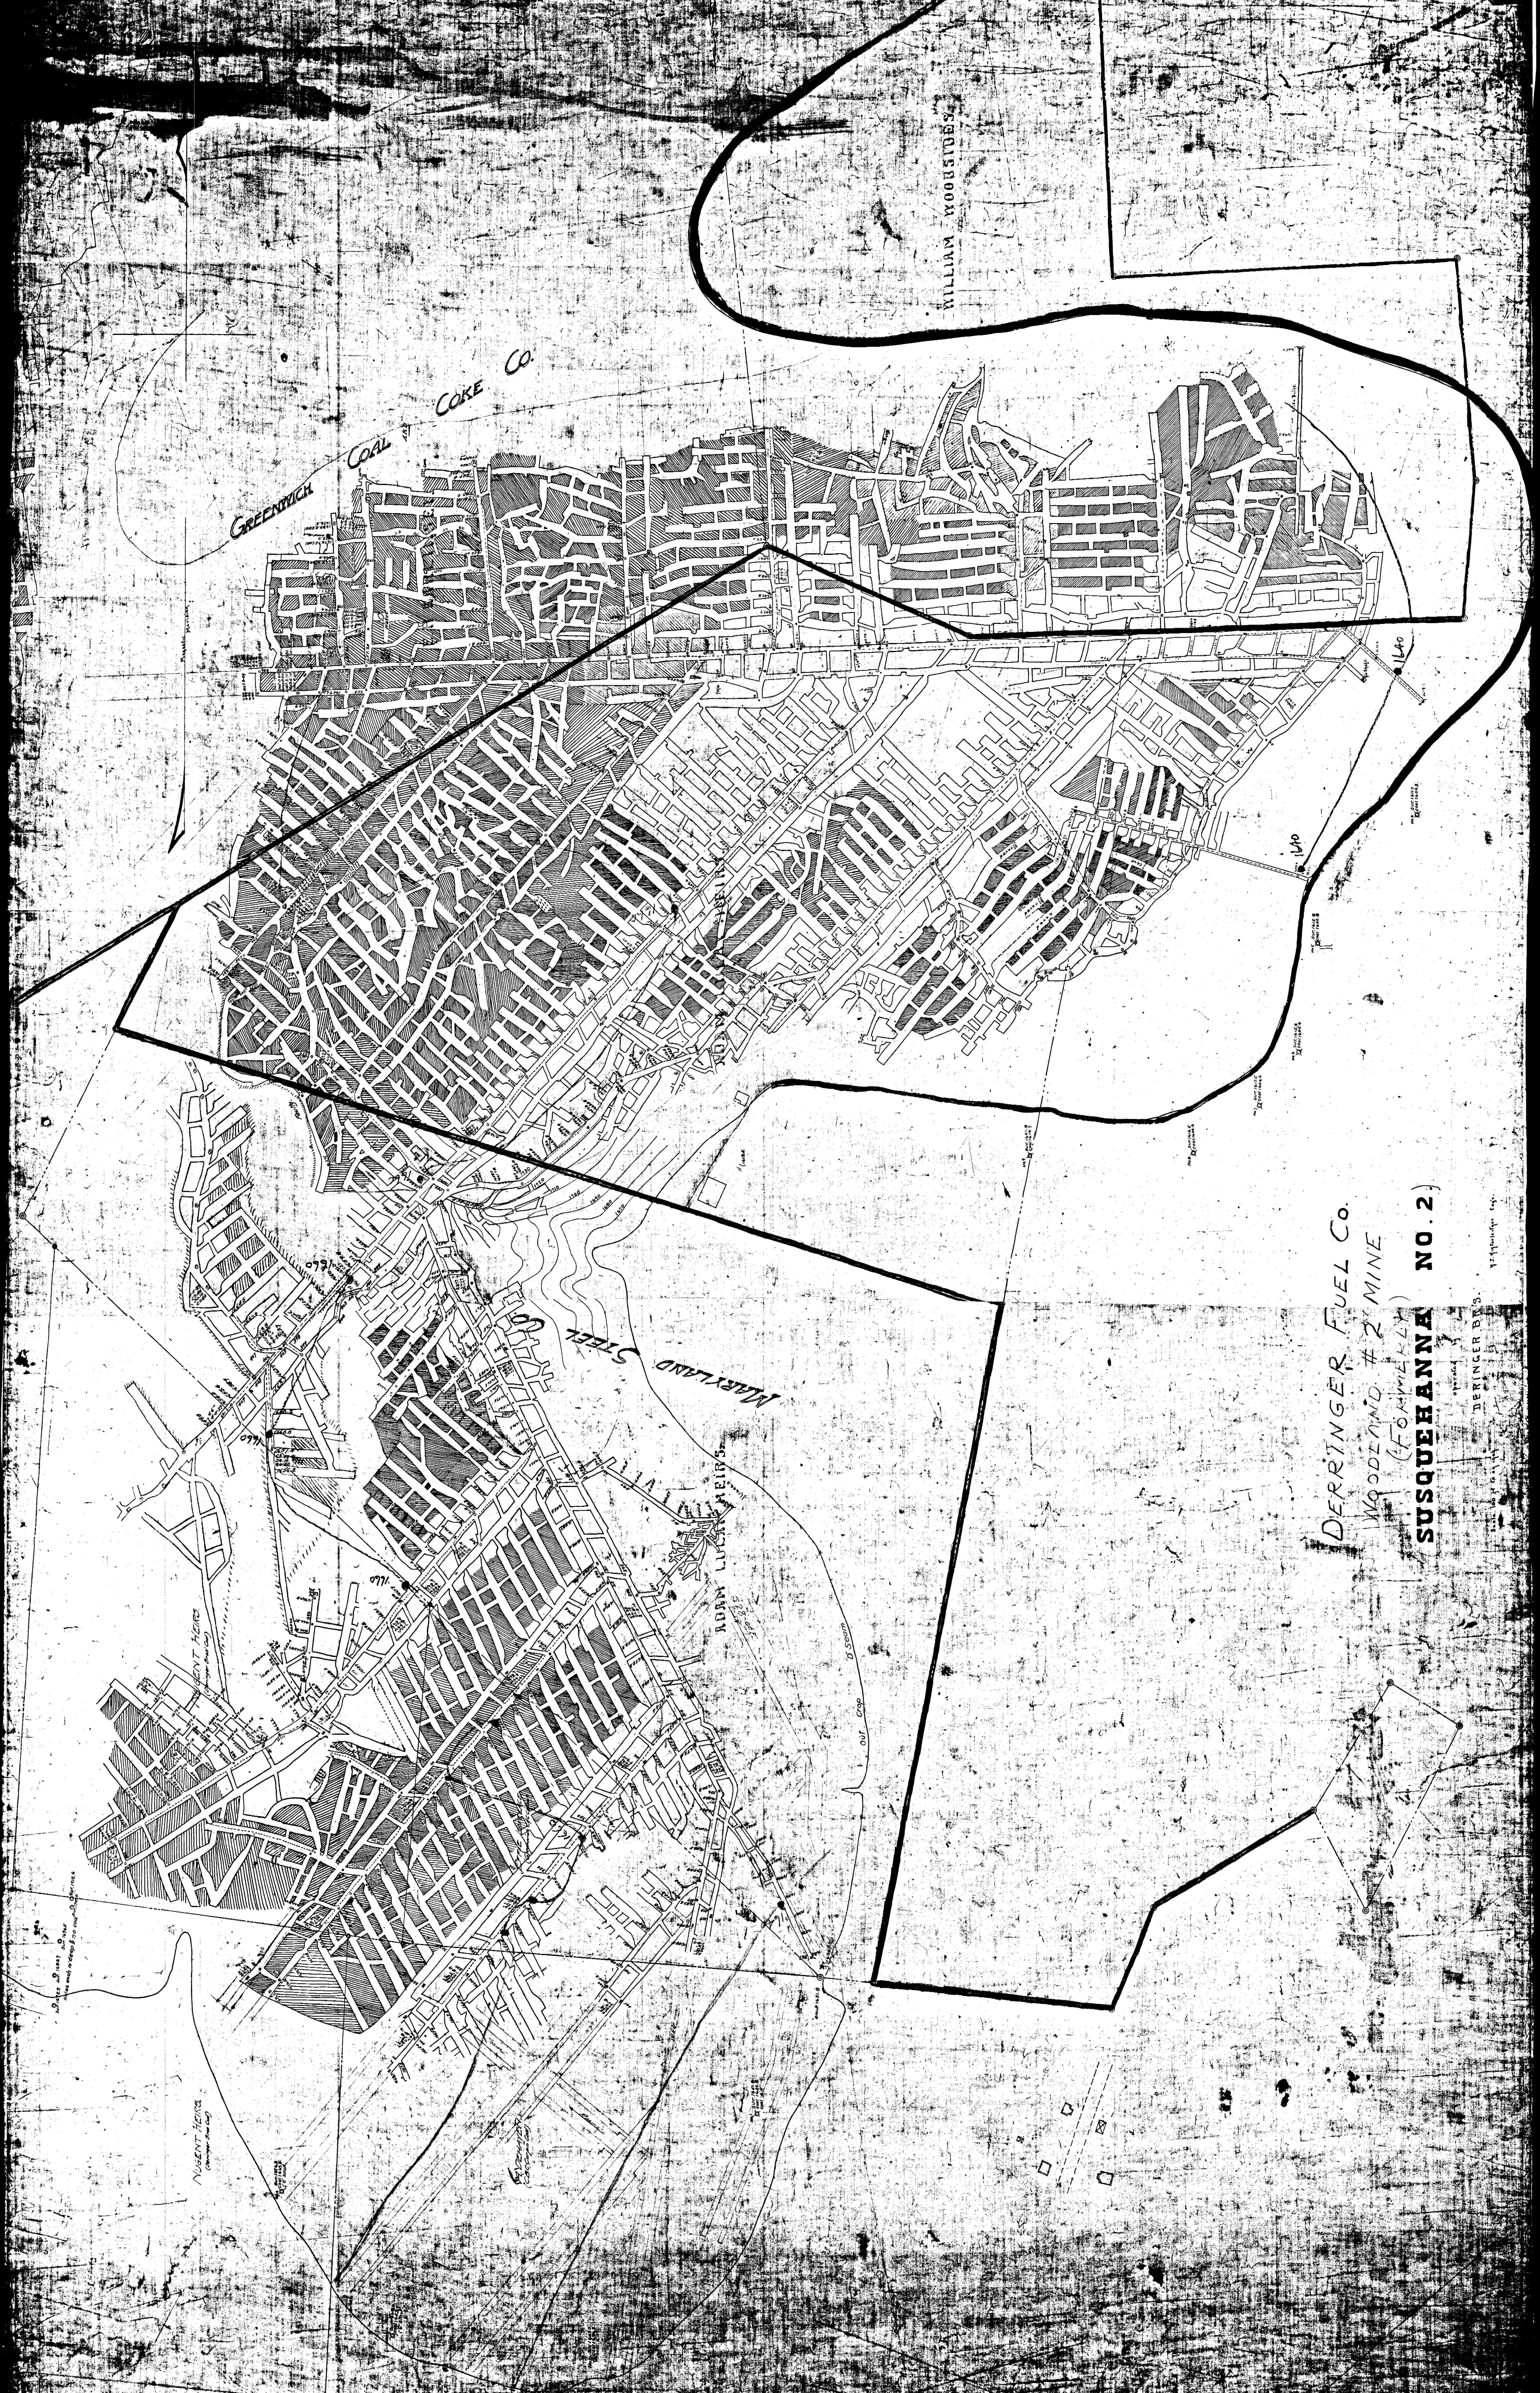

WILLIAM WOODSIDES

DERRINGER FUEL Co.
WOODLAND #2 MINE
(FOMMELER)
SUSQUEHANNA NO. 2

DERRINGER BROS.