


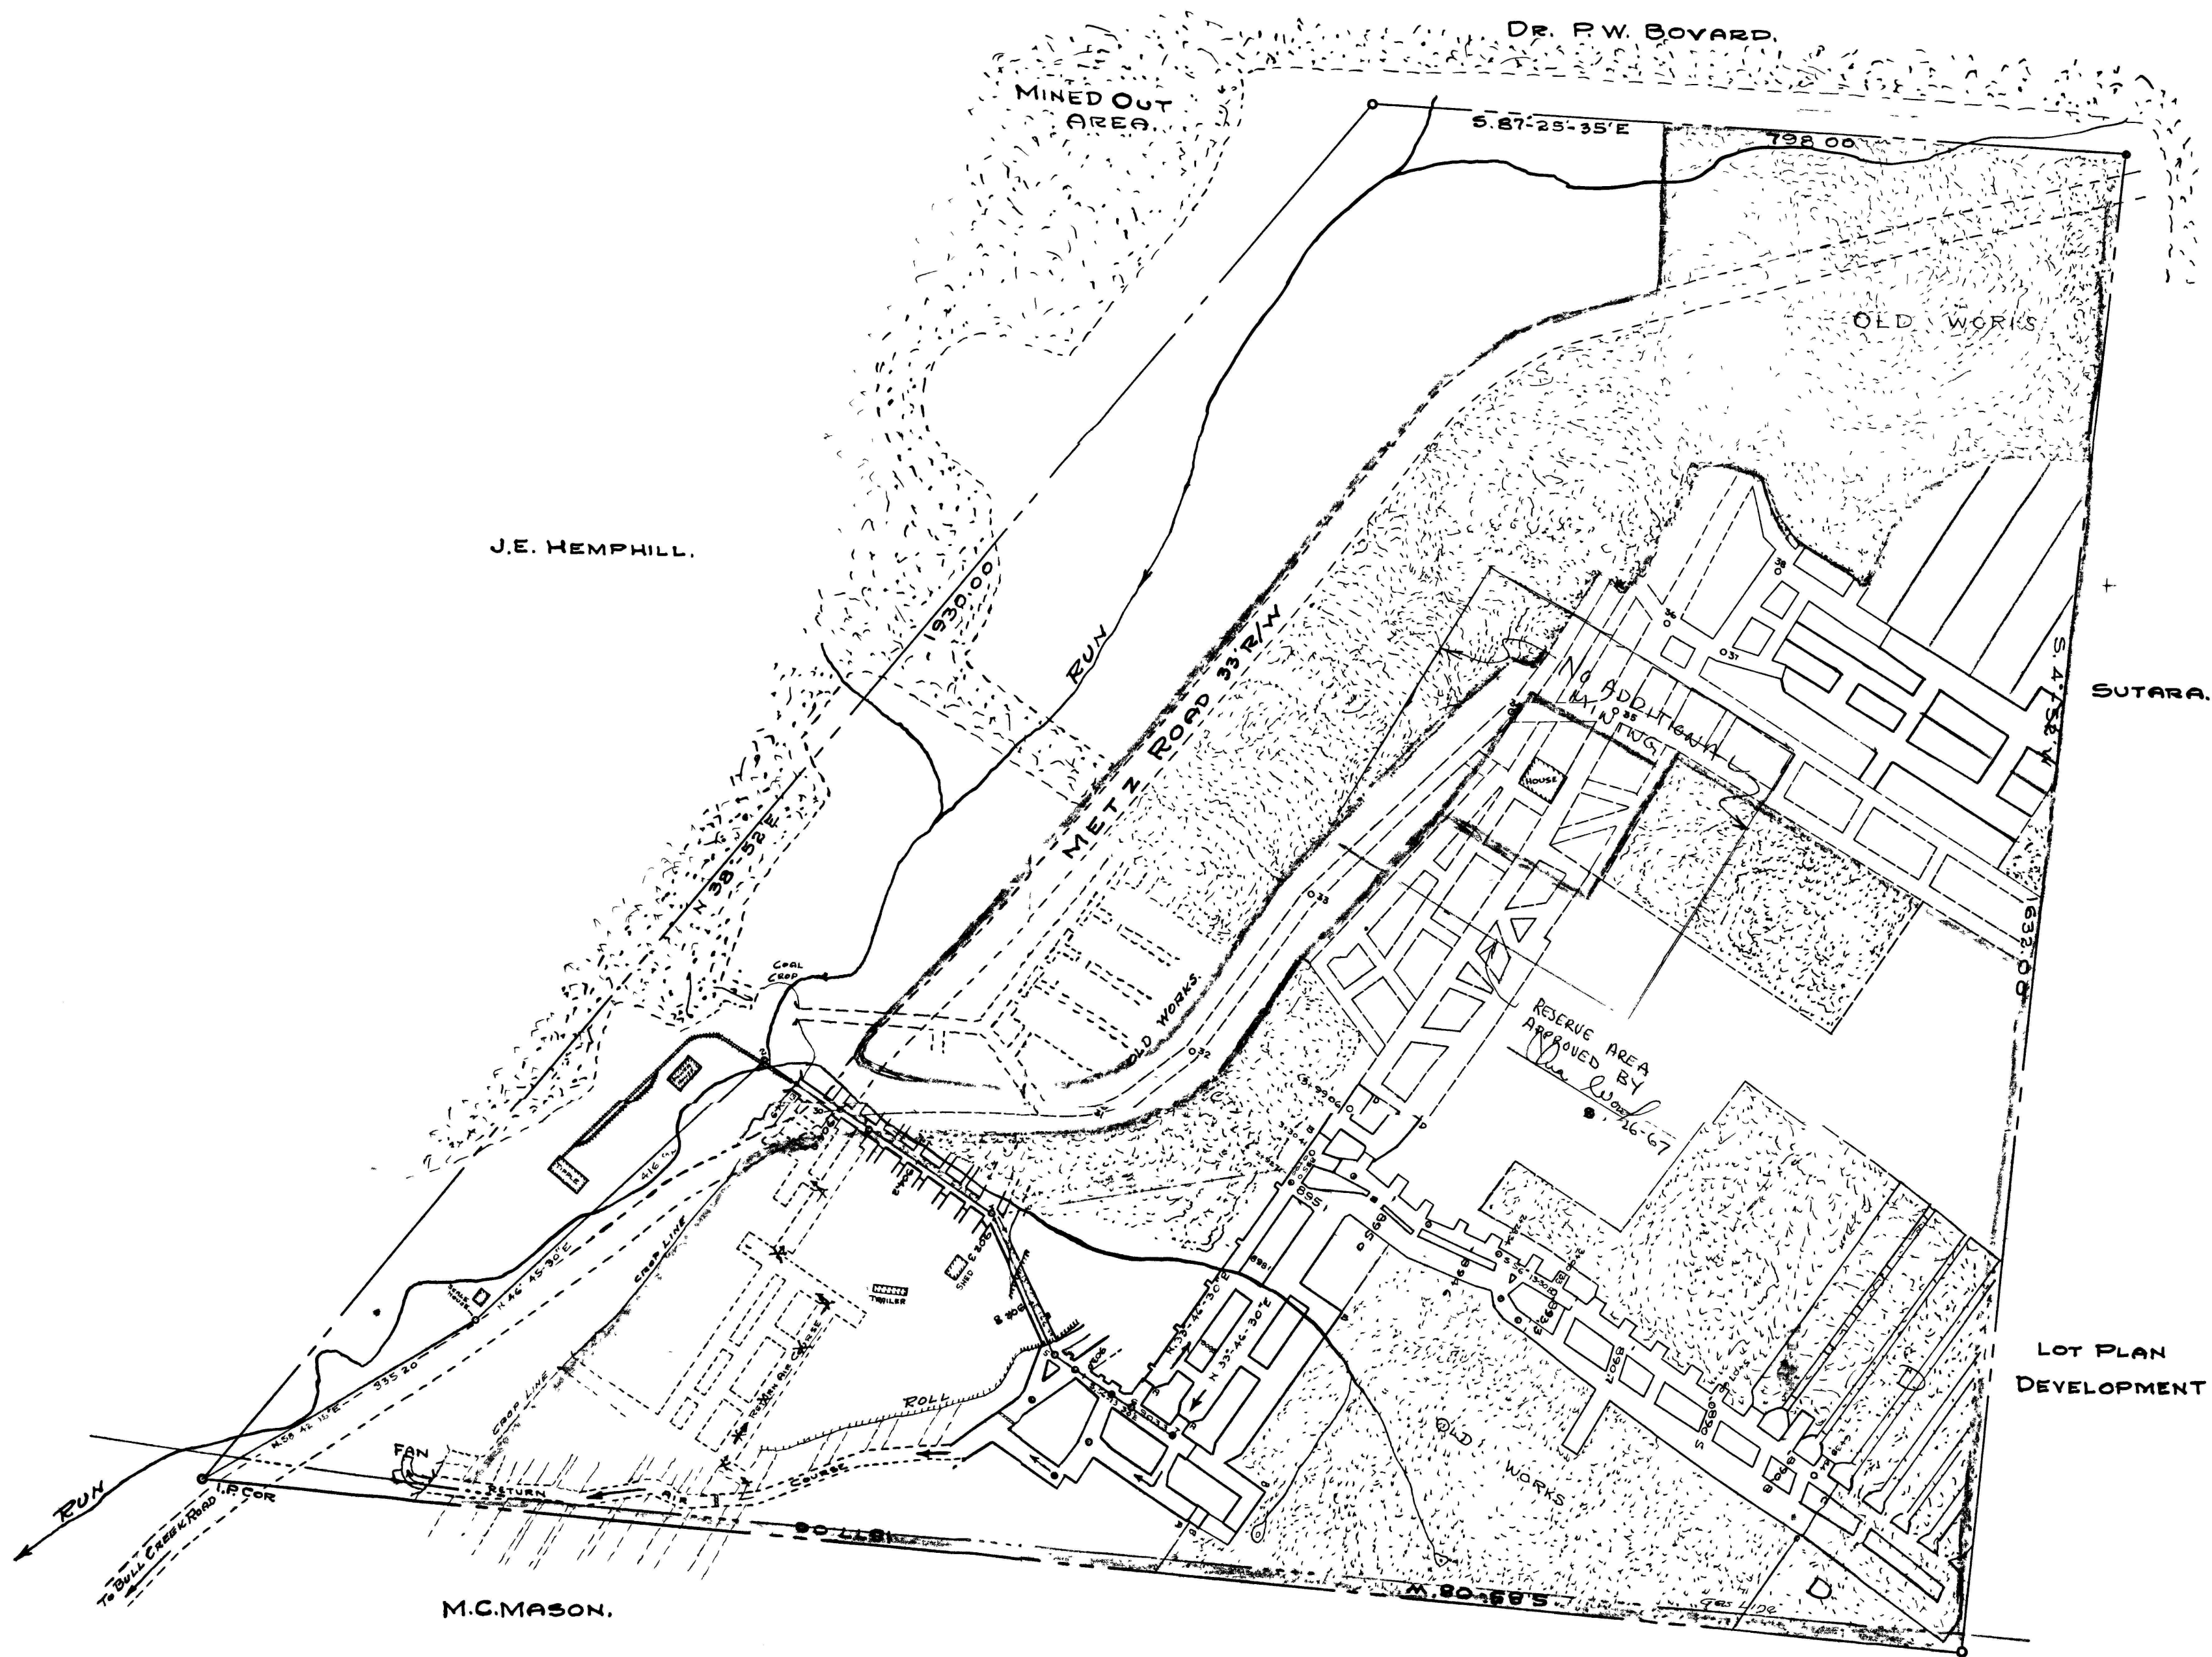

MINE MAP
IRA WOOD, COAL CO.
No 3 MINE.
SITUATE
FAWN TWP. ~ ALLEGHENY CO., PA.
SCALE 1"=100' JAN., 1, 1958.
W.L. PRESSAU, R.R.E. 8190 ~ CURTISVILLE, PA.

RED INDICATES COMPLETED AREA.

GREEN PROJECTED AREA TO BE MINED.

- RESERVE AREA - NO ADDITIONAL MINING