


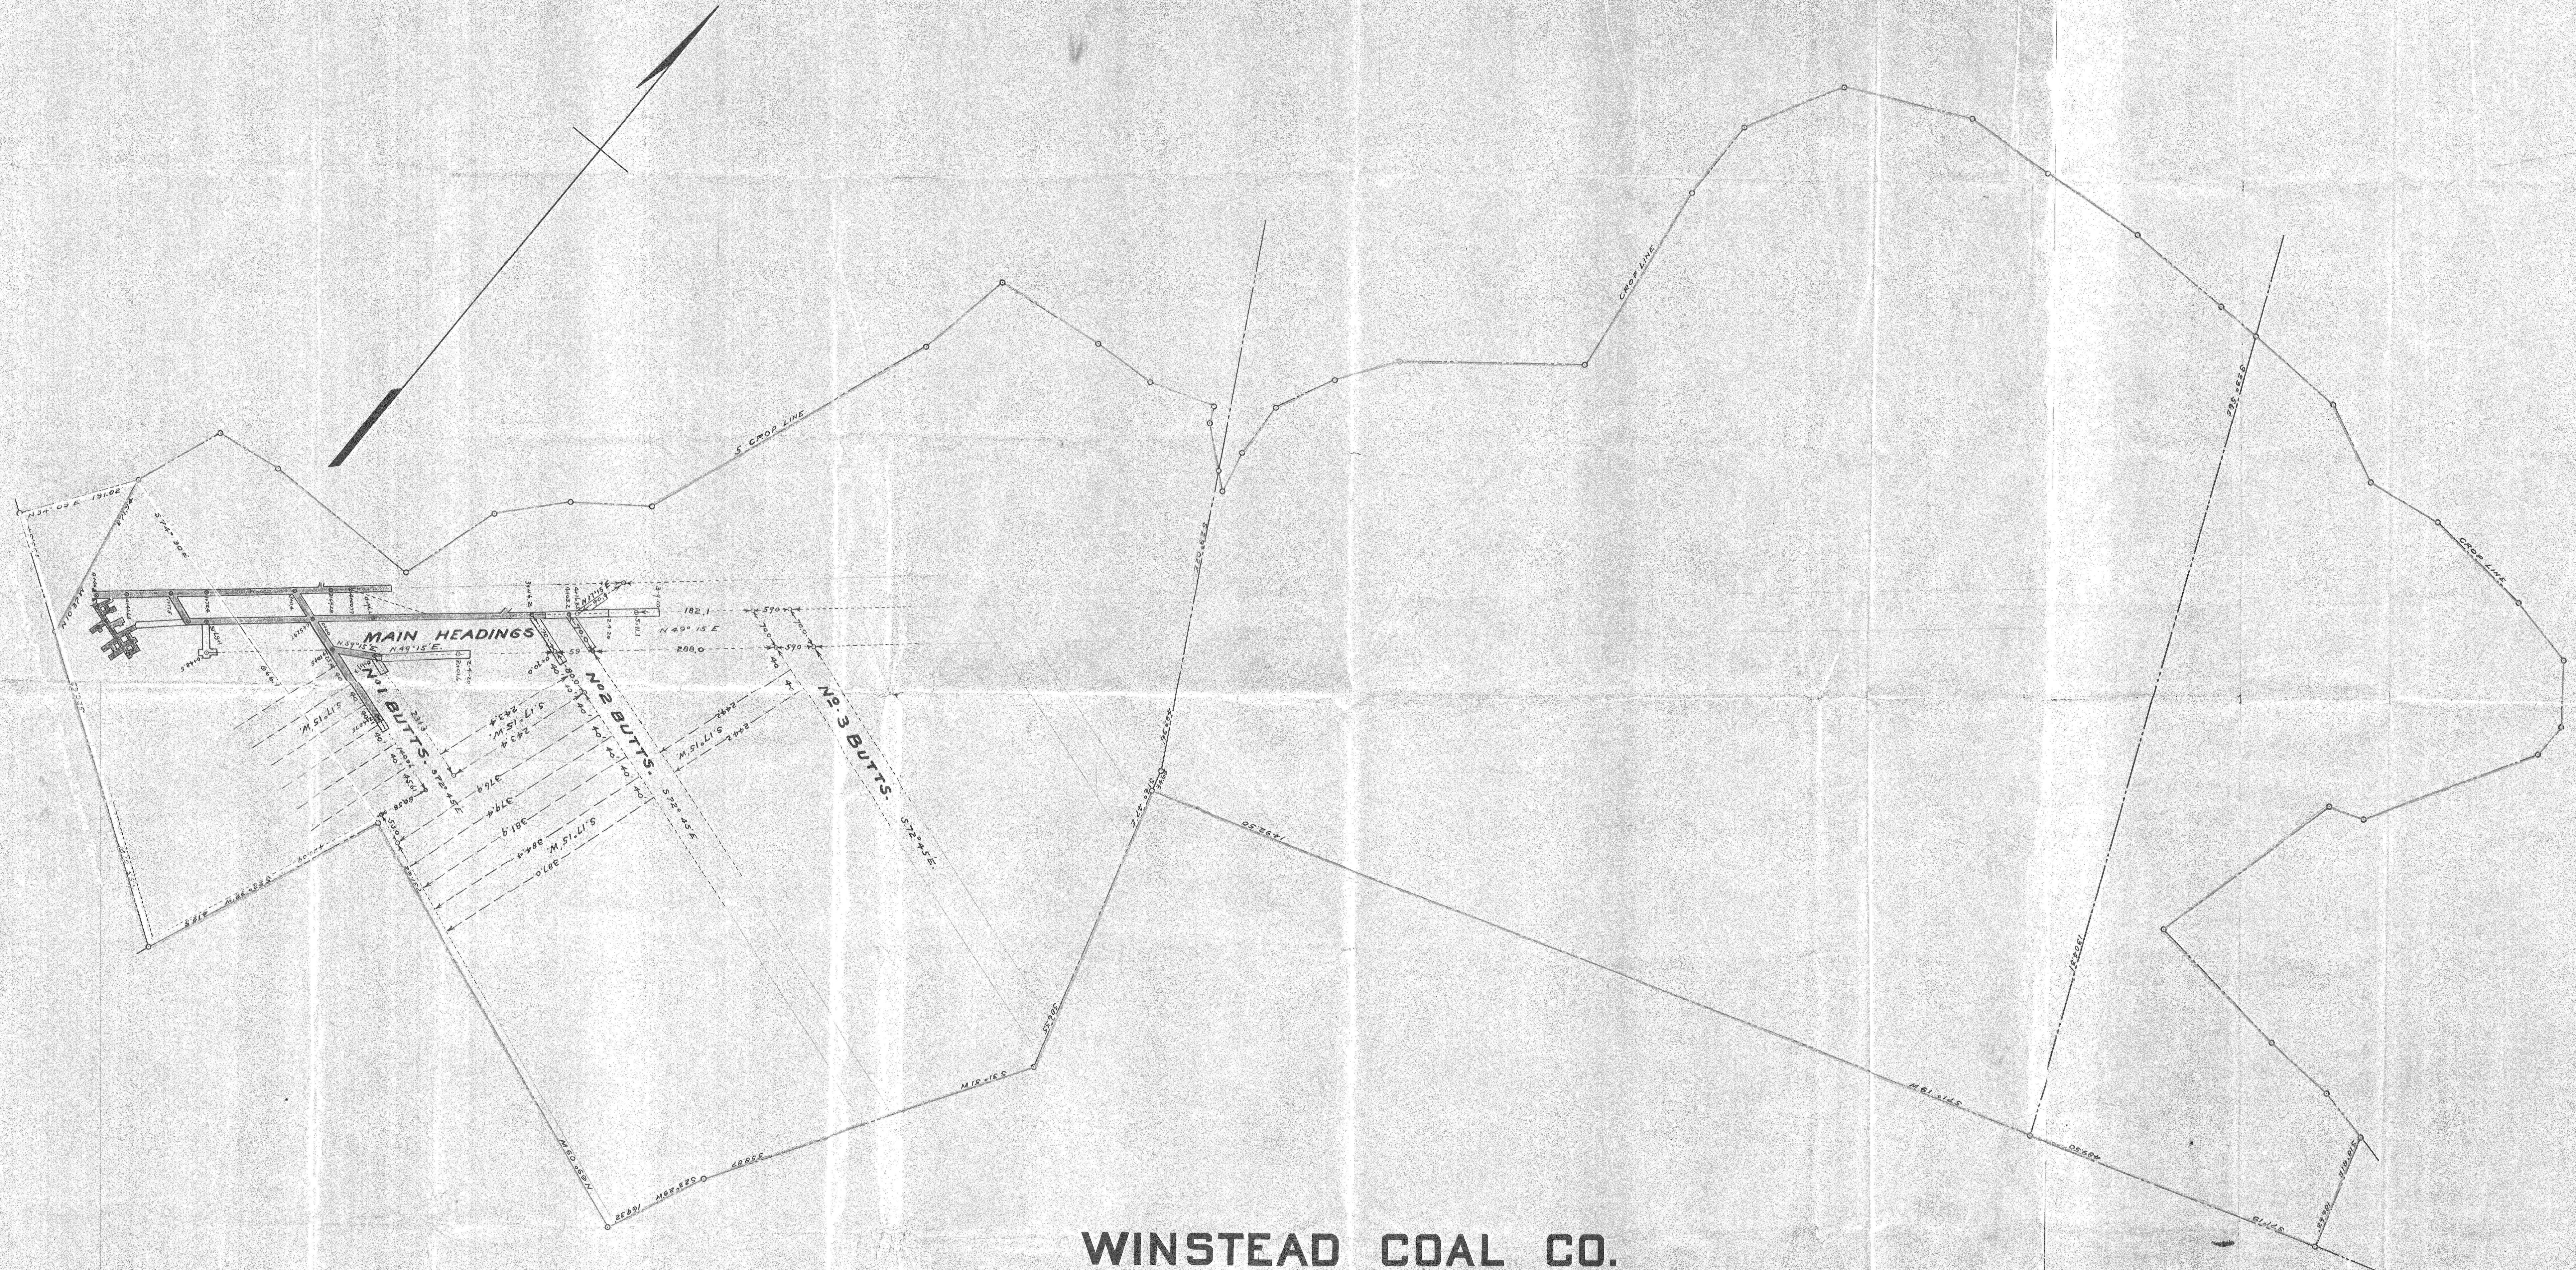

WINSTEAD COAL CO.

SITUATE IN
SPRINGHILL TOWNSHIP, FAYETTE CO., PA.

SCALE: 1"=100' JAN. 2, 1920

F. E. CO.