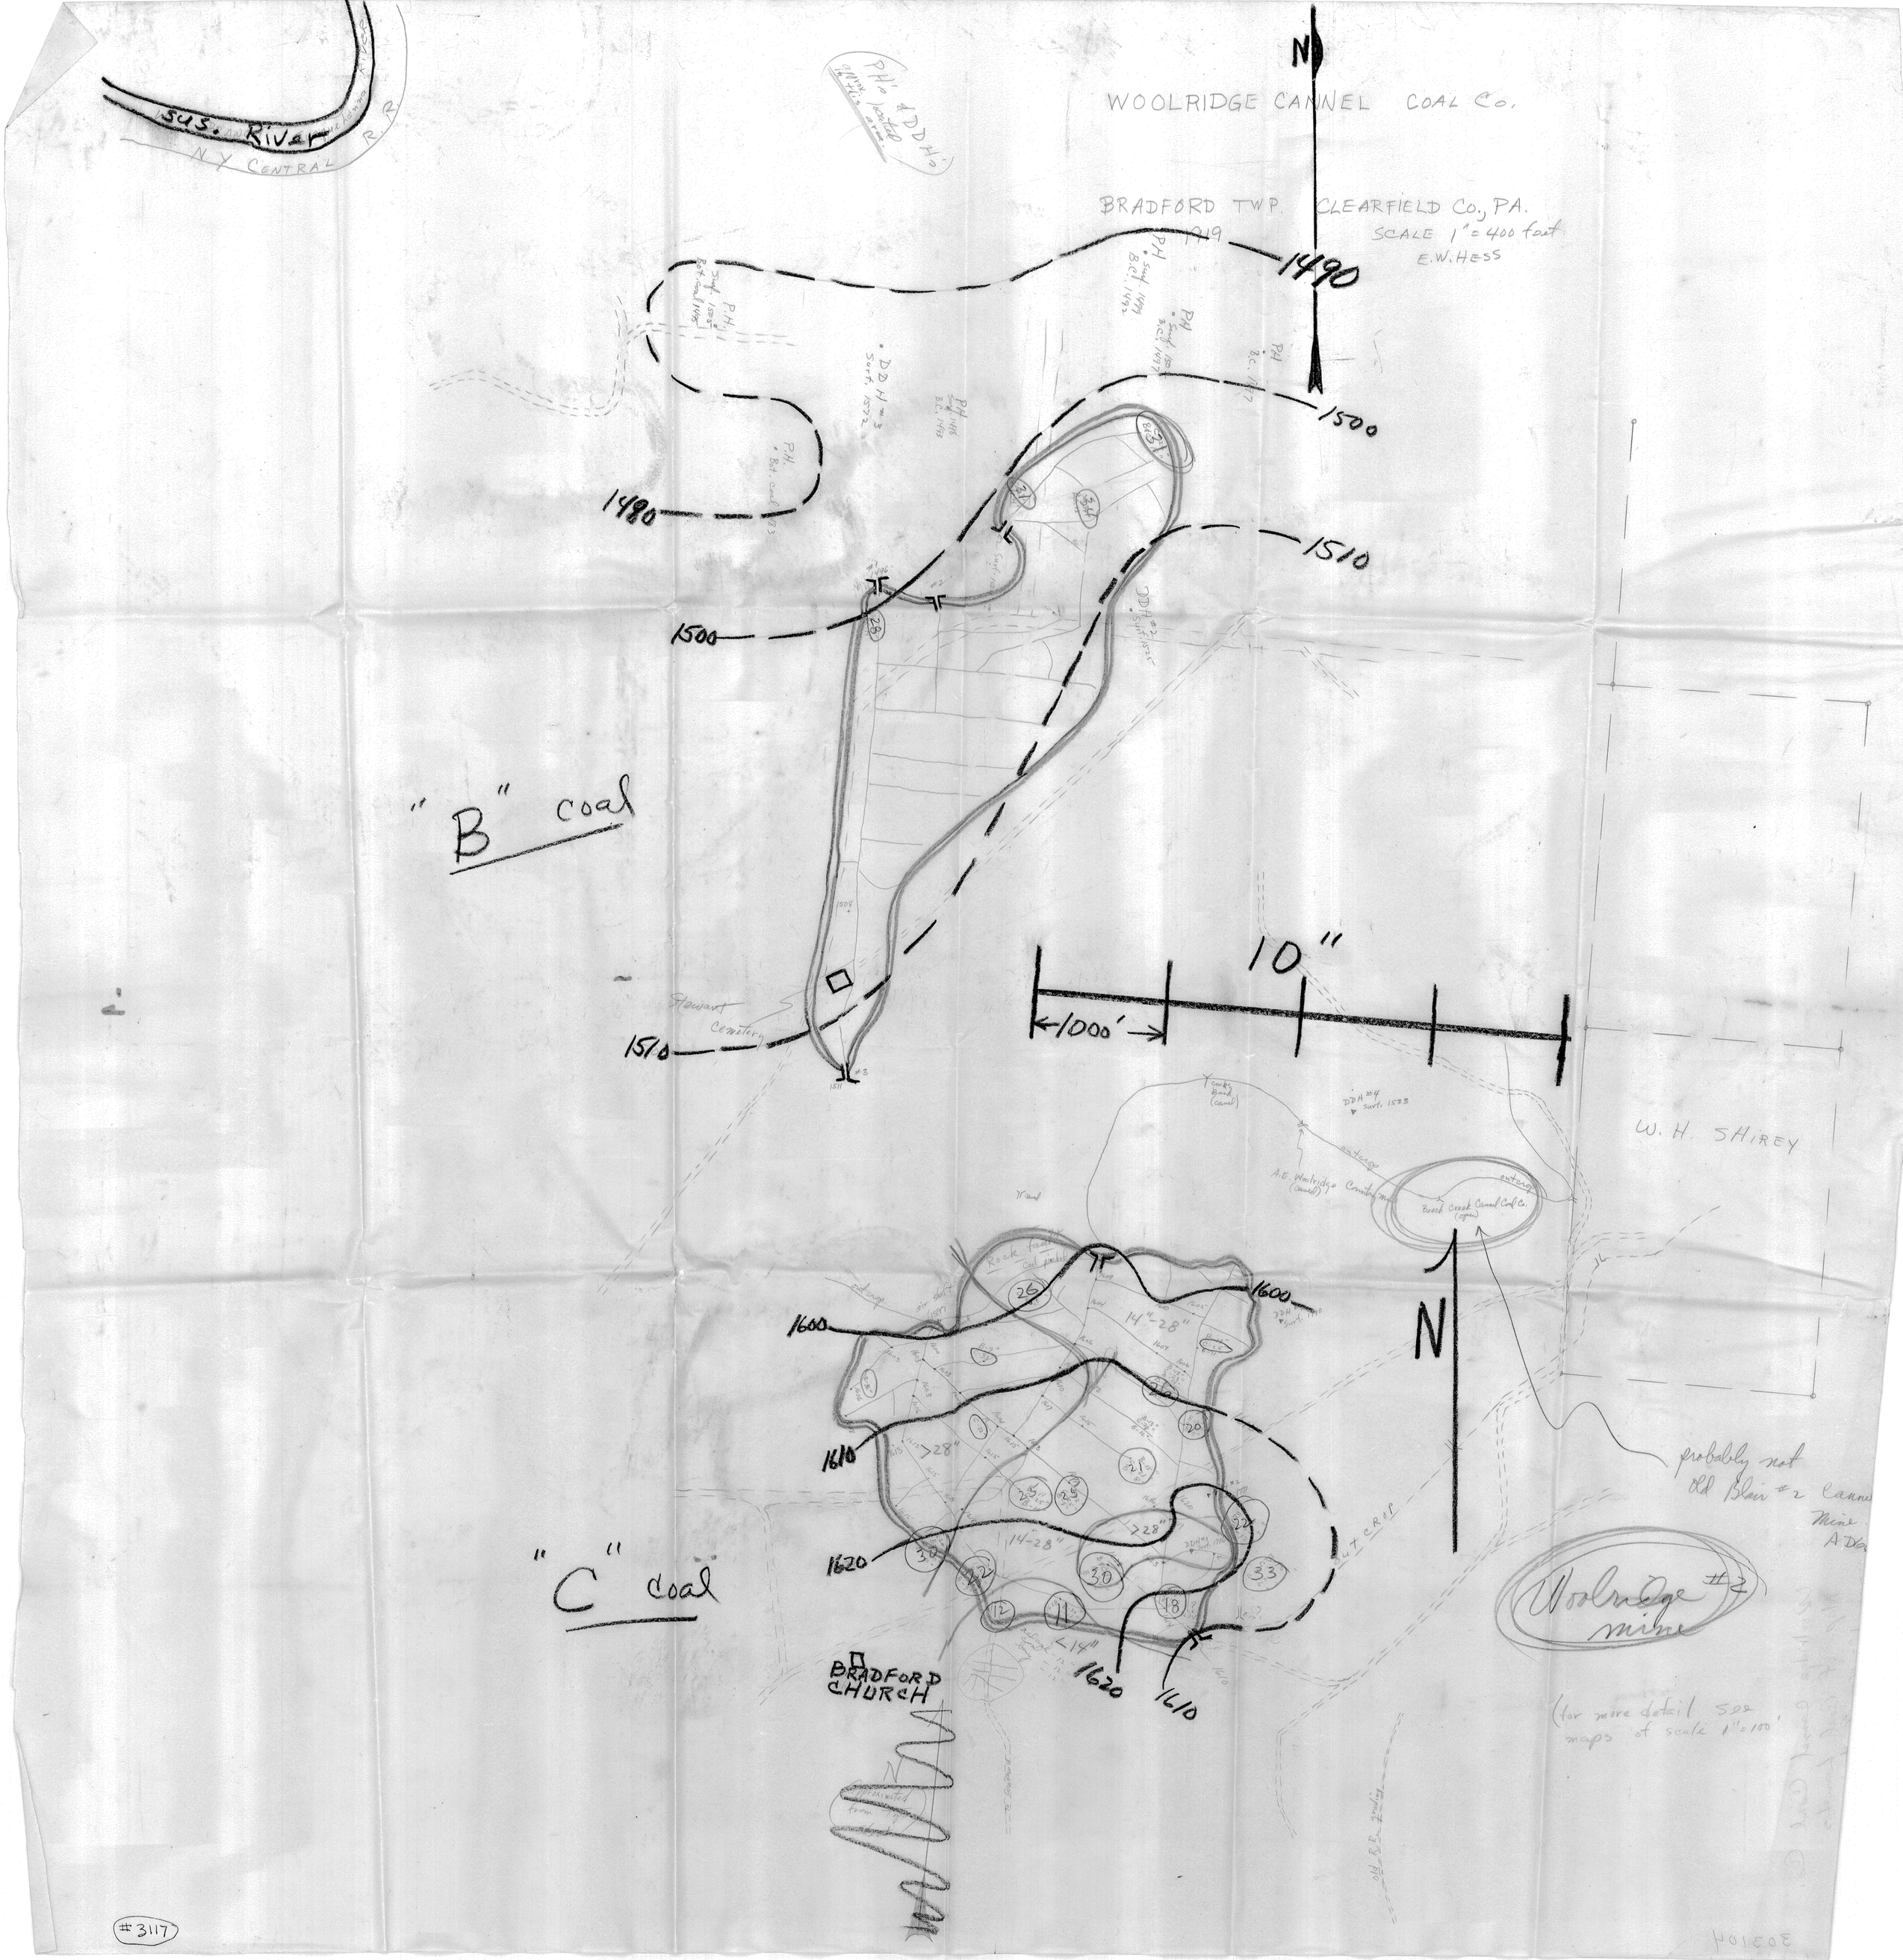

Sus. River
N.Y. CENTRAL R.R.
WOOLRIDGE CANNEL COAL Co.
BRADFORD TWP. CLEARFIELD Co., PA.
1919
SCALE 1" = 400 feet
E.W. HESS
N
1490
1500
1480
1510
1500
"B" coal
10"
1000'
1510
Stewart Cemetery
W.H. SHIREY
1600
1600
14"-28"
1610
>28"
1620
14-28"
>28"
<14"
1620
1610
"C" coal
BRADFORD CHURCH
OUTCROP
probably not Old Blair #2 Cannel Mine
Woolridge #2 mine
(for more detail see maps of scale 1" = 100'
#3117