


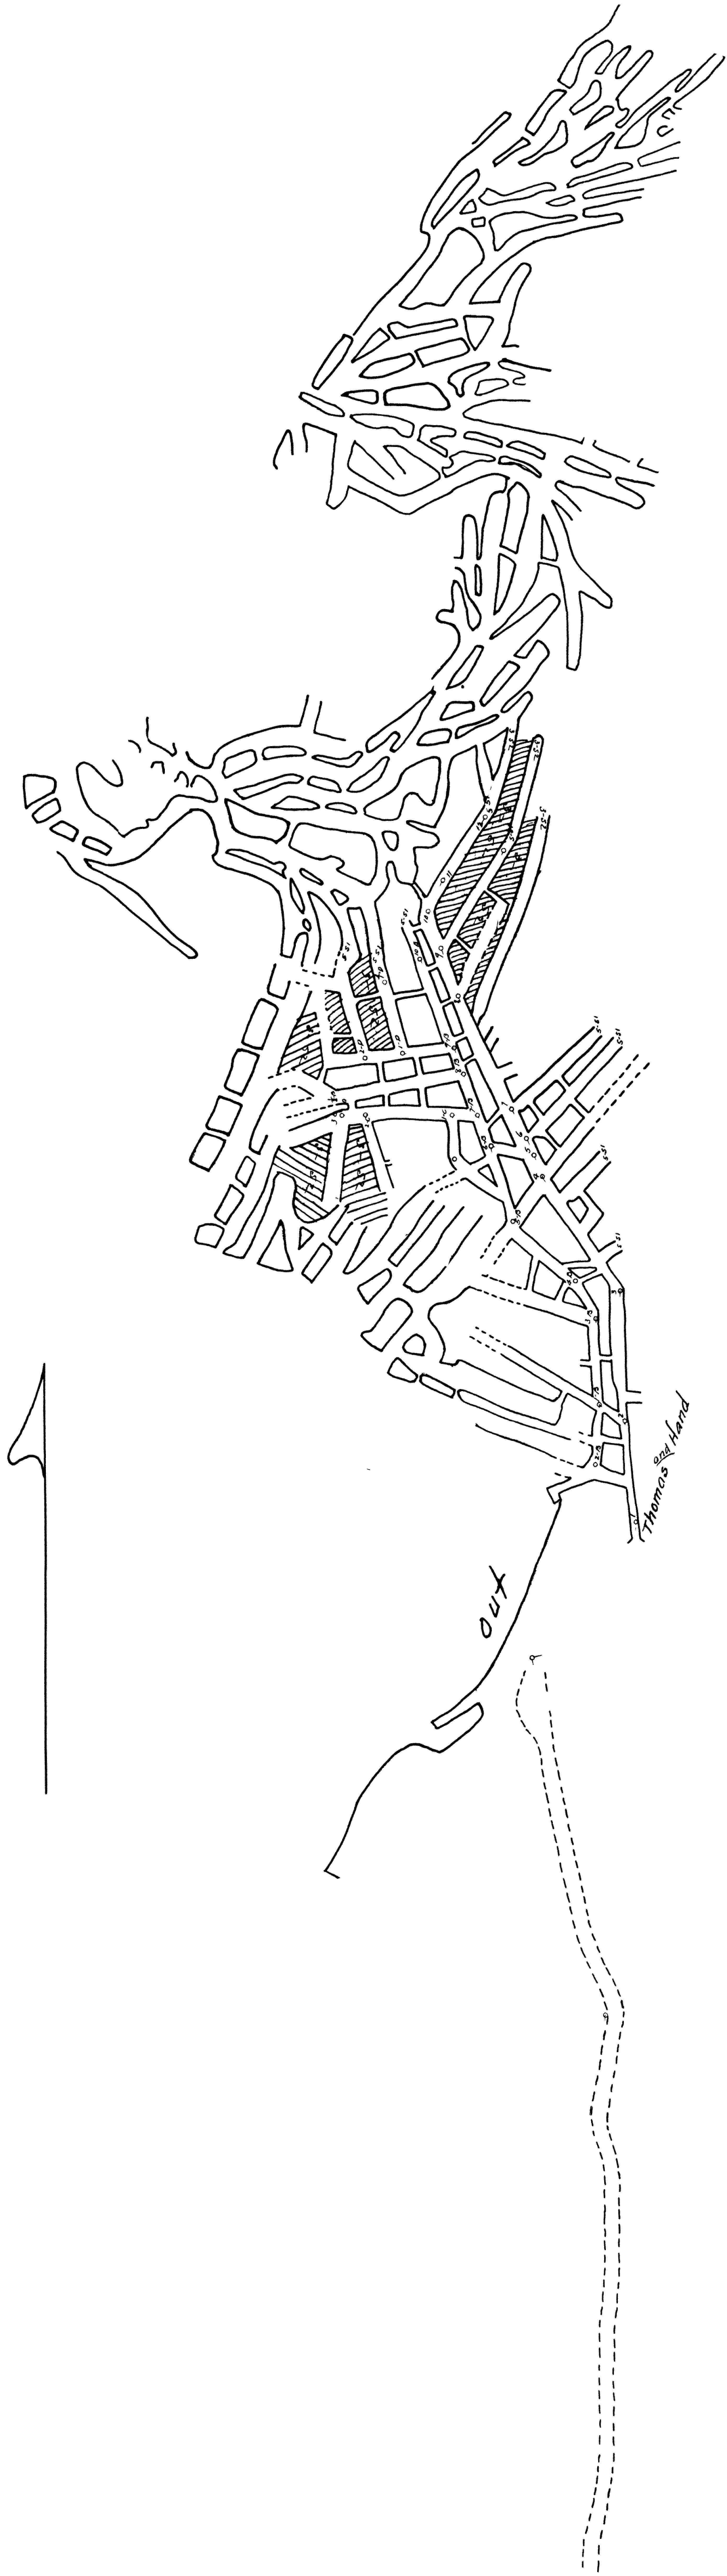

M A P
WRAYS HILL No. 1-MINE
SITUATED IN TODD TWP.
HUNTINGDON CO. PENNA.
Operated by Thomas and Land
1" = 100'