


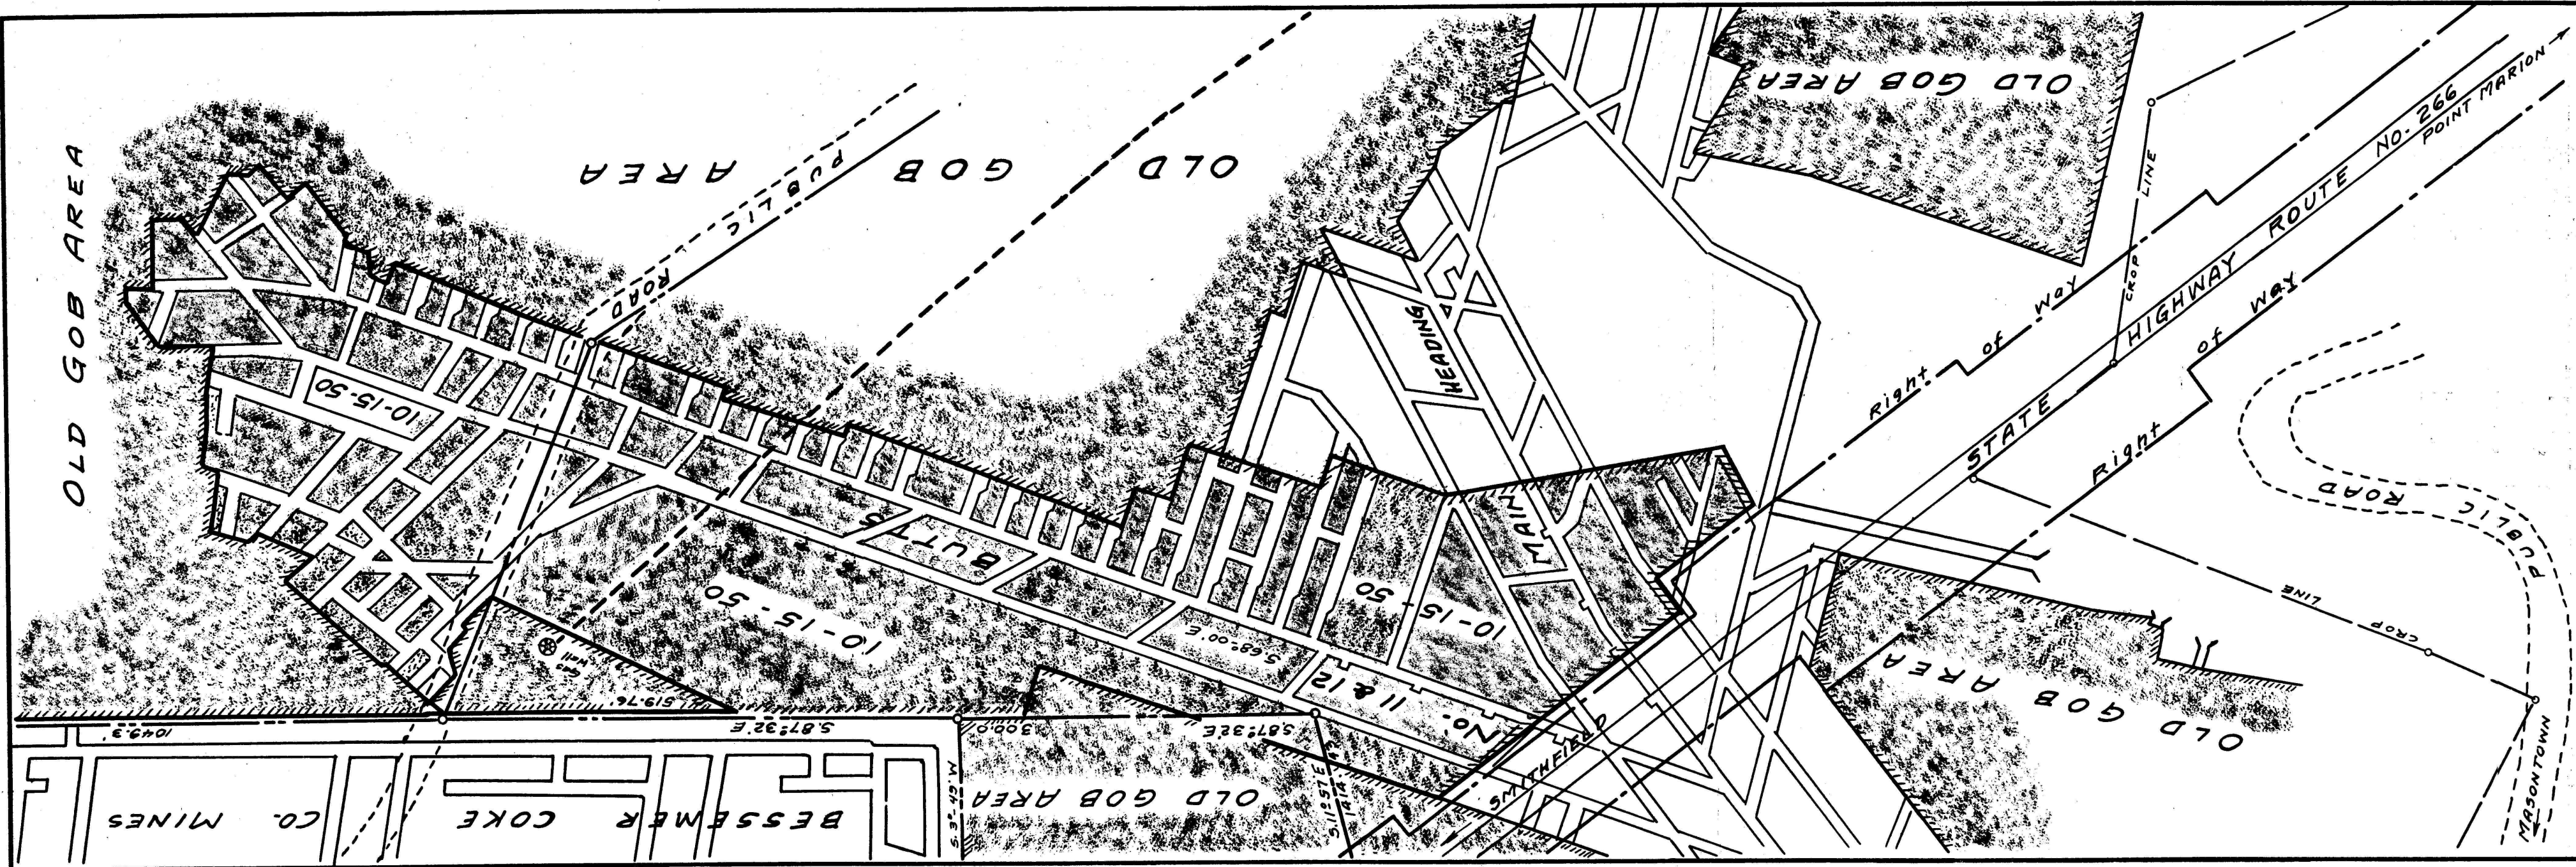

I, the undersigned, hereby certify that this map is a true and correct copy of a blue-print copy of a portion of the McKEEFY COAL COMPANY MINES, and that said blue-print copy is, to the best of my knowledge and belief, a true, complete, and correct map and survey of all the excavations made in this permanently abandoned section of said McKeefy Coal Co. Mine.

James M. Cubbage
Registered Surveyor.

MINE MAP

OF THE
"Y" COAL COMPANY

NICHOLSON TWP, FAYETTE CO., PA.

Scale - 1" = 100'

BEING A PORTION OF THE McKEEFY COAL
COMPANY MINES.

TRACED FROM BLUEPRINT NOV. 1, 1951
JAMES M. CUBBAGE, REG. SURVEYOR
POINT MARION, PA.