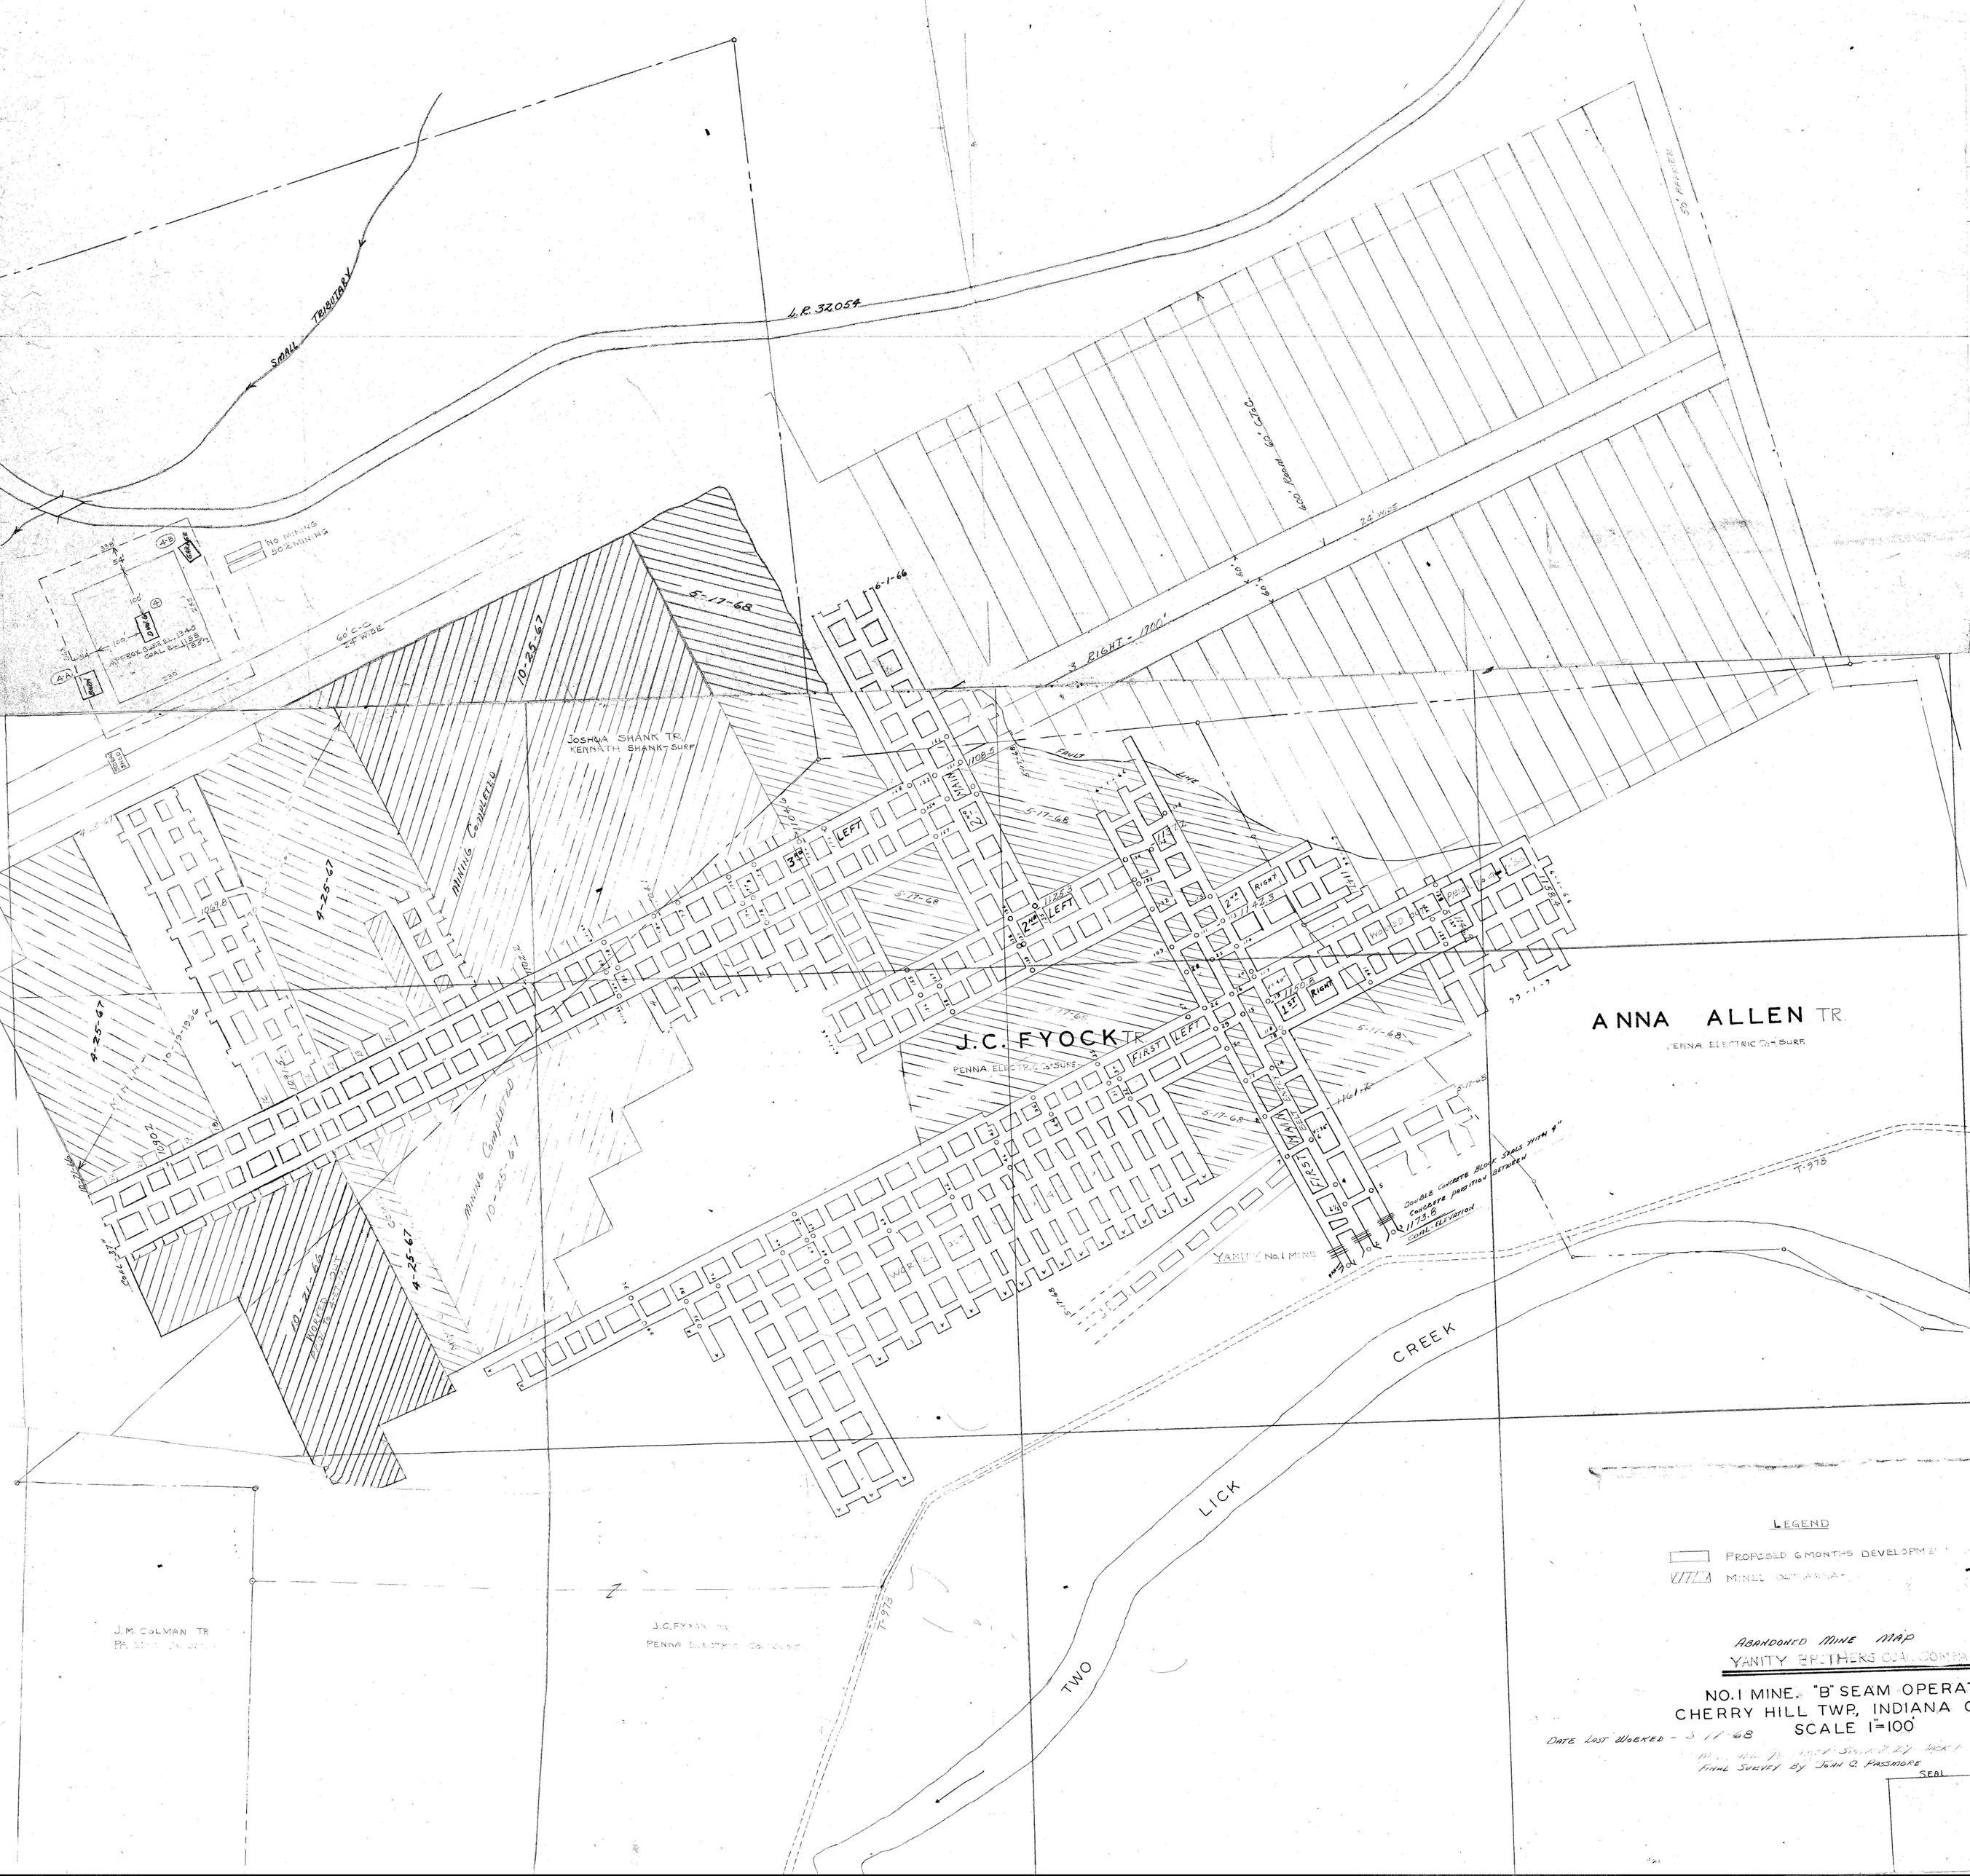
SMALL TRIBUTARY
L.R. 32054
No MINING
50' MINING
60' C-C
24' WIDE
APPROX. SURF. EL. 1240
COAL EL. 1155
5-17-68
10-25-67
6-1-66
JOSHUA SHANK TR.
KENNETH SHANK-SURF.
MINING COMPLETED
4-25-67
10-19-1966
J.C. FYOCK TR.
PENNA. ELECTRIC CO.-SURF.
MINING COMPLETED
10-25-67
WORKED OUT
PRIOR TO 1900
MAIN
FIRST LEFT
2ND LEFT
3RD LEFT
1ST RIGHT
2ND RIGHT
3RD RIGHT
FAULT LINE
RIGHT - 1900'
60' C-C
24' WIDE
50' BRIDGE
ANNA ALLEN TR.
PENNA. ELECTRIC CO.-SURF.
DOUBLE CONCRETE BLOCK SEALS WITH 4" CONCRETE PARTITION BETWEEN
1173.6
COAL ELEVATION
YANITY No. 1 MINE
T-978
CREEK
LICK
TWO
J.M. COLMAN TR.
PA. ELECTRIC CO.-SURF.
J.C. FYOCK TR.
PENNA. ELECTRIC CO.-SURF.
LEGEND
PROPOSED 6 MONTHS DEVELOPMENT
MINED OUT AREA
ABANDONED MINE MAP
YANITY BROTHERS COAL COMPANY
NO. 1 MINE. "B" SEAM OPERATION
CHERRY HILL TWP., INDIANA CO.
SCALE 1"=100'
DATE LAST WORKED - 5-17-68
FINAL SURVEY BY JOHN C. PARSMORE
SEAL