
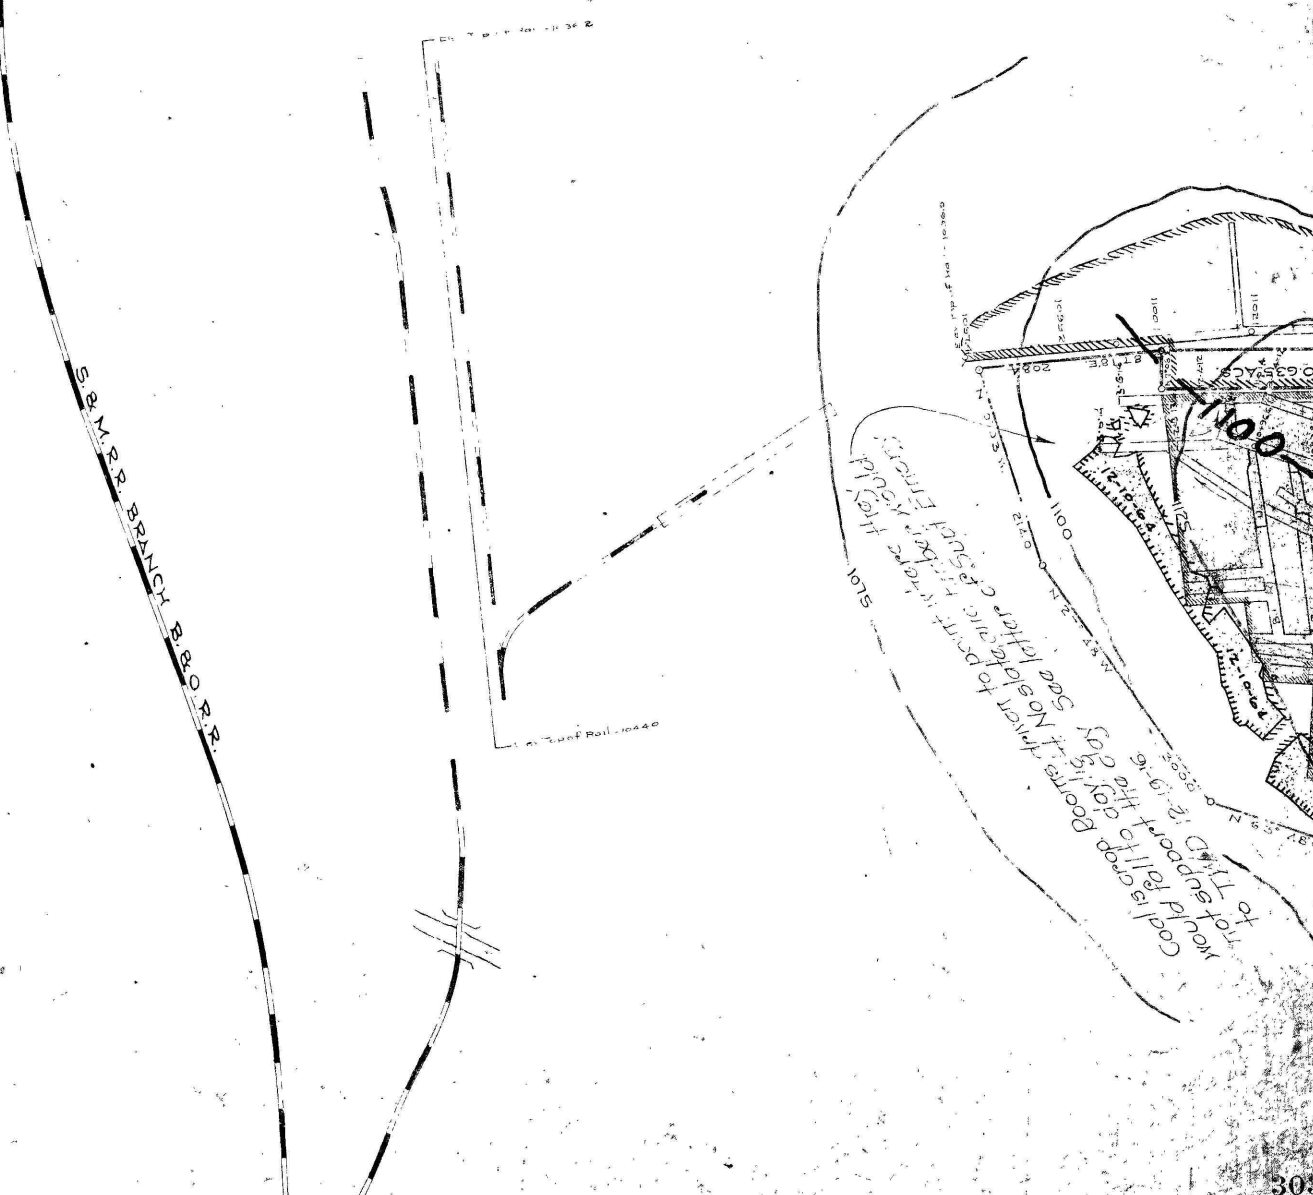


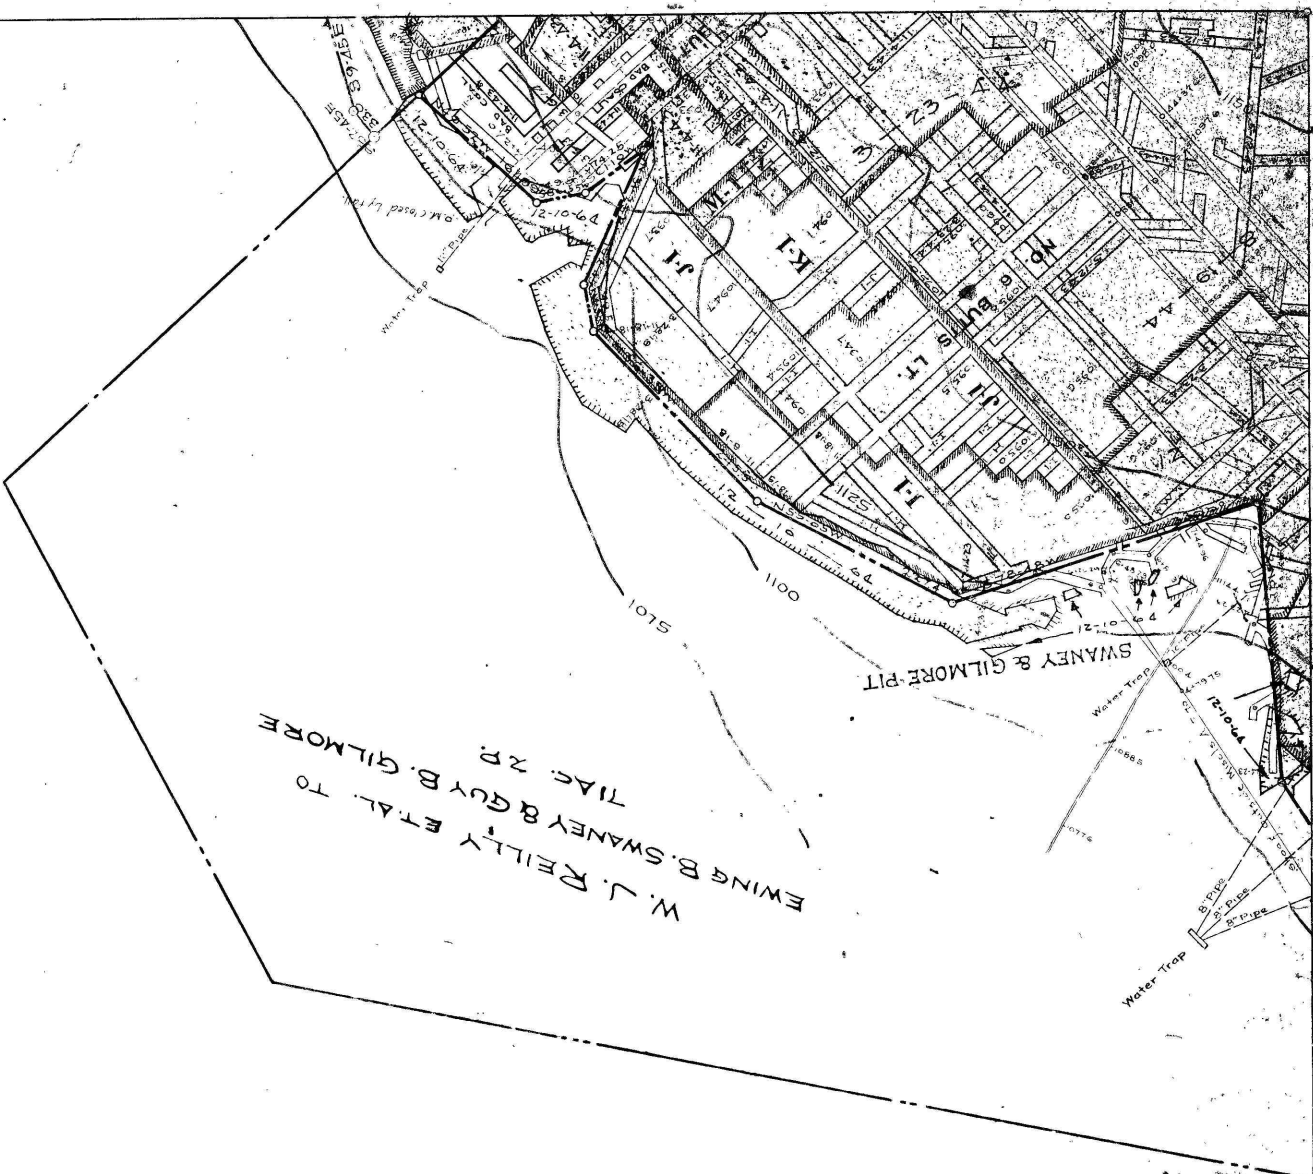

# YORK RUN NINE

**H. G. FRIEDMAN**

GEORGES TWP.

FAYETTE CO. PA.

DATUM OF LEVELS  
161 FEET BELOW MEAN TIDE AT SANDY HOOK.

SCALE 1 IN = 100 FT.

DATE OF LAST SURVEY \_\_\_\_\_

| DATE     | Squad |    | Position | Remarks | DATE     | Squad |    | Position | Remarks |
|----------|-------|----|----------|---------|----------|-------|----|----------|---------|
|          | BY    | BY |          |         |          | BY    | BY |          |         |
| 5-1-04   | A     | G  | W        | W       | 5-1-04   | A     | G  | W        | W       |
|          | B     |    |          |         |          | B     |    |          |         |
| 2-14-07  | C     |    |          |         | 2-23-22  | C     |    |          |         |
| 5-23-07  | E     |    |          |         | 4-13-23  | E     |    |          |         |
| 9-28-07  | F     |    |          |         | 9-22-23  | F     |    |          |         |
| 12-3-01  | G     |    |          |         | 3-3-24   | G     |    |          |         |
| 3-25-08  | H     |    |          |         | 4-7-24   | H     |    |          |         |
| 6-21-08  | I     |    |          |         | 5-28-25  | I     |    |          |         |
| 9-25-08  | J     |    |          |         | 9-28-25  | J     |    |          |         |
| 12-25-08 | K     |    |          |         | 3-27-26  | K     |    |          |         |
| 3-25-09  | L     |    |          |         | 3-28-27  | L     |    |          |         |
| 6-25-09  | M     |    |          |         | 9-25-27  | M     |    |          |         |
| 12-24-09 | N     |    |          |         | 11-27-28 | N     |    |          |         |
| 3-28-10  | O     |    |          |         |          | O     |    |          |         |
| 6-28-10  | P     |    |          |         |          | P     |    |          |         |
| 9-28-10  | Q     |    |          |         |          | Q     |    |          |         |
| 12-24-10 | R     |    |          |         |          | R     |    |          |         |
| 3-24-11  | T     |    |          |         |          | T     |    |          |         |
| 6-24-11  | F     |    |          |         |          | F     |    |          |         |
| 9-24-11  | V     |    |          |         |          | V     |    |          |         |
| 12-24-11 | W     |    |          |         |          | W     |    |          |         |
| 3-25-12  | X     |    |          |         |          | X     |    |          |         |
| 6-25-12  | Y     |    |          |         |          | Y     |    |          |         |
| 9-20-12  | Z     |    |          |         |          | Z     |    |          |         |

