


A. M I N I C H.

R E I D
AND
H O W L E Y.

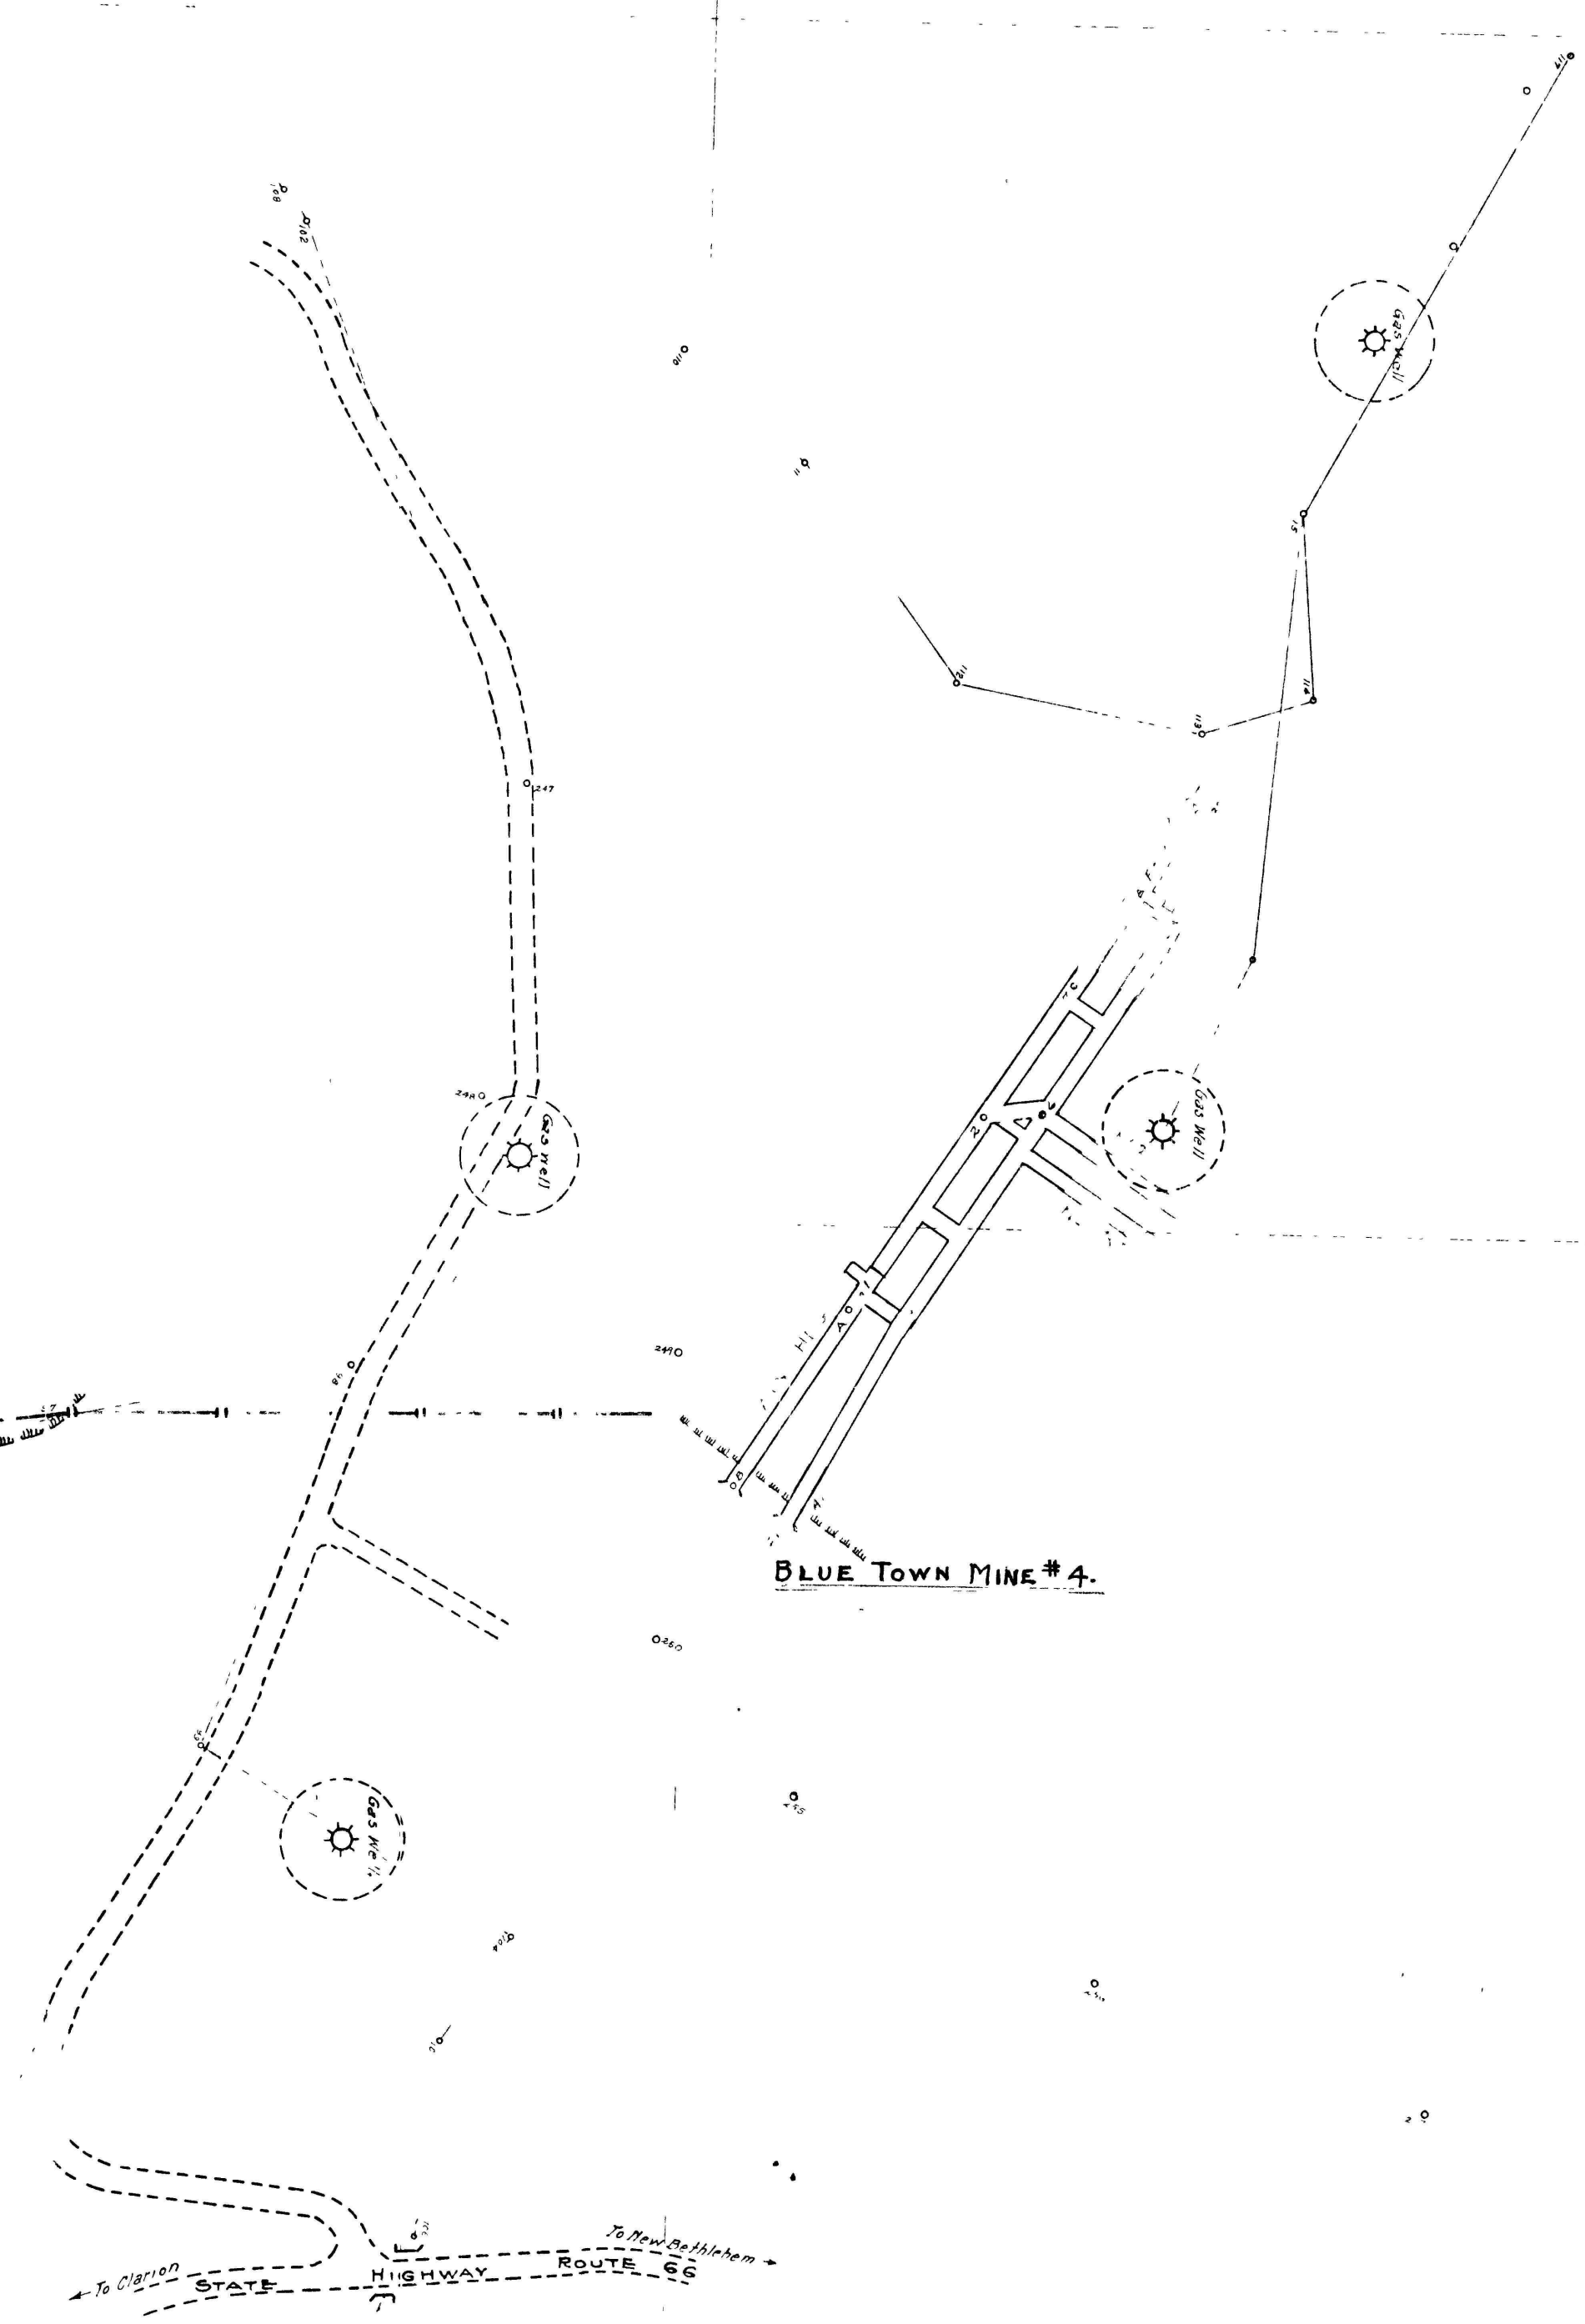

HAY COAL CO.
BLUE TOWN MINE (Leasure Run Mine)
BLUE TOWN COAL CO.
EVANS TRUCKING CO.-OPERATOR.
S.R. New Bethlehem, Pa.