



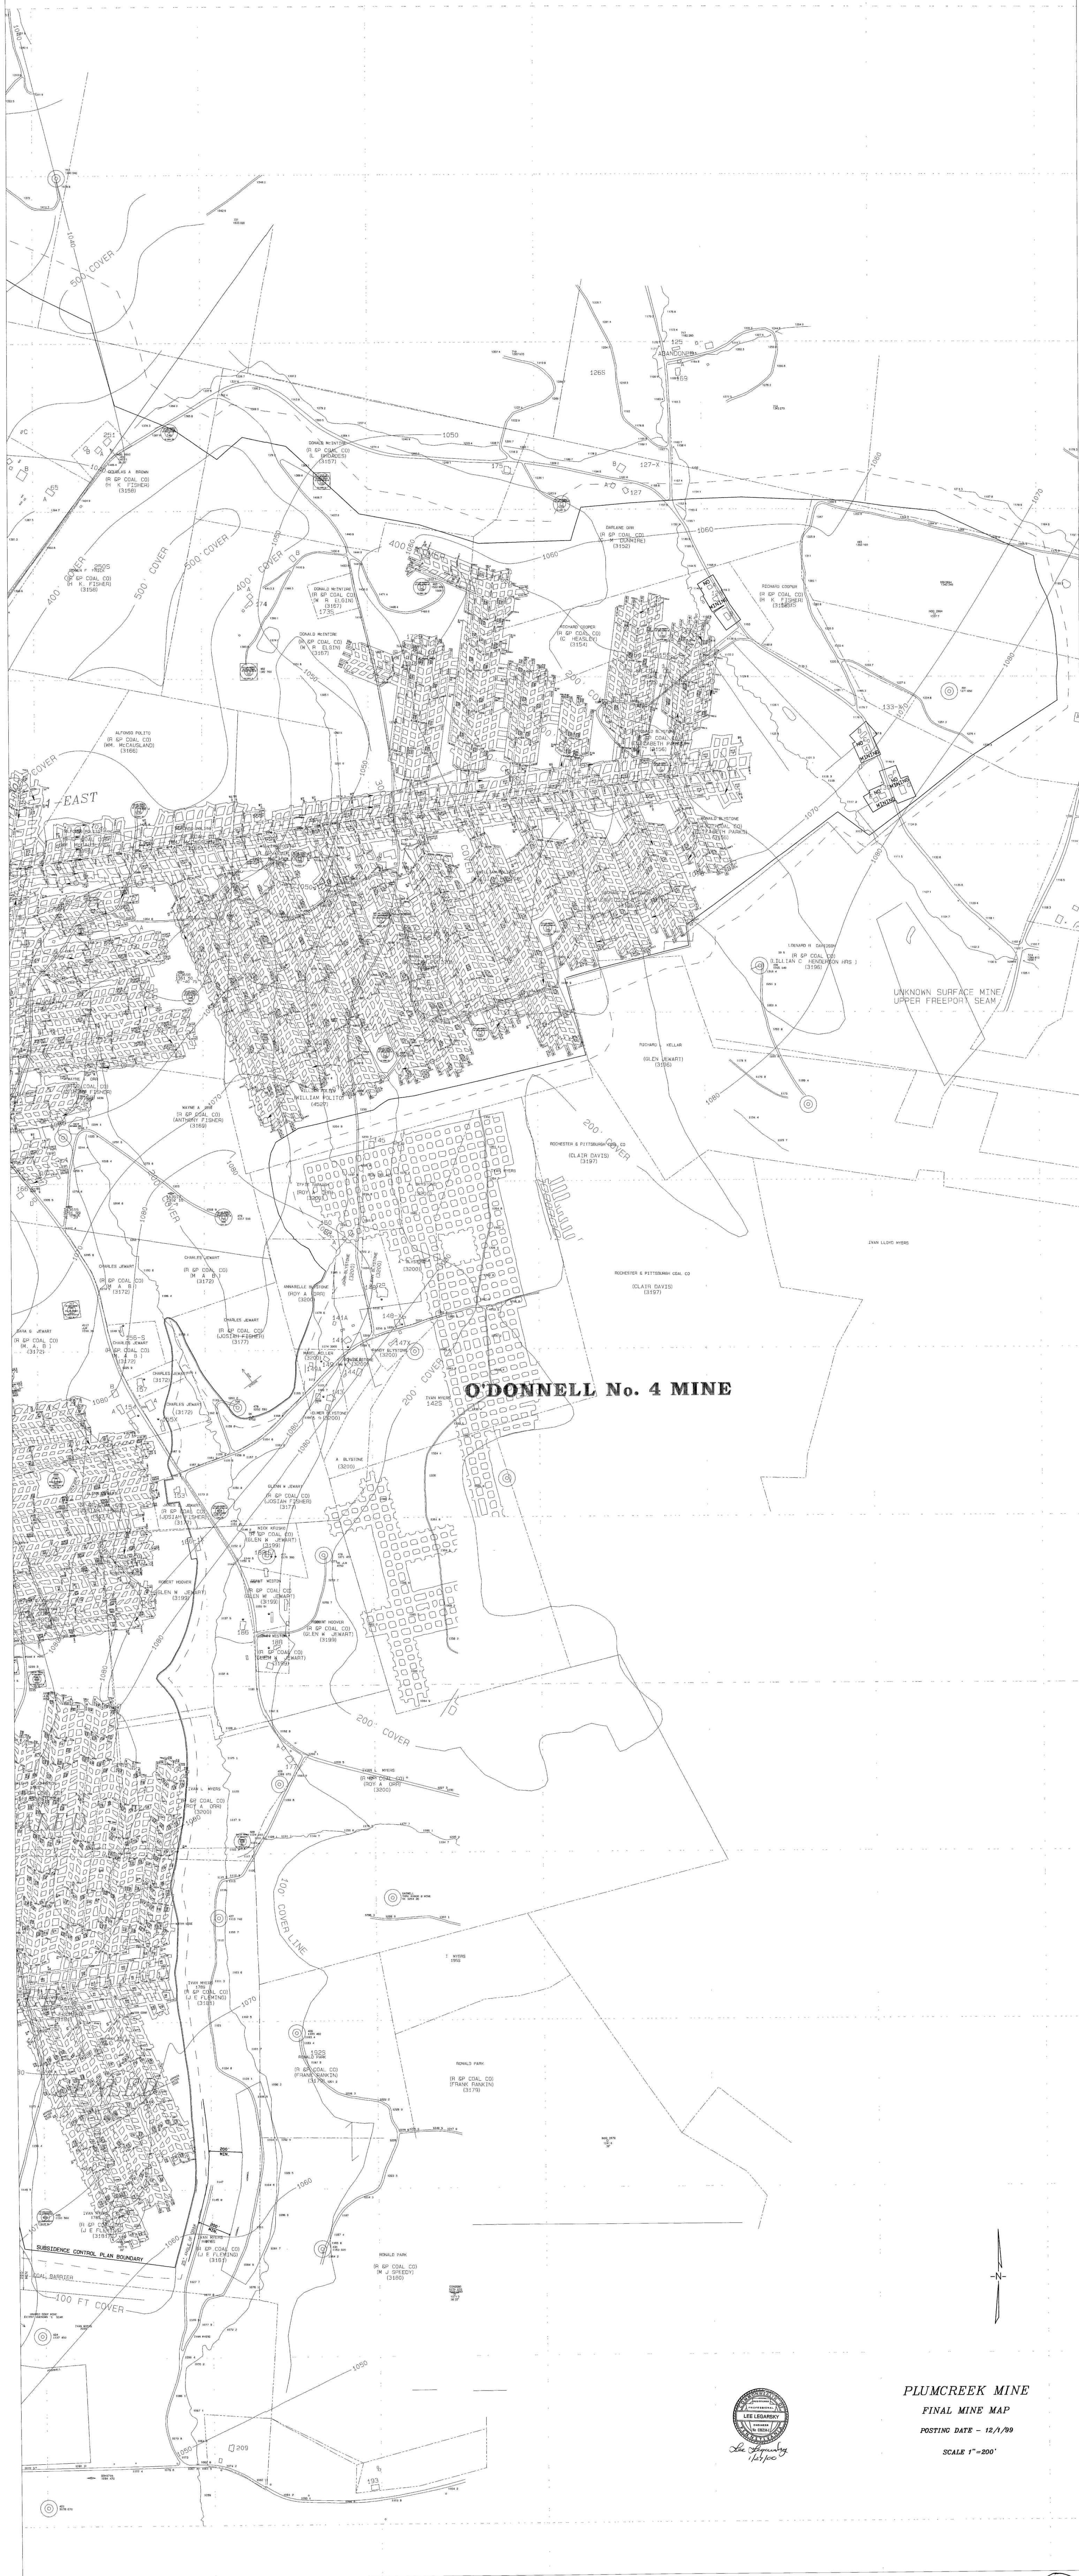

O'DONNELL No. 4 MINE

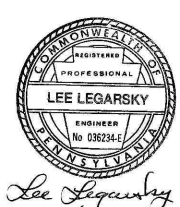

PLUMCREEK MINE
FINAL MINE MAP
POSTING DATE - 12/1/99
SCALE 1"=200'