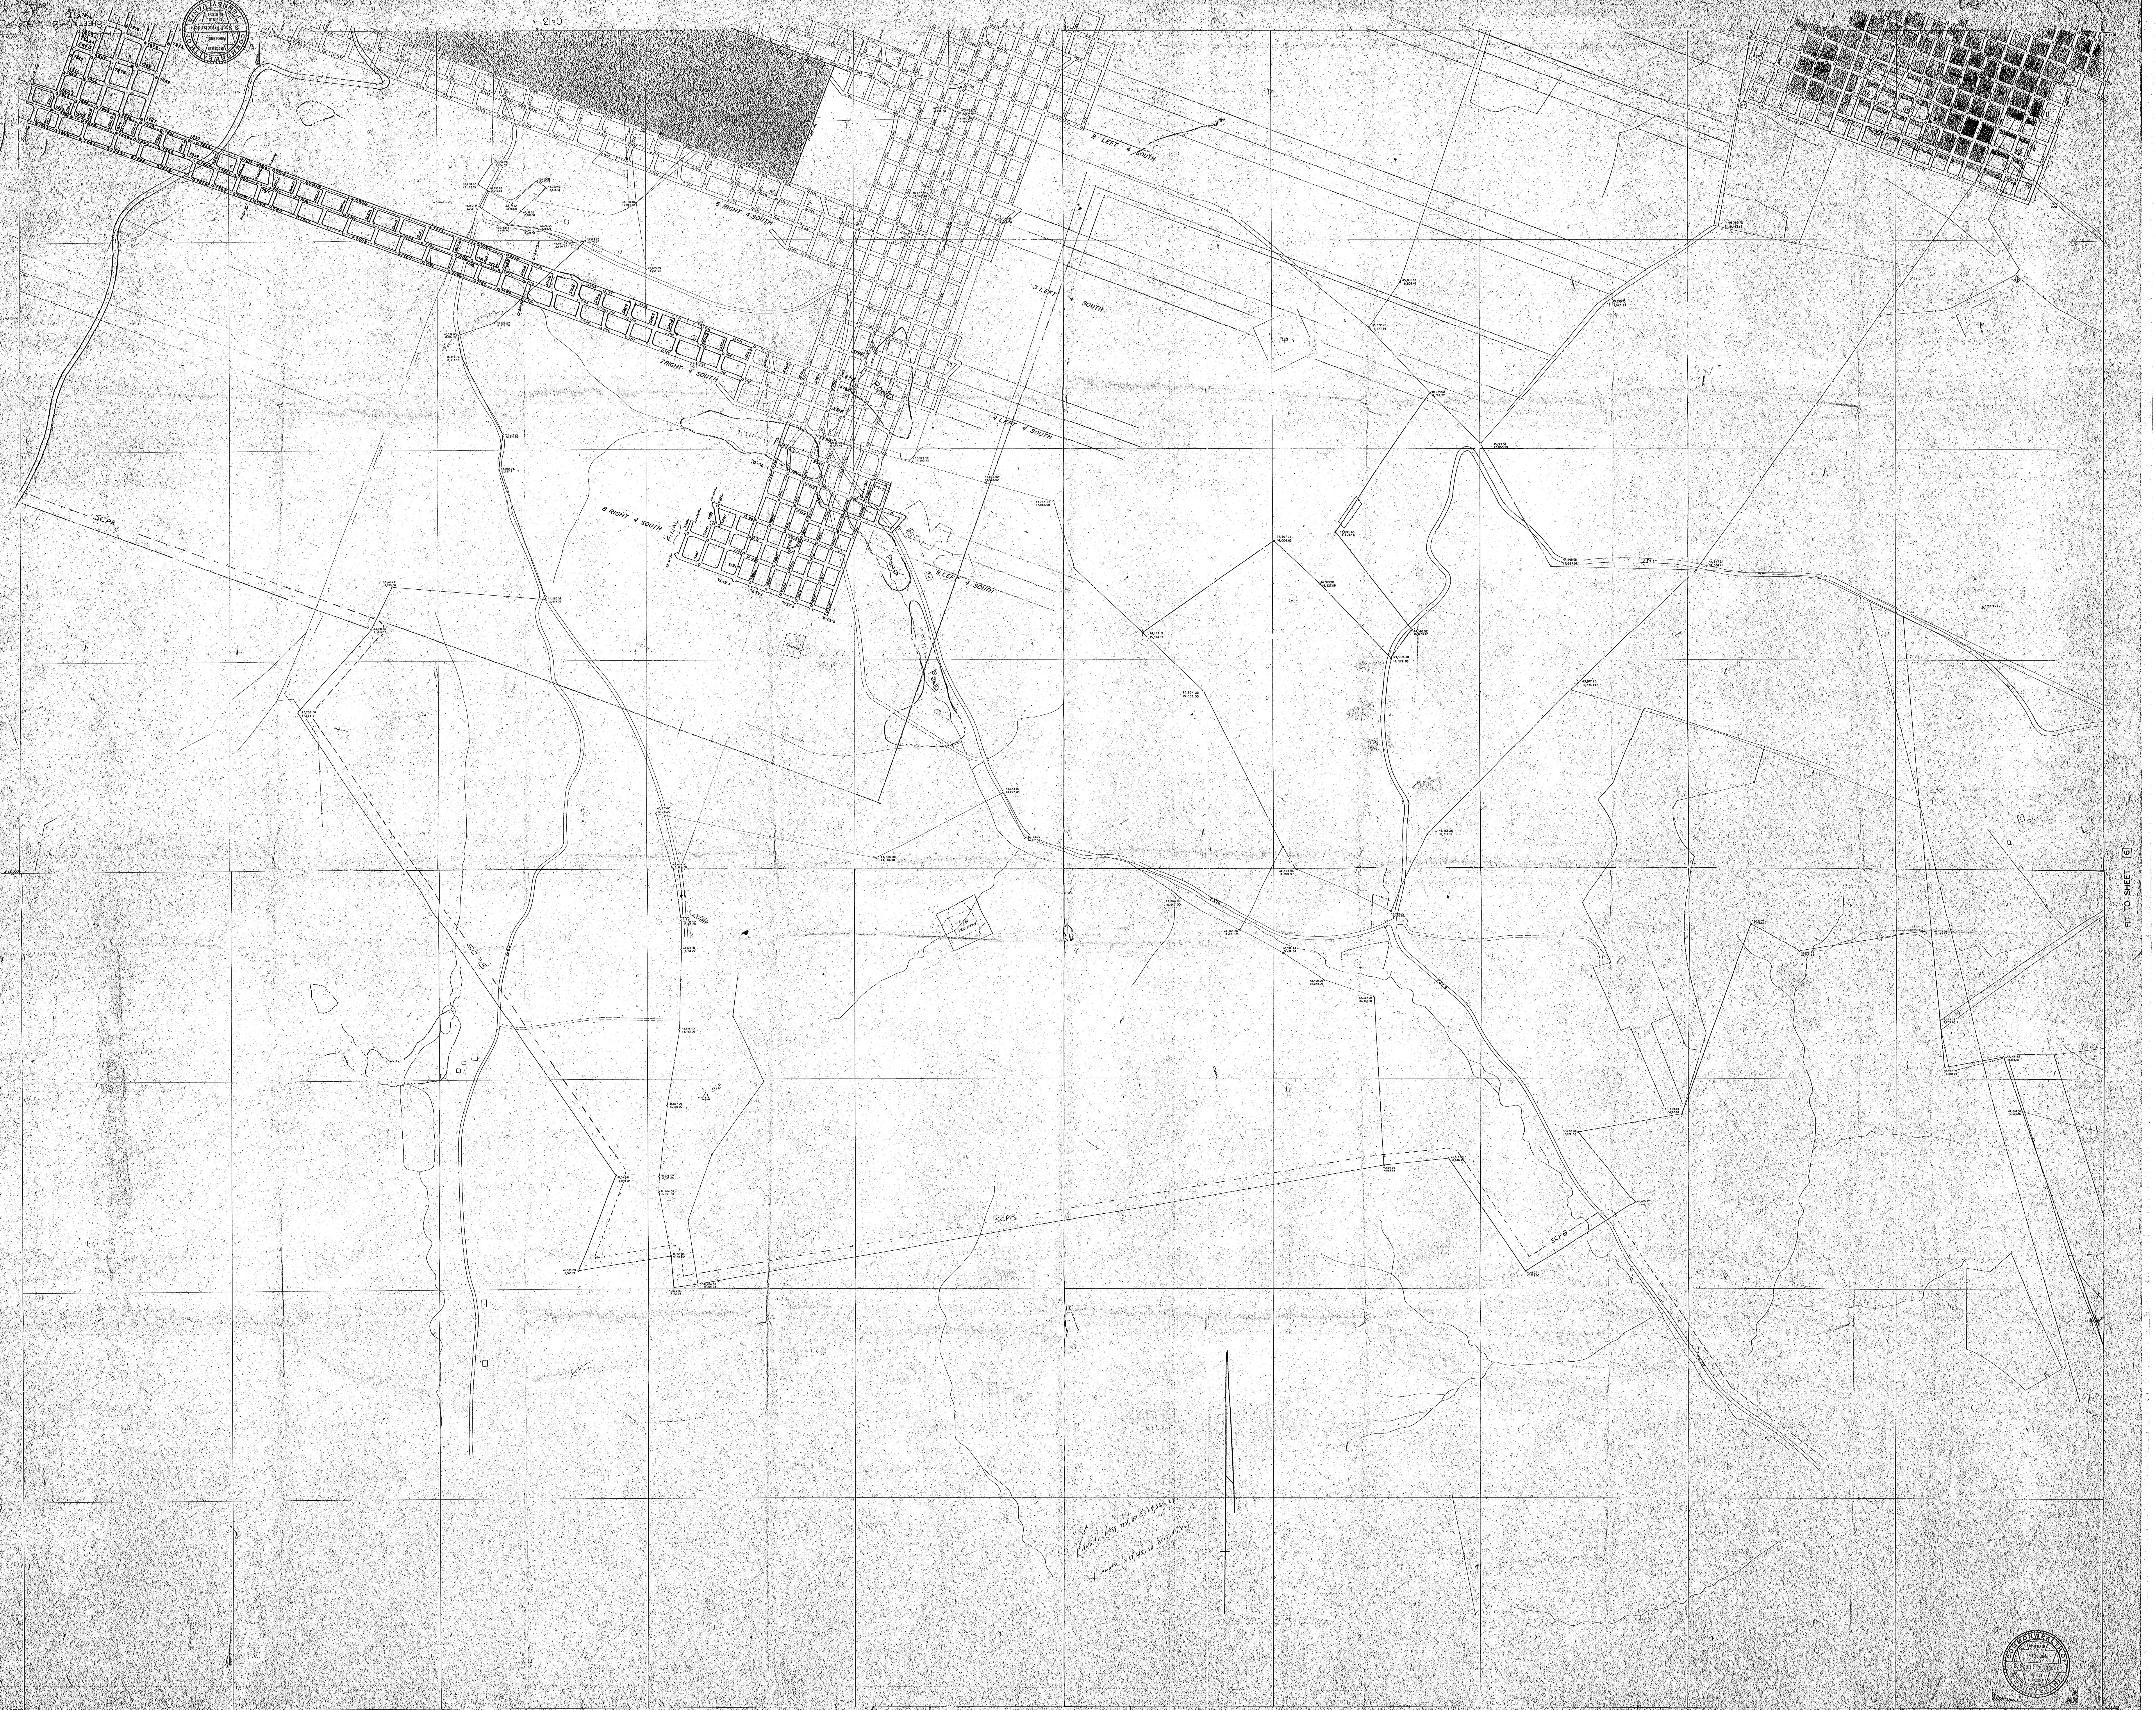

AND #1 (N.39,724.37 E.15,066.29)
AND #2 (N.39,613.68 E.15,146.86)

S. Scott Friedlander
ENGINEER NO. 30215-E

DUQUESNE LIGHT CO.
COAL DEPT. WAR. NO. 3 SHEET 10