


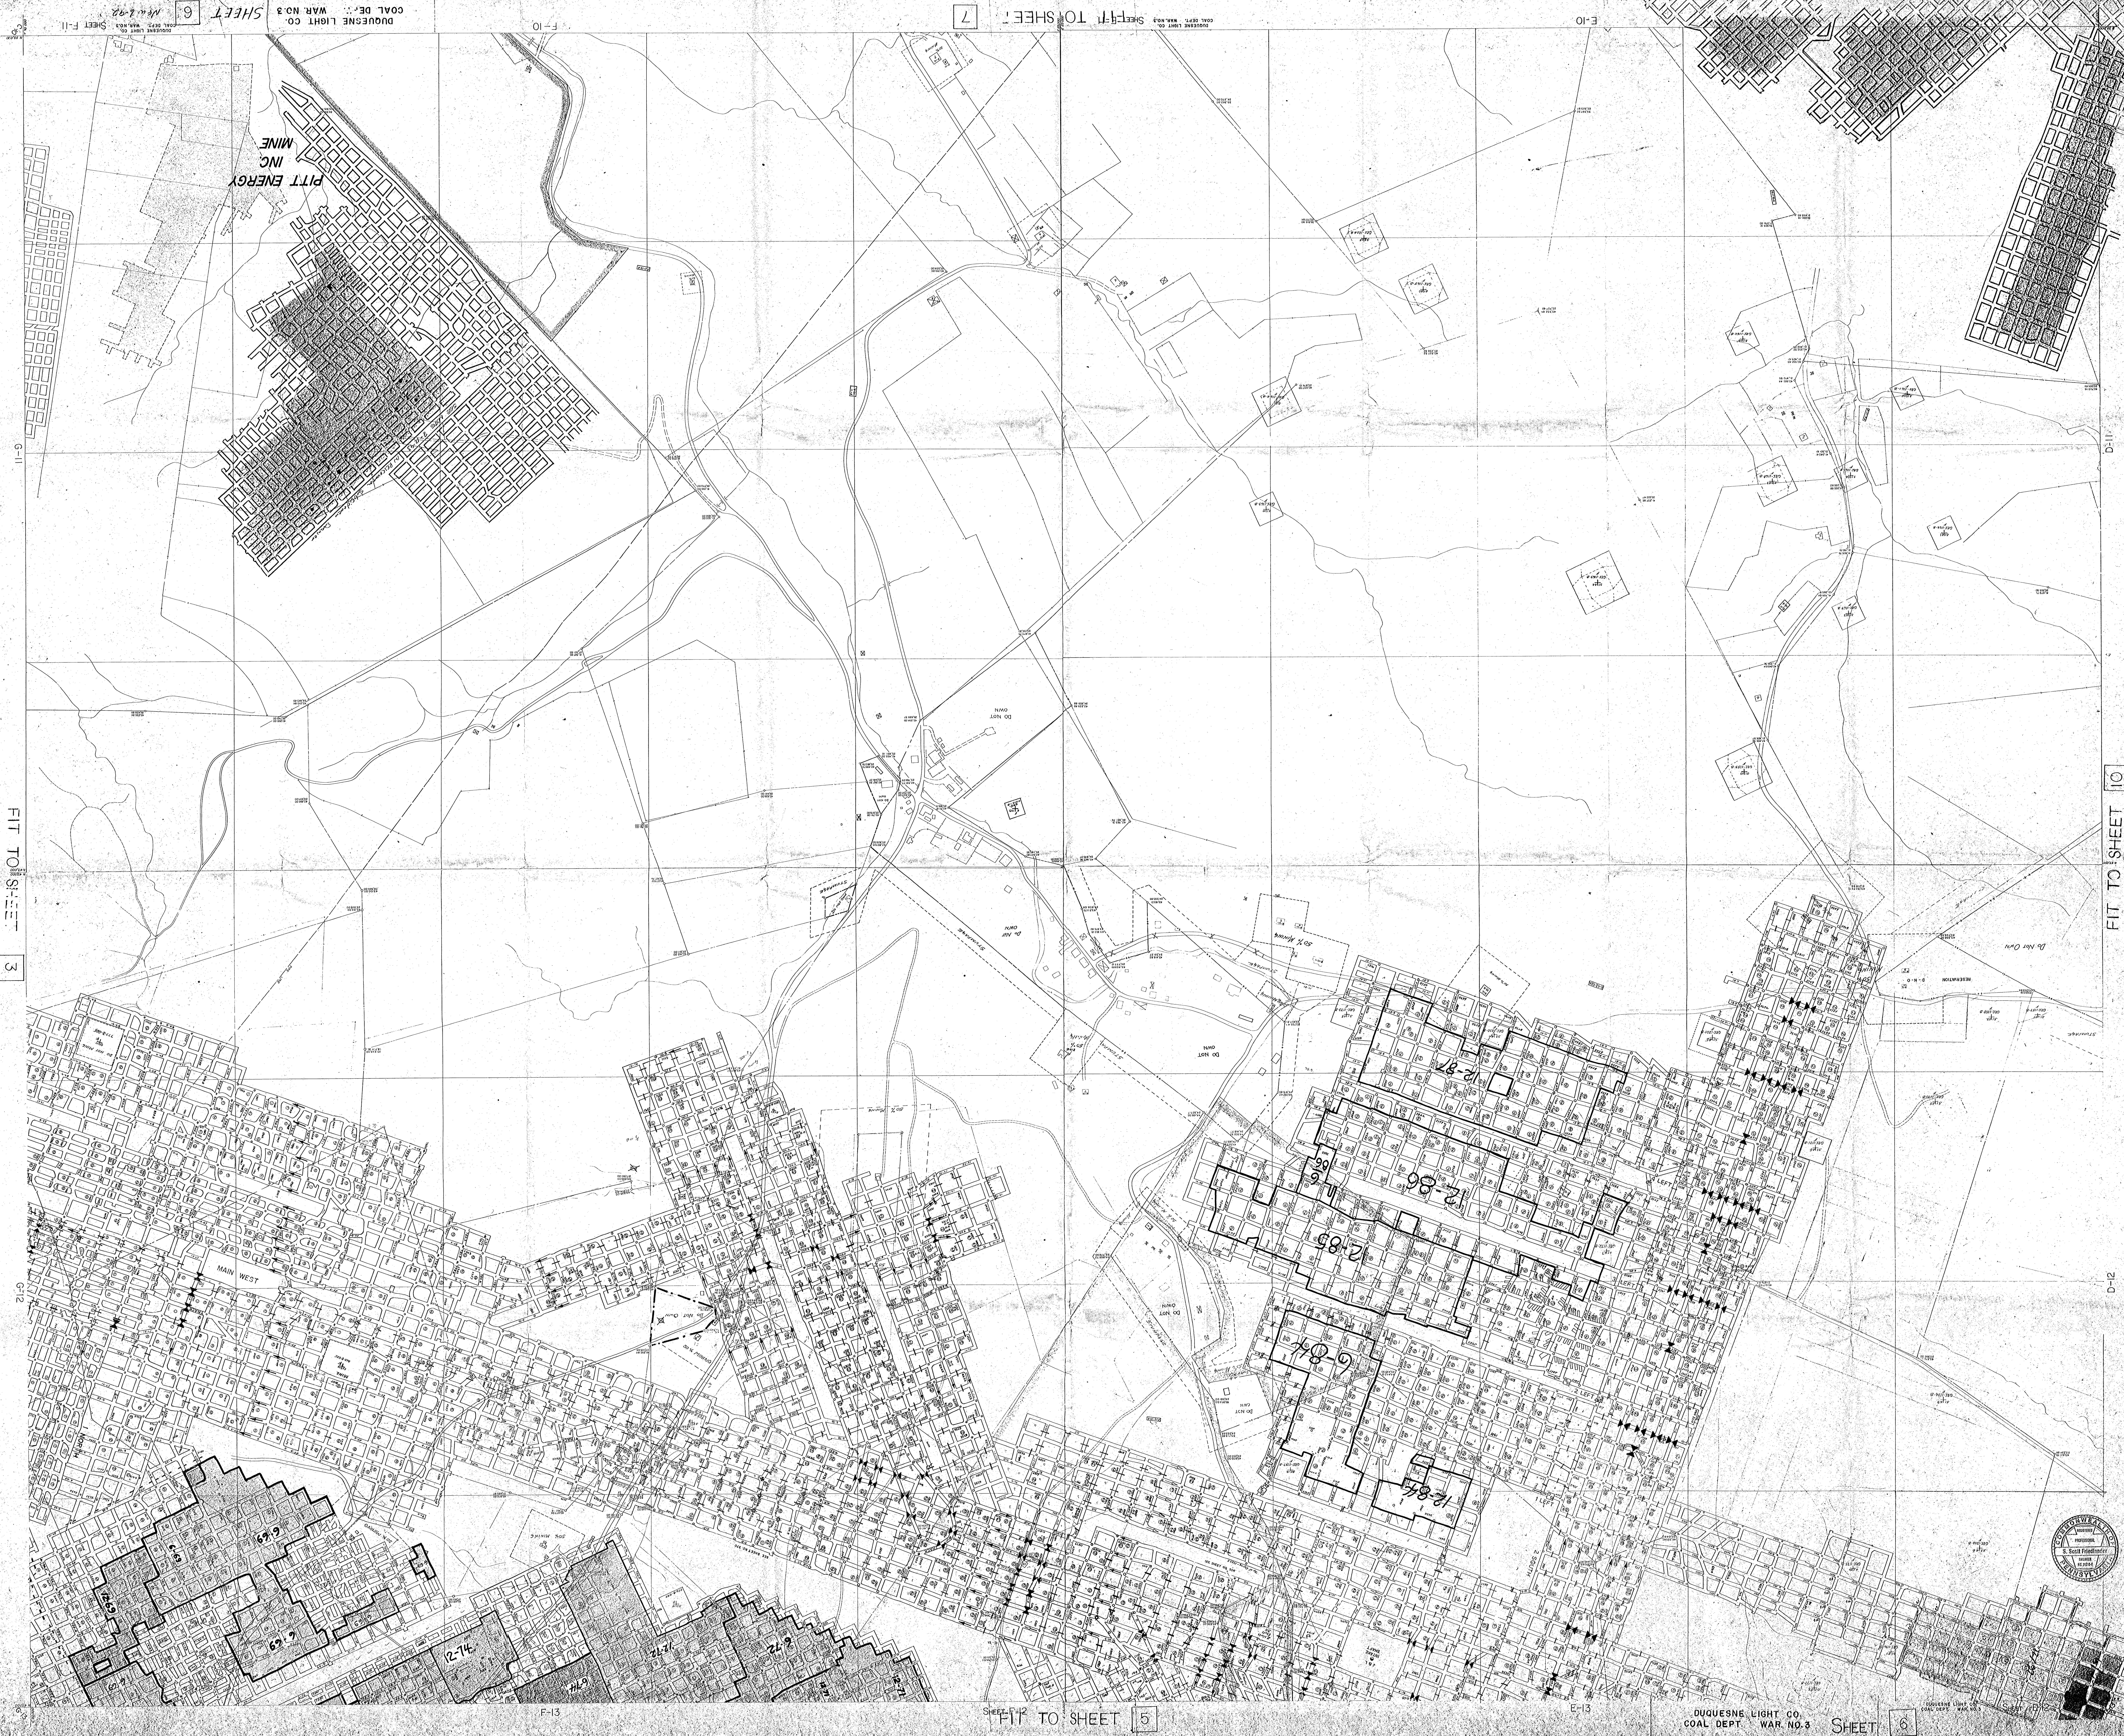

DUQUESNE LIGHT CO. COAL DEPT. WAR NO. 3 SHEET 6

FIT TO SHEET 3

DUQUESNE LIGHT CO. COAL DEPT. WAR NO. 3 SHEET 7

FIT TO SHEET 5

E-10

DUQUESNE LIGHT CO. COAL DEPT. WAR NO. 3 SHEET 6

FIT TO SHEET 10

D-12

