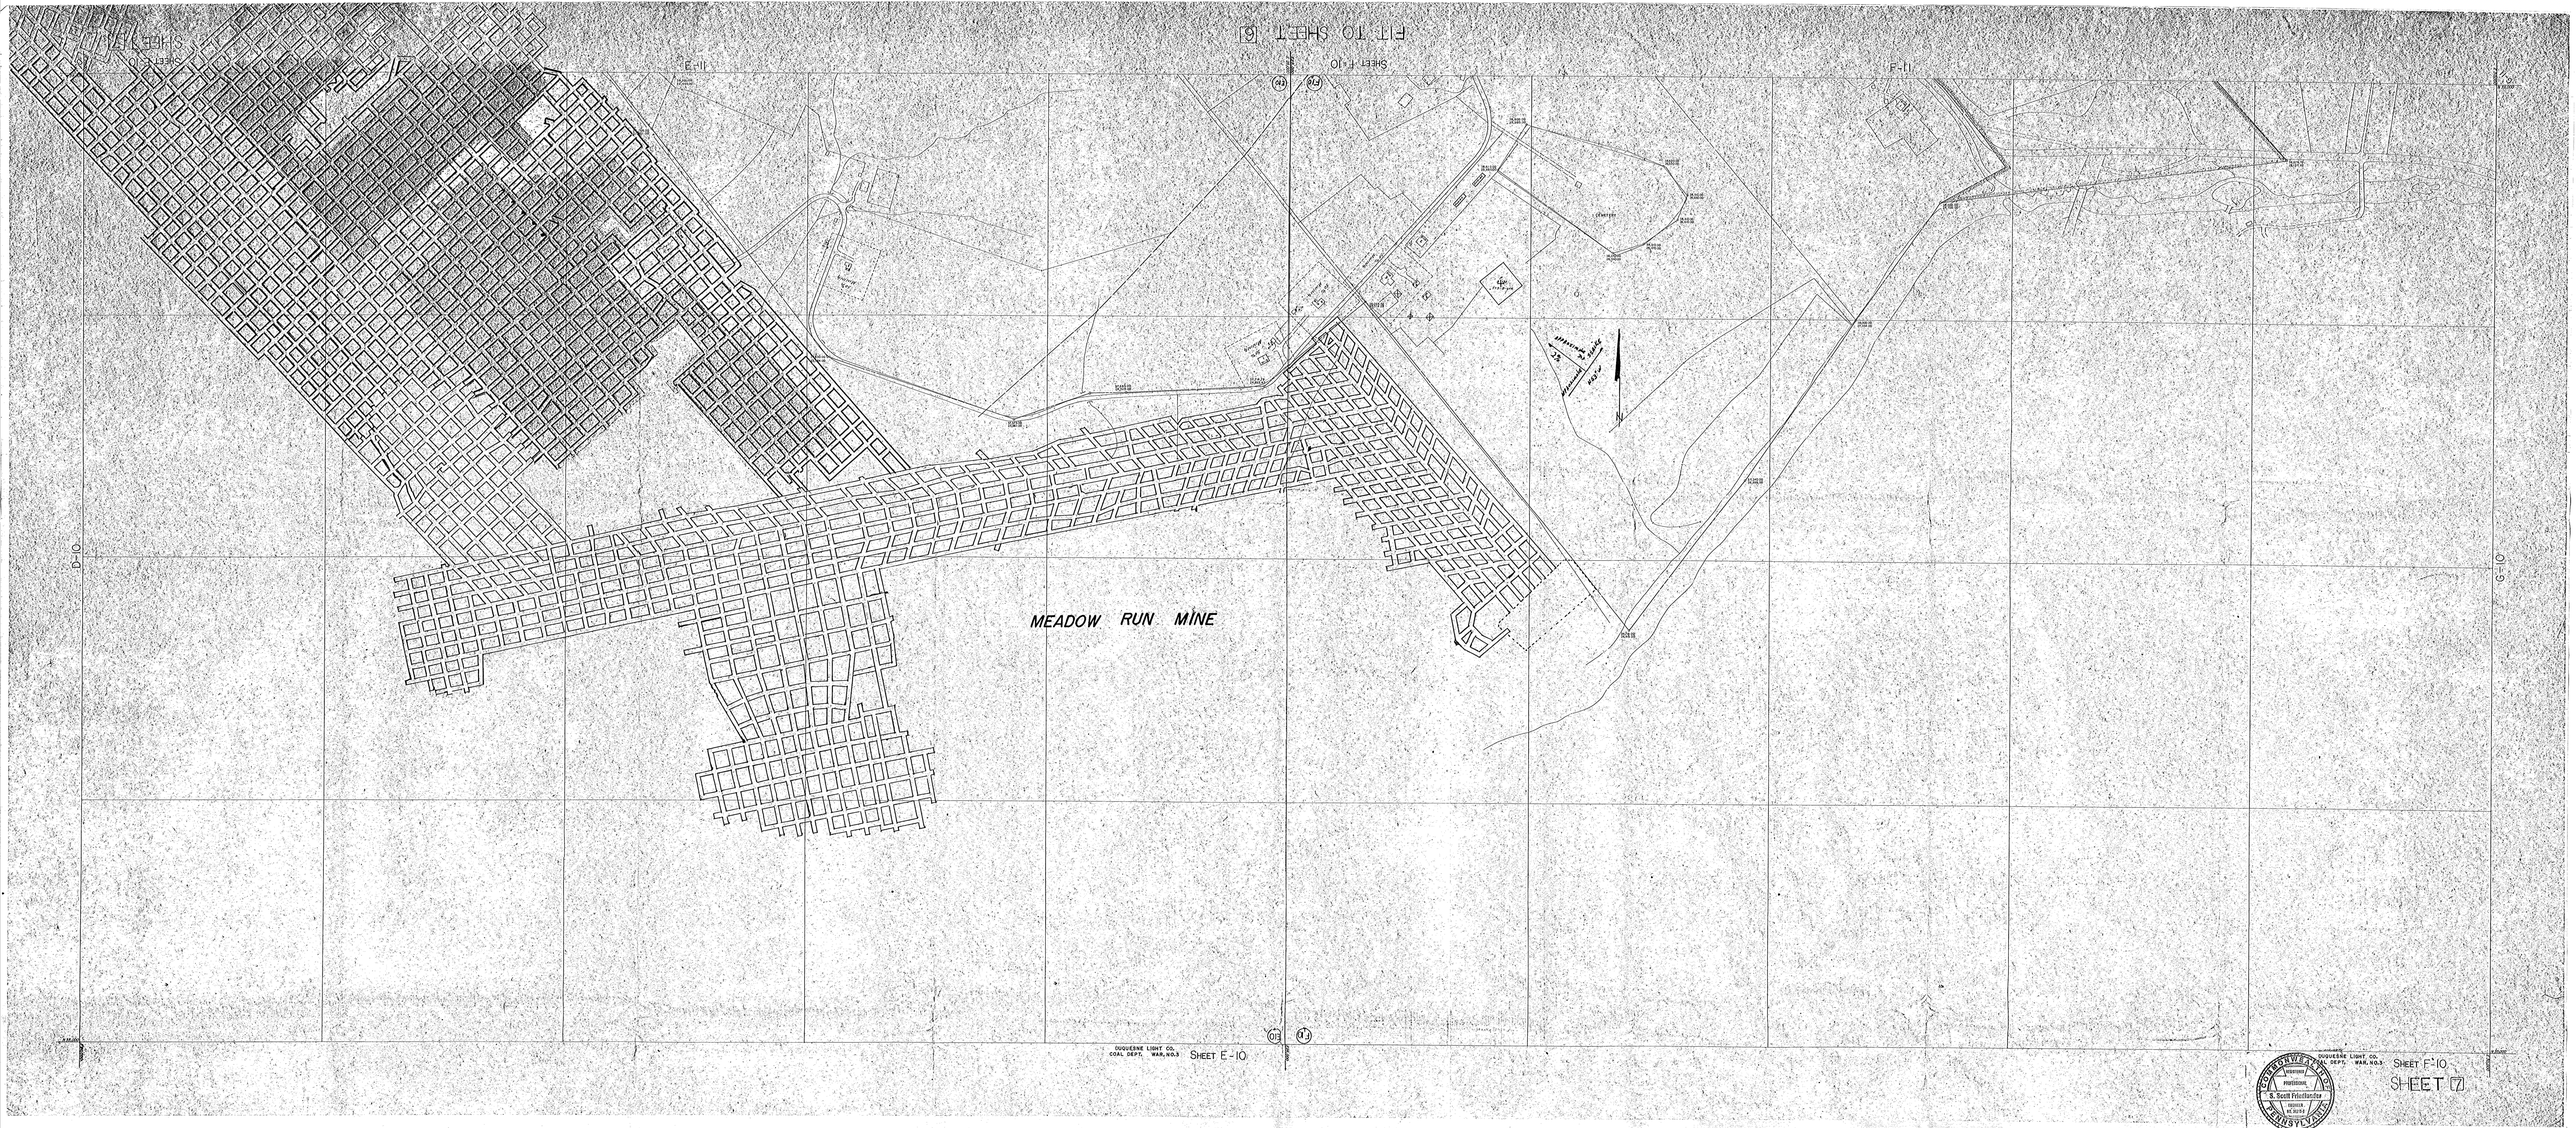

FIT TO SHEET 61
SHEET F-10
F-11
E-10
E-9
MEADOW RUN MINE
N
DUQUESNE LIGHT CO.
COAL DEPT. WAR. NO.3
SHEET E-10
DUQUESNE LIGHT CO.
COAL DEPT. WAR. NO.3
SHEET F-10
SHEET 17
S. Scott Frieclander
REGISTERED
PROFESSIONAL
ENGINEER
PENNSYLVANIA