


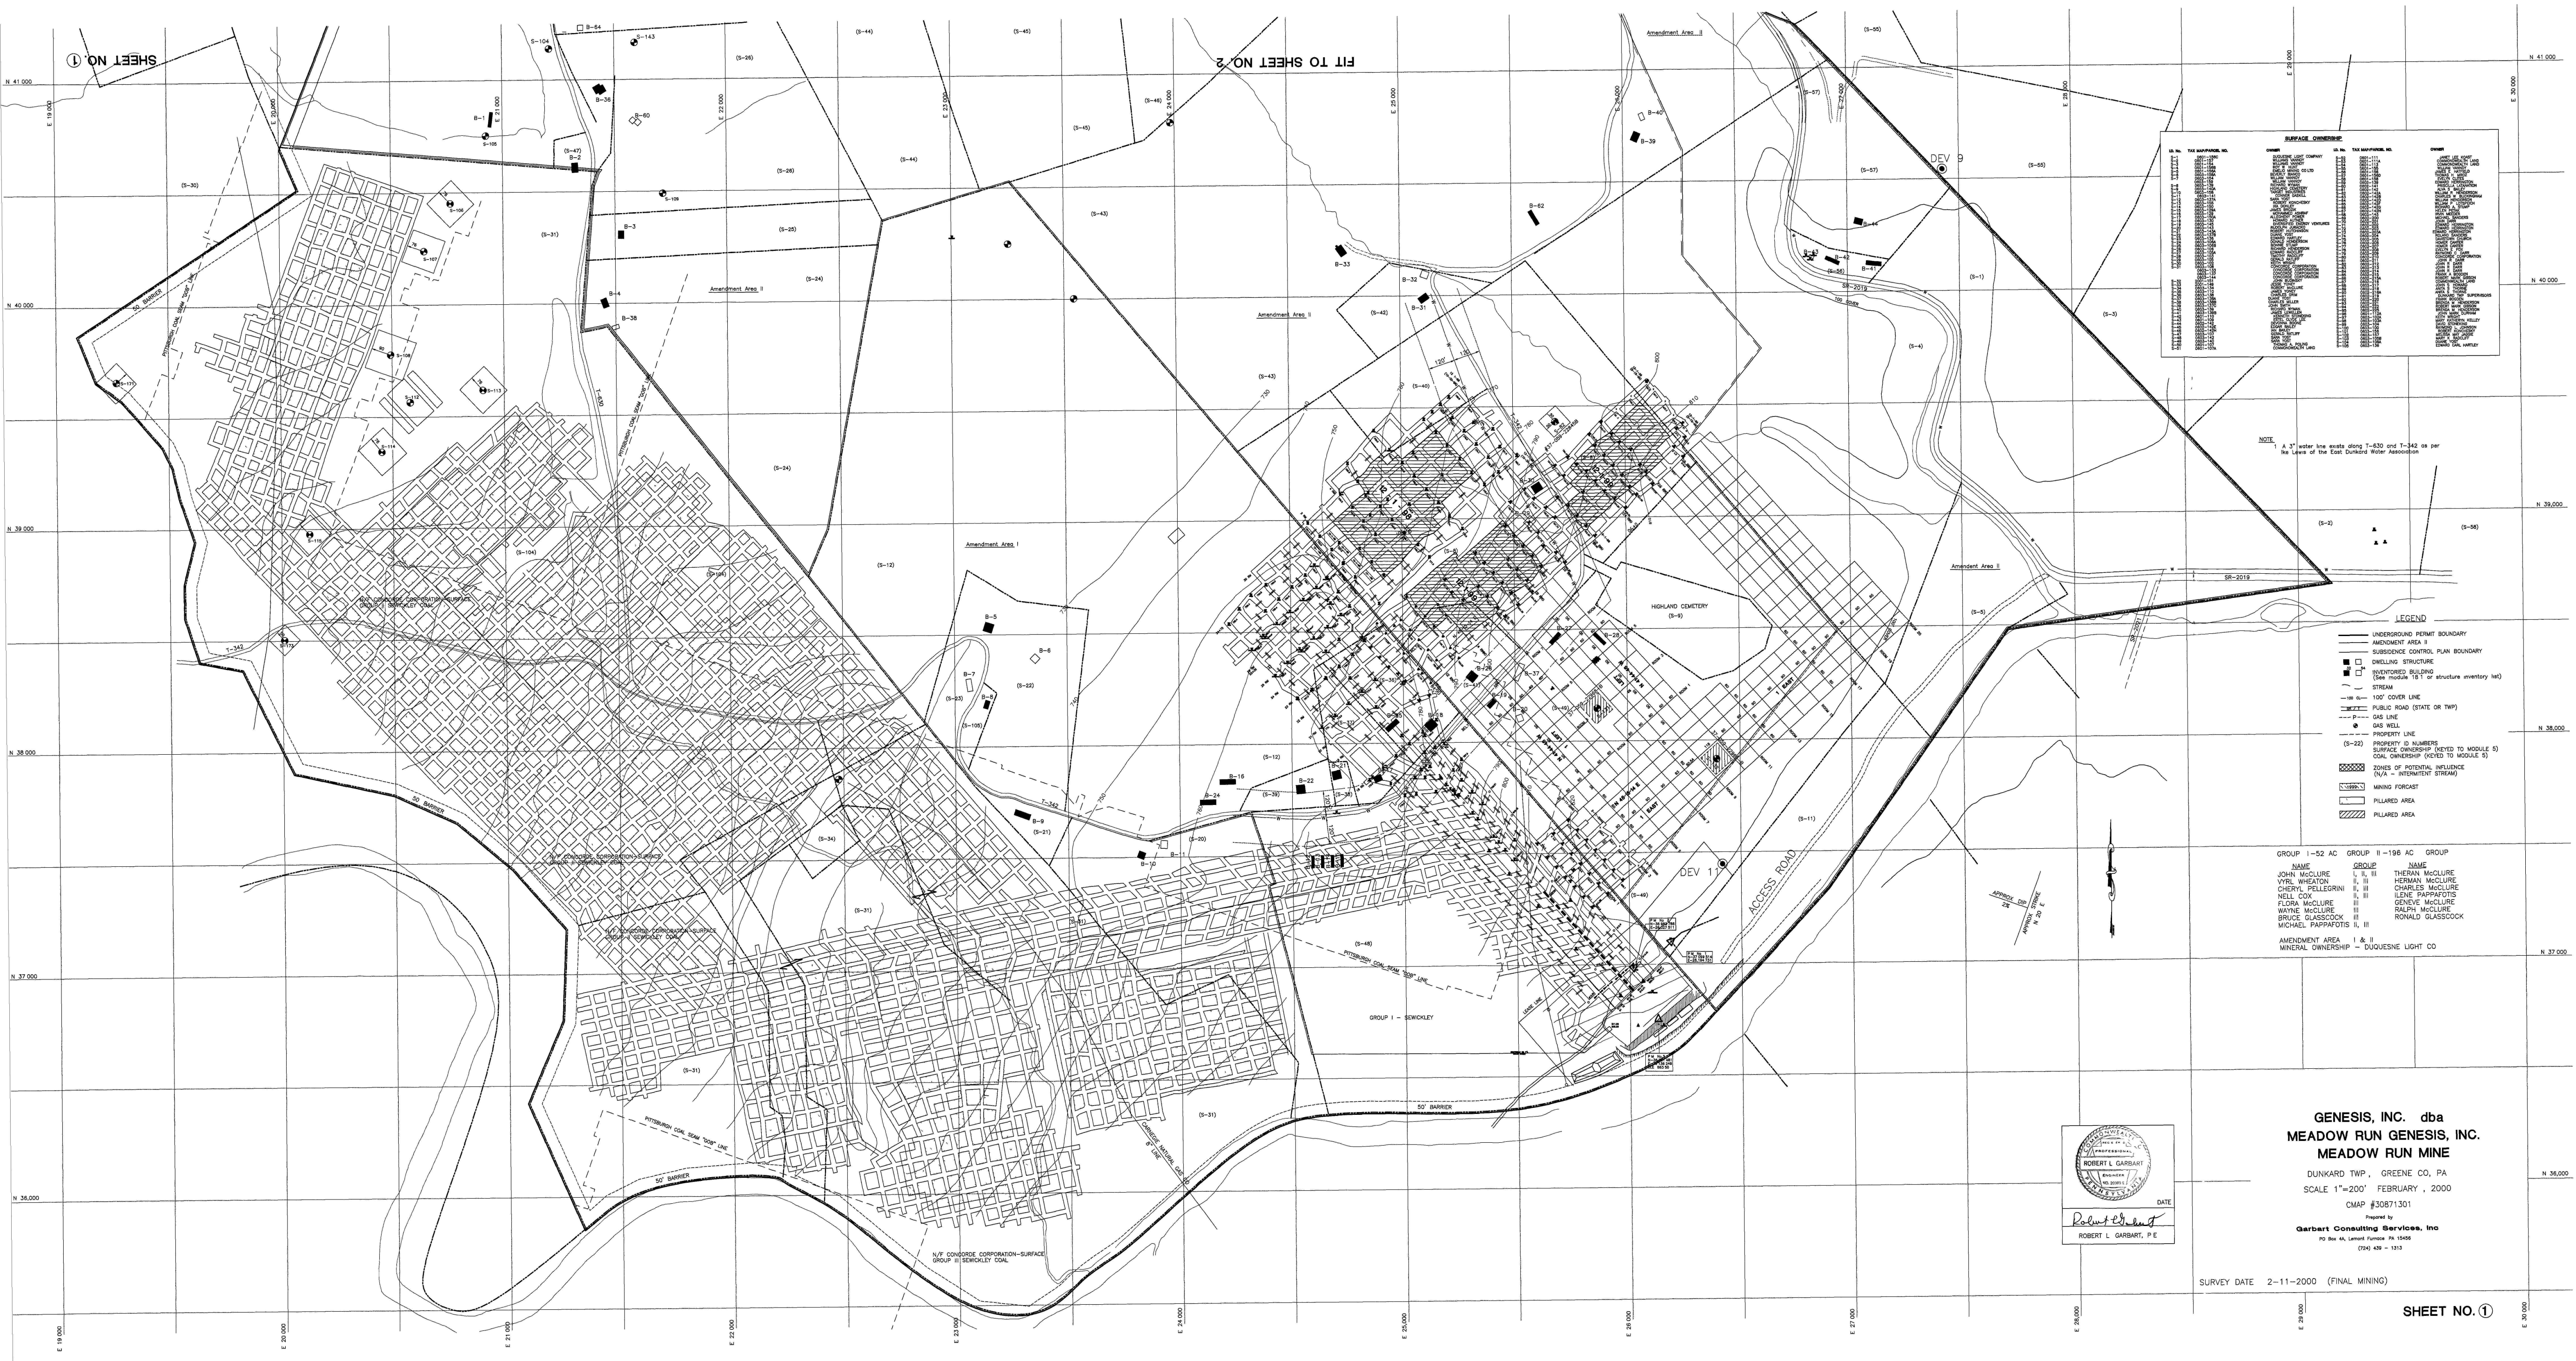

GENESIS, INC. dba
MEADOW RUN GENESIS, INC.
MEADOW RUN MINE

DUNKARD TWP, GREENE CO, PA
SCALE 1"=200' FEBRUARY, 2000
CMAPI #30871301

Prepared by
Garbart Consulting Services, Inc
PO Box 4A, Lemont Furnace PA 15456
(724) 439 - 1313

SURVEY DATE 2-11-2000 (FINAL MINING)

SHEET NO. ①