


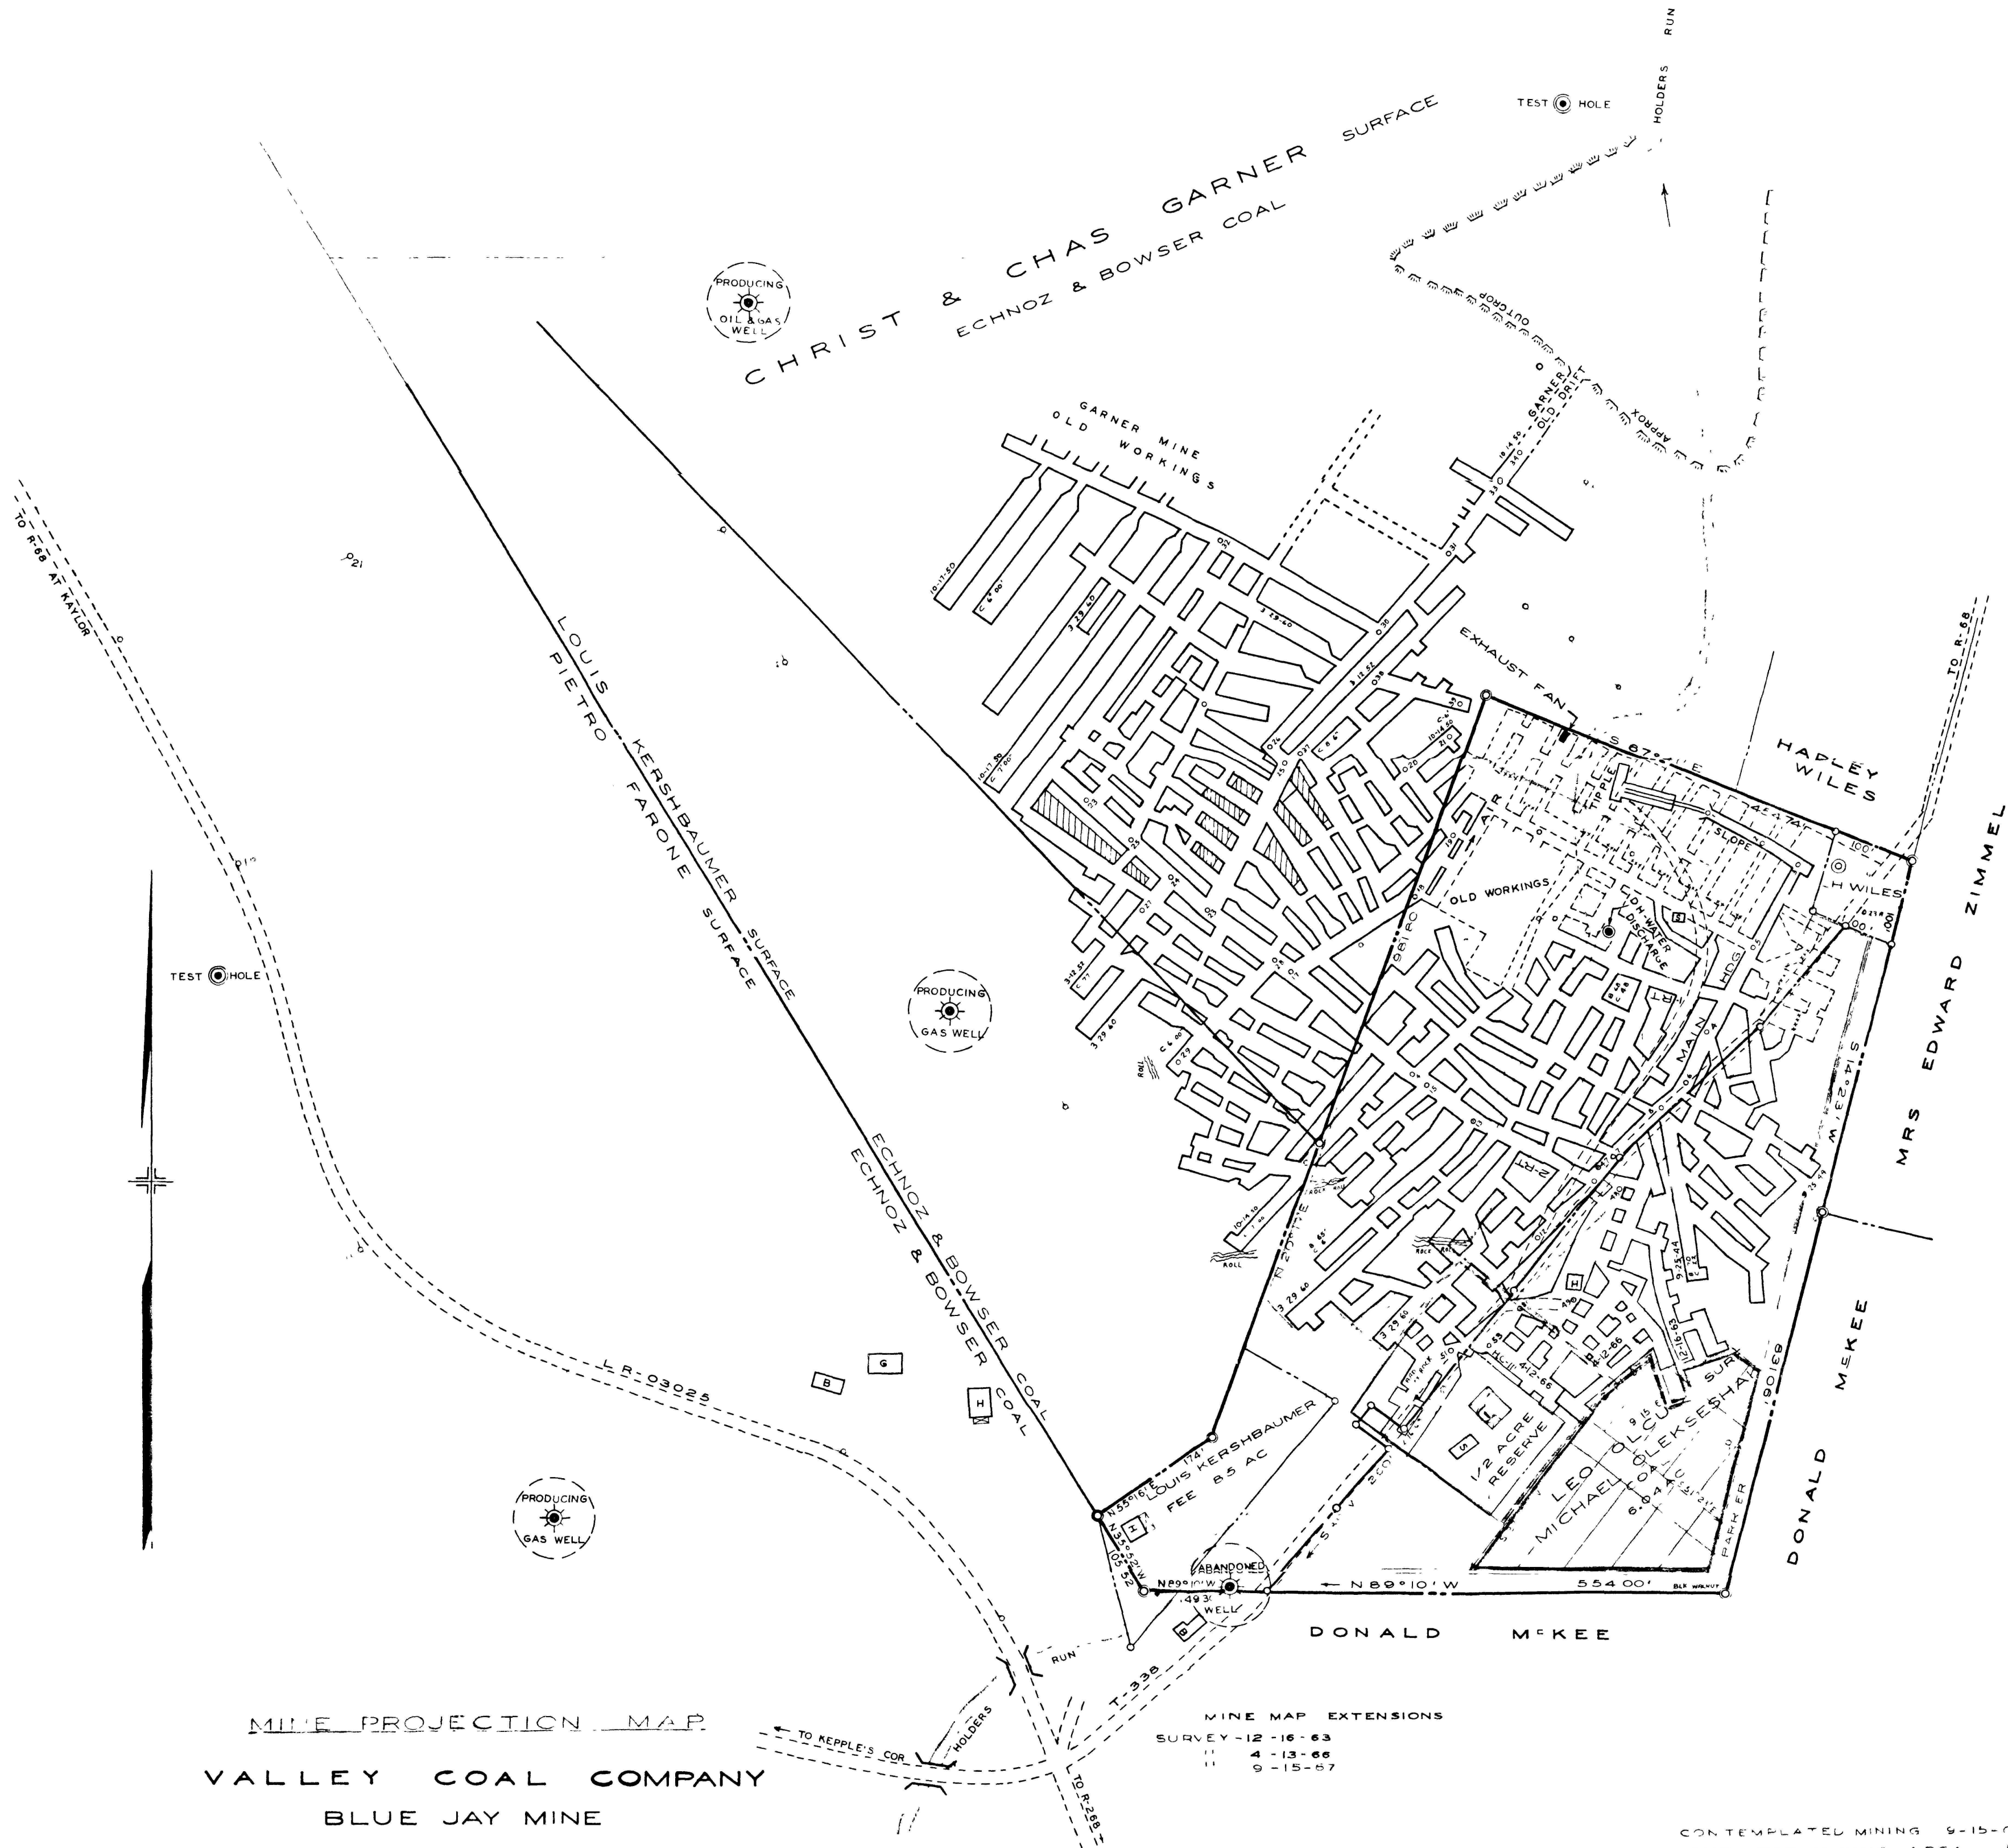

MINE PROJECTION MAP
VALLEY COAL COMPANY
BLUE JAY MINE
UPPER KIT TANNING COAL
BRADY'S BEND TWP ARMSTRONG CO PA.
SCALE 1"=100' SURVEYED 3-29-1960

LEGEND:
COAL OWNED - VALLEY COAL CO
COAL LEASED - VALLEY COAL CO
COAL RESERVED BY OTHERS
COAL RESERVED BY WELLS

CONTEMPLATED MINING 9-15-67 TO 3-15-68
COMPLETED MINING AREA
BUILDING SUPPORT AREA
PROTECTED STRUCTURES
PERMIT NO 68-1

REVISED 12-16-63
REVISED 4-13-66
REVISED 8-15-66
REVISED 3-2-67

REV 9-15-67

E J WEIBEL RS-6572

E. J. Weibel

#314
6-14-99
C.C.