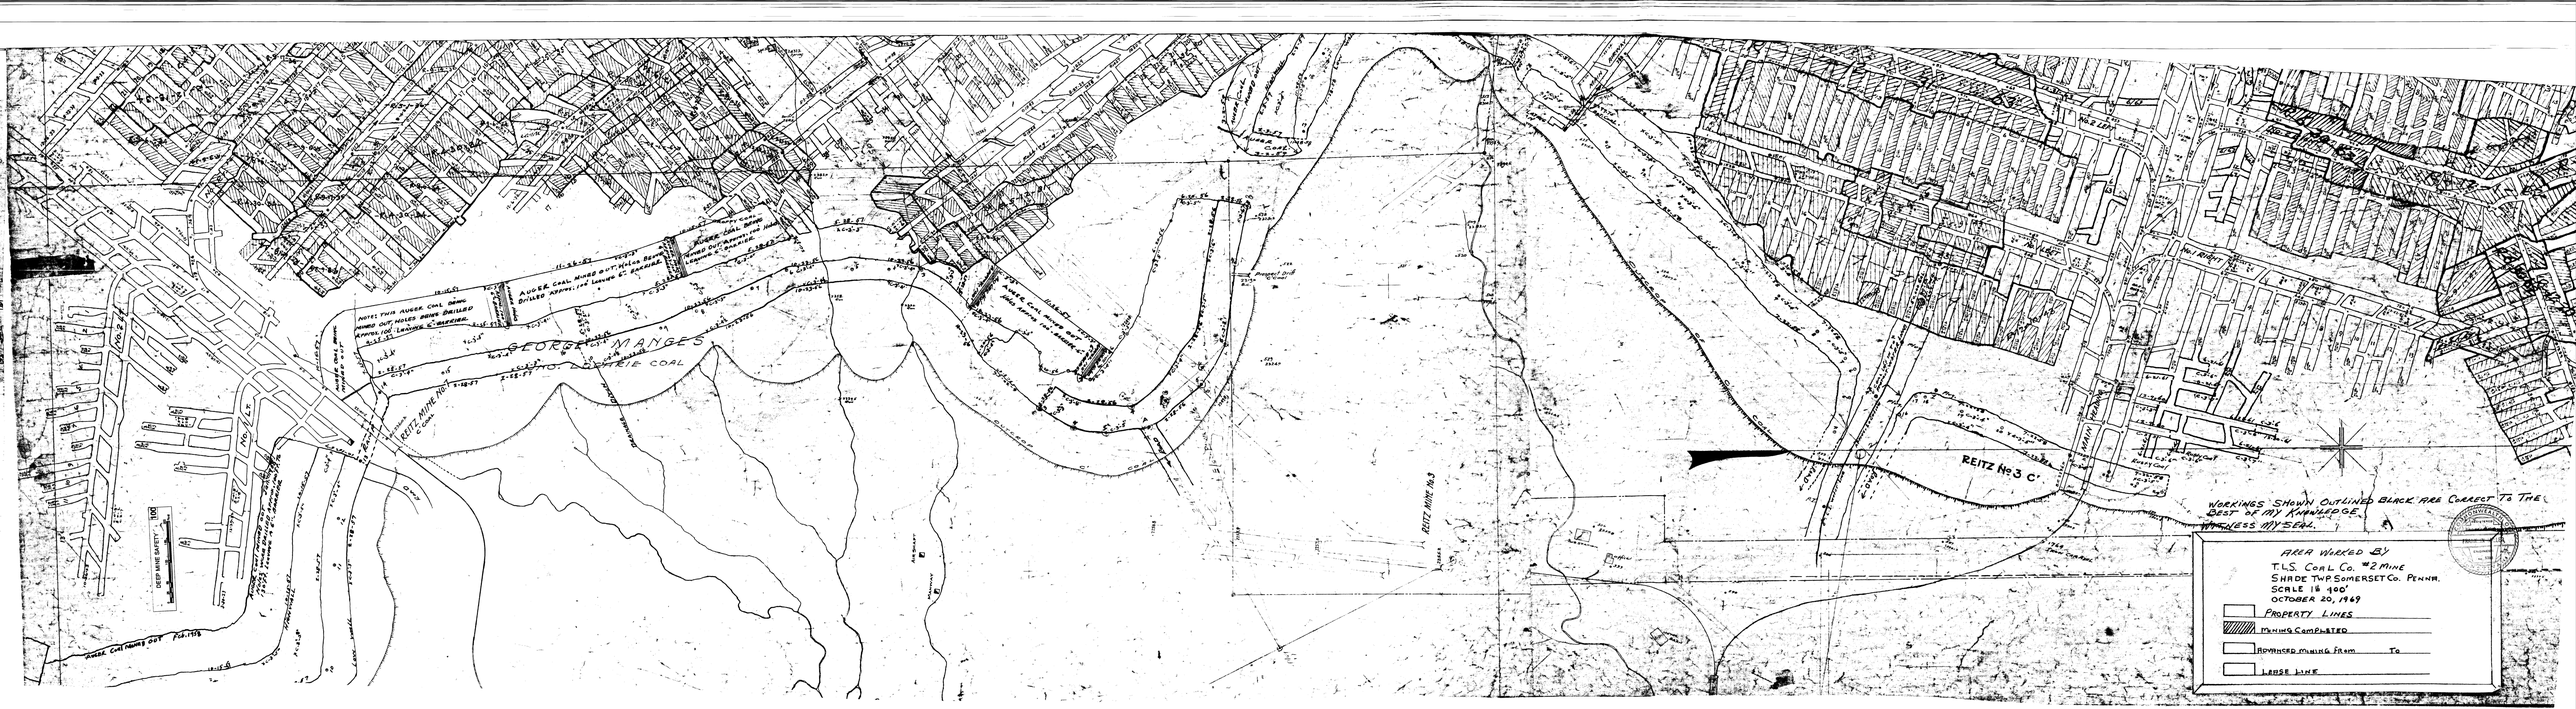

DEEP MINE SAFETY 100
No. 1 LT.
No. 2 LT.
AUGER COAL MINED OUT FEB. 1958
AUGER COAL MINED OUT JAN. 1958. HOLES WERE DRILLED APPROX. 100 FT. TO 130 FT. LEAVING A 6" BARRIER
HIGHWALL
LOW WALL
13 RAMP
ROAD
AUGER COAL BEING MINED OUT
REITZ MINE No. 1 C' COAL
GEORGE MANGES
No. 2 HARTLEY COAL
NOTES: THIS AUGER COAL BEING MINED OUT. HOLES BEING DRILLED APPROX. 100'. LEAVING 6" BARRIER
AUGER COAL MINED OUT. HOLES BEING DRILLED APPROX. 100' LEAVING 6" BARRIER
AUGER COAL BEING MINED OUT APPROX. 100 HOLES LEAVING 6" BARRIER
AUGER COAL MINED OUT HOLES APPROX. 100' LEAVING 6" BARRIER
DRAINAGE DITCH
AIR SHAFT
MANWAY
OUTCROP C' COAL
ROAD
Prospect Drift C' Coal
AUGER COAL MINED OUT
AUGER COAL
HIGHWALL
LOW WALL
REITZ MINE No. 3
Office
OUTCROP OF C' COAL
ROAD
REITZ No. 3 C'
MAIN HEADING
MAIN AIRWAY
No. 1 RIGHT
No. 2 LEFT
No. 1 LEFT

WORKINGS SHOWN OUTLINED BLACK ARE CORRECT TO THE BEST OF MY KNOWLEDGE
WITNESS MY SEAL.

AREA WORKED BY
T.L.S. COAL CO. #2 MINE
SHADE TWP. SOMERSET CO. PENNA.
SCALE 1" = 400'
OCTOBER 20, 1969

☐	PROPERTY LINES
▨	MINING COMPLETED
☐	ADVANCED MINING FROM ______ TO ______
☐	LEASE LINE

FRANK ... MILLER

No. 5388