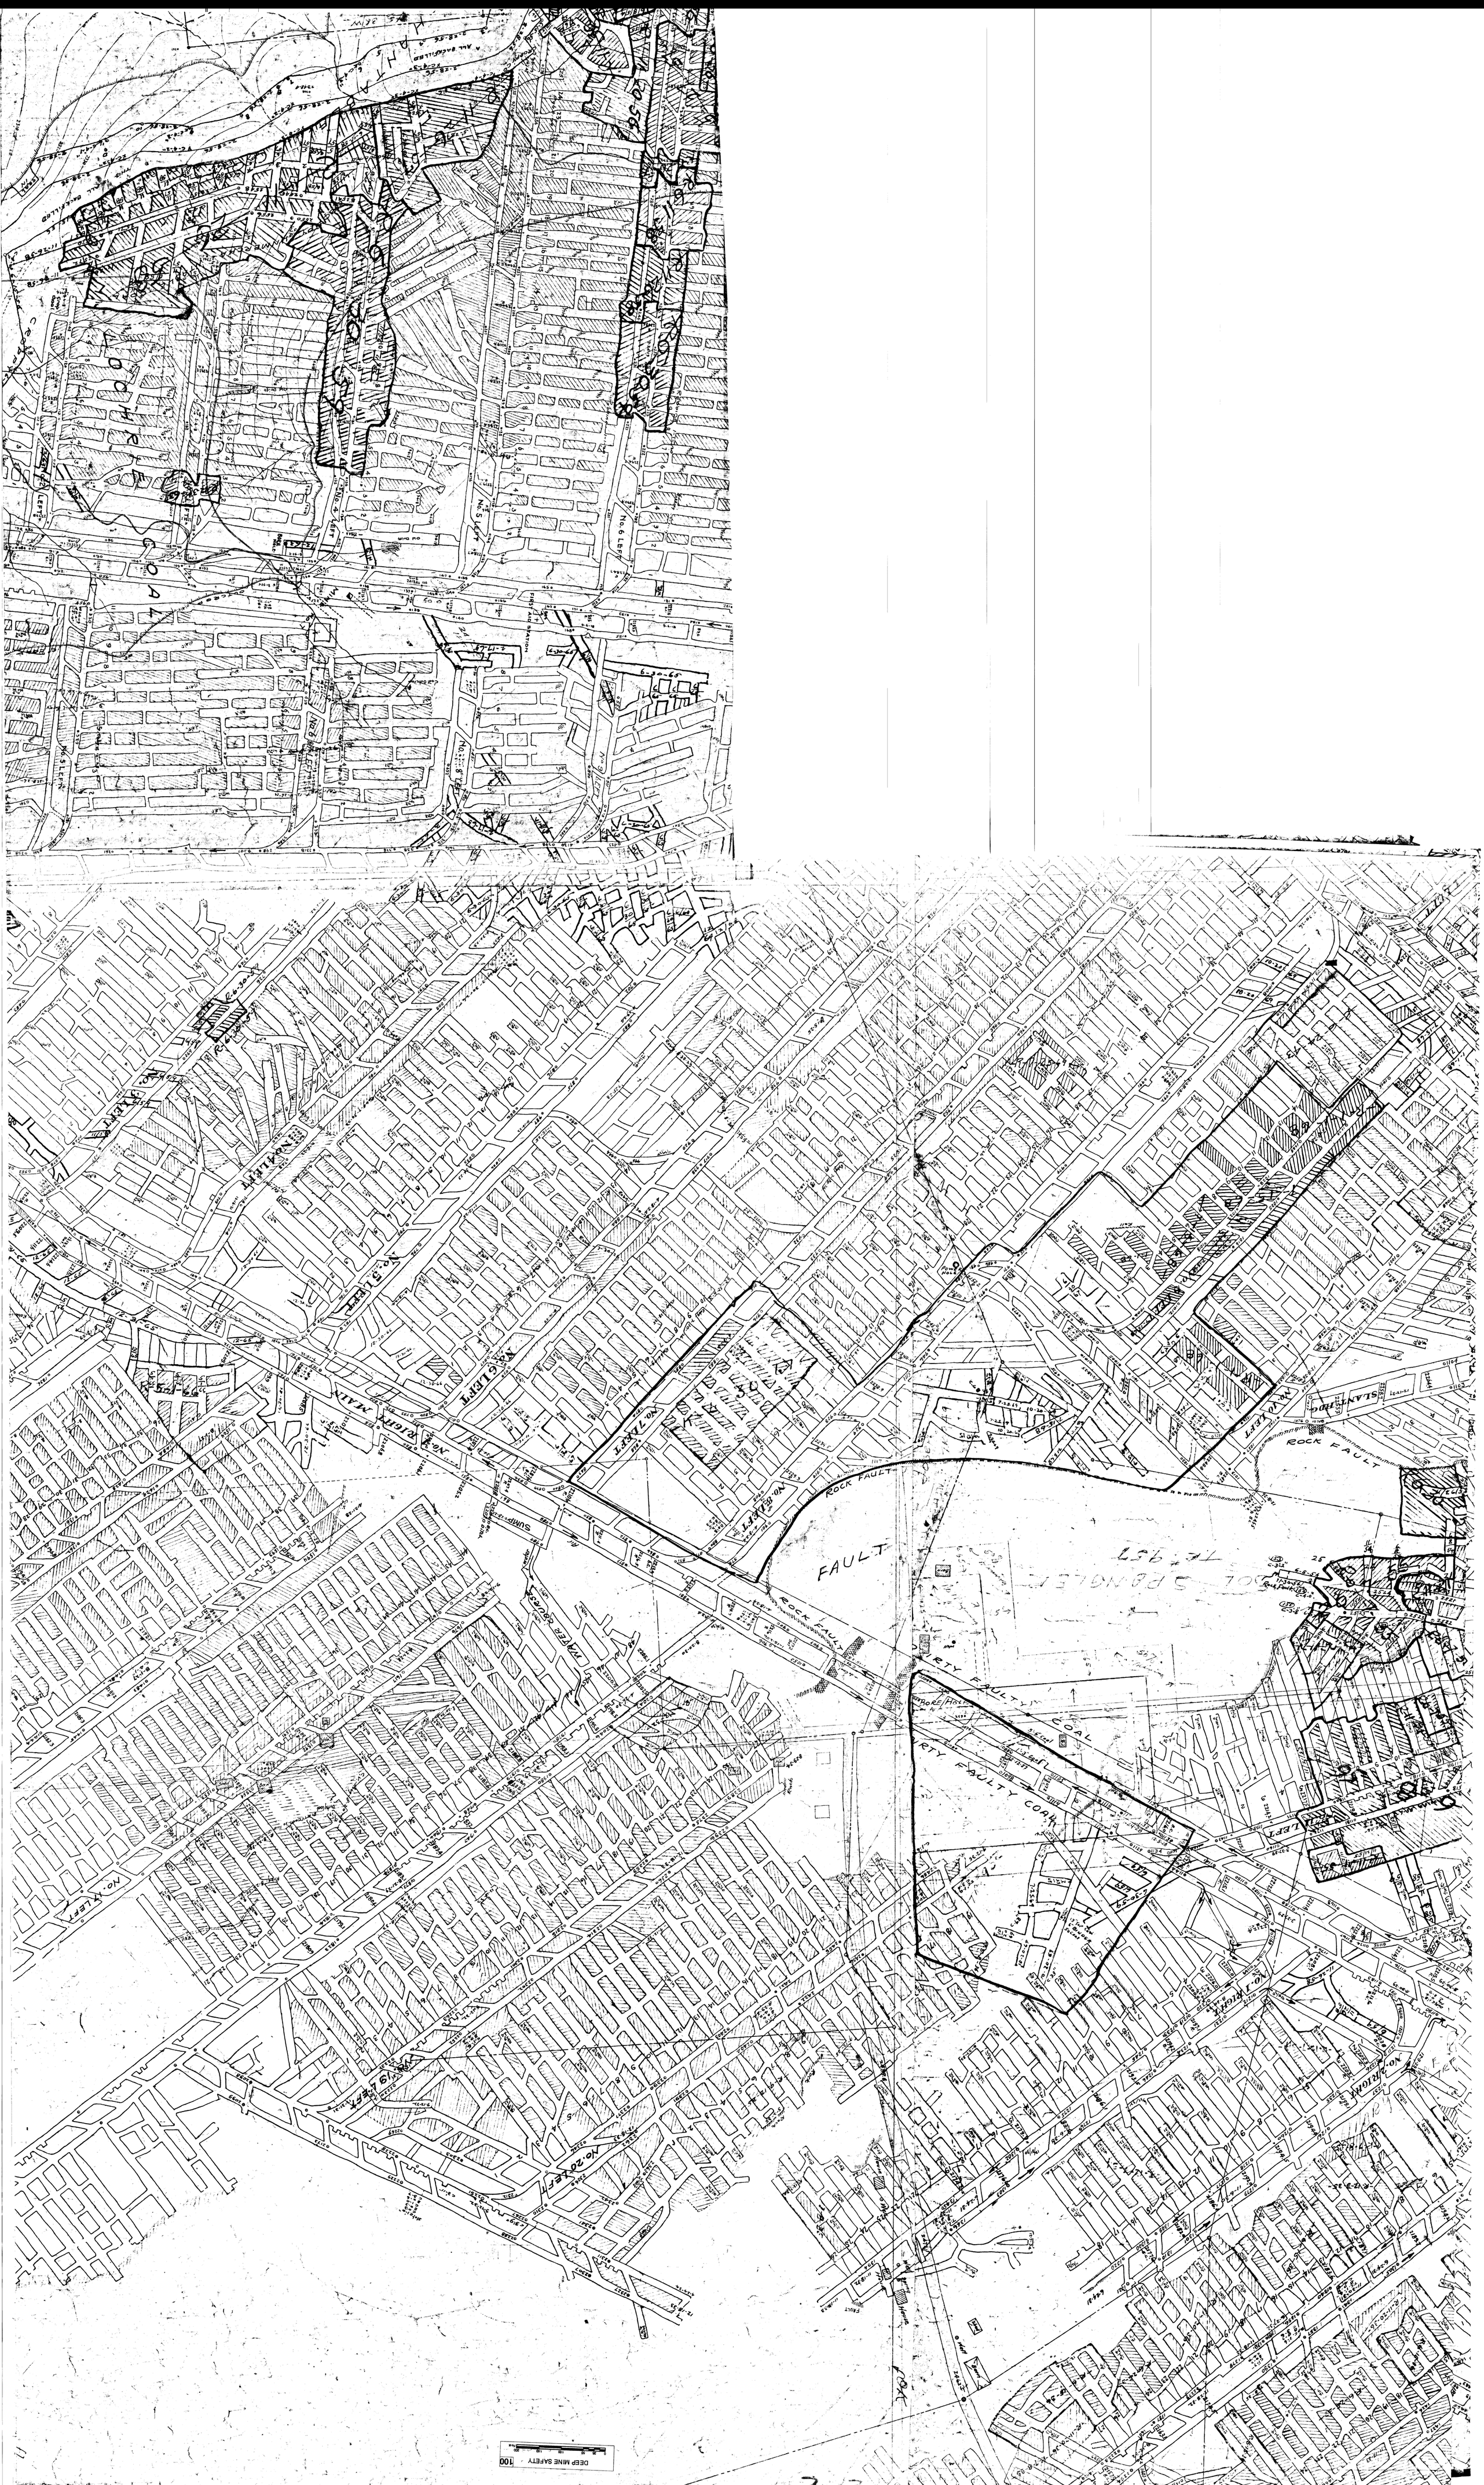

DEEP MINE SAFETY
100
0 25 50 100 150 200
Feet
No. 2 RIGHT
No. 1 RIGHT
No. 20 LEFT
No. 19 LEFT
No. 17 LEFT
No. 11 LEFT
House
Well
Barn
FAULT
DIRTY FAULTY COAL
COAL
BORE HOLE
SOL SPANGLER
TR# 957
ROCK FAULT
No. 10 LEFT
SLANT HDG.
No. 8 LEFT
No. 7 LEFT
SUMP
AIR
WATER COURSE
Dirty Coal
No. 1 RIGHT MAIN
No. 6 LEFT
No. 5 LEFT
No. 4 LEFT
No. 3 LEFT
POWER HOLE
No. 9 LEFT
No. 8 LEFT
No. 6 LEFT
No. 5 LEFT
Coal Outcrop
FIRST AID STATION
MINE
OUTCROP
Old Drift
No. 6 LEFT
No. 5 LEFT
No. 4 LEFT
CROPPY COAL
A ALL BACKFILLED
THIS ALL BACKFILLED