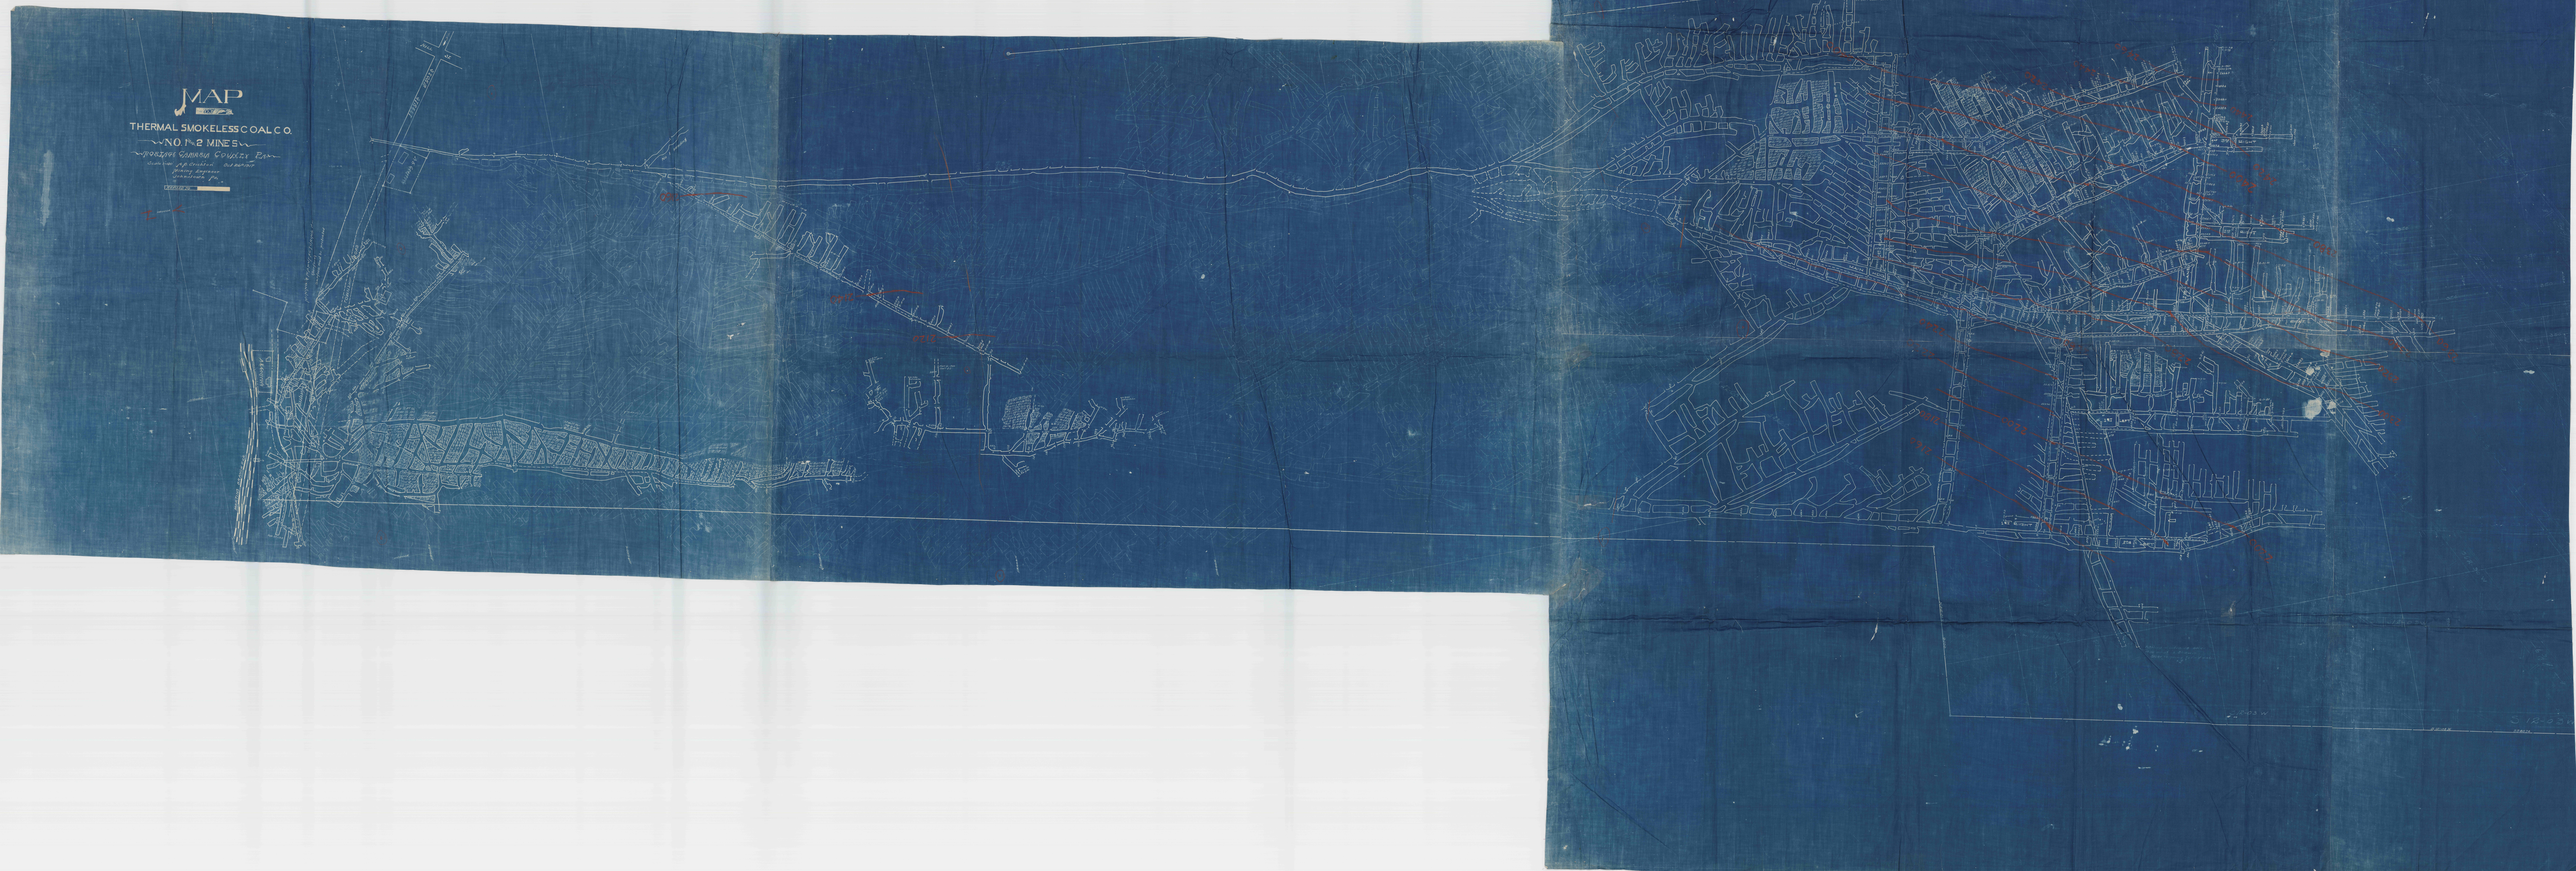
MAP
THERMAL SMOKELESS COAL CO.
NO. 1 & 2 MINES
Scale