MAP OF PROPERTY
OF THE
TAYLOR & McCOY COAL & COKE CO.

GALLITZIN TOWNSHIP, CAMBRIA CO., PA.

SCALE:- 1" = 400'

"E" SEAM MINE WORKINGS SHOWN TO DATE OF FEB. 10, 1896.

ALTOONA, PA.

W. A. SILLIMAN
MINING ENGINEER.

ALL MINERAL AND SURFACE OWNED IN FEE
ALL MINERAL OWNED IN FEE-SURFACE NOT OWNED
ALL MINERAL EXCEPT "D" SEAM OWNED IN FEE-SURFACE OWNED
"D" SEAM OWNED IN FEE, "E" SEAM LEASED
"E" SEAM ONLY LEASED
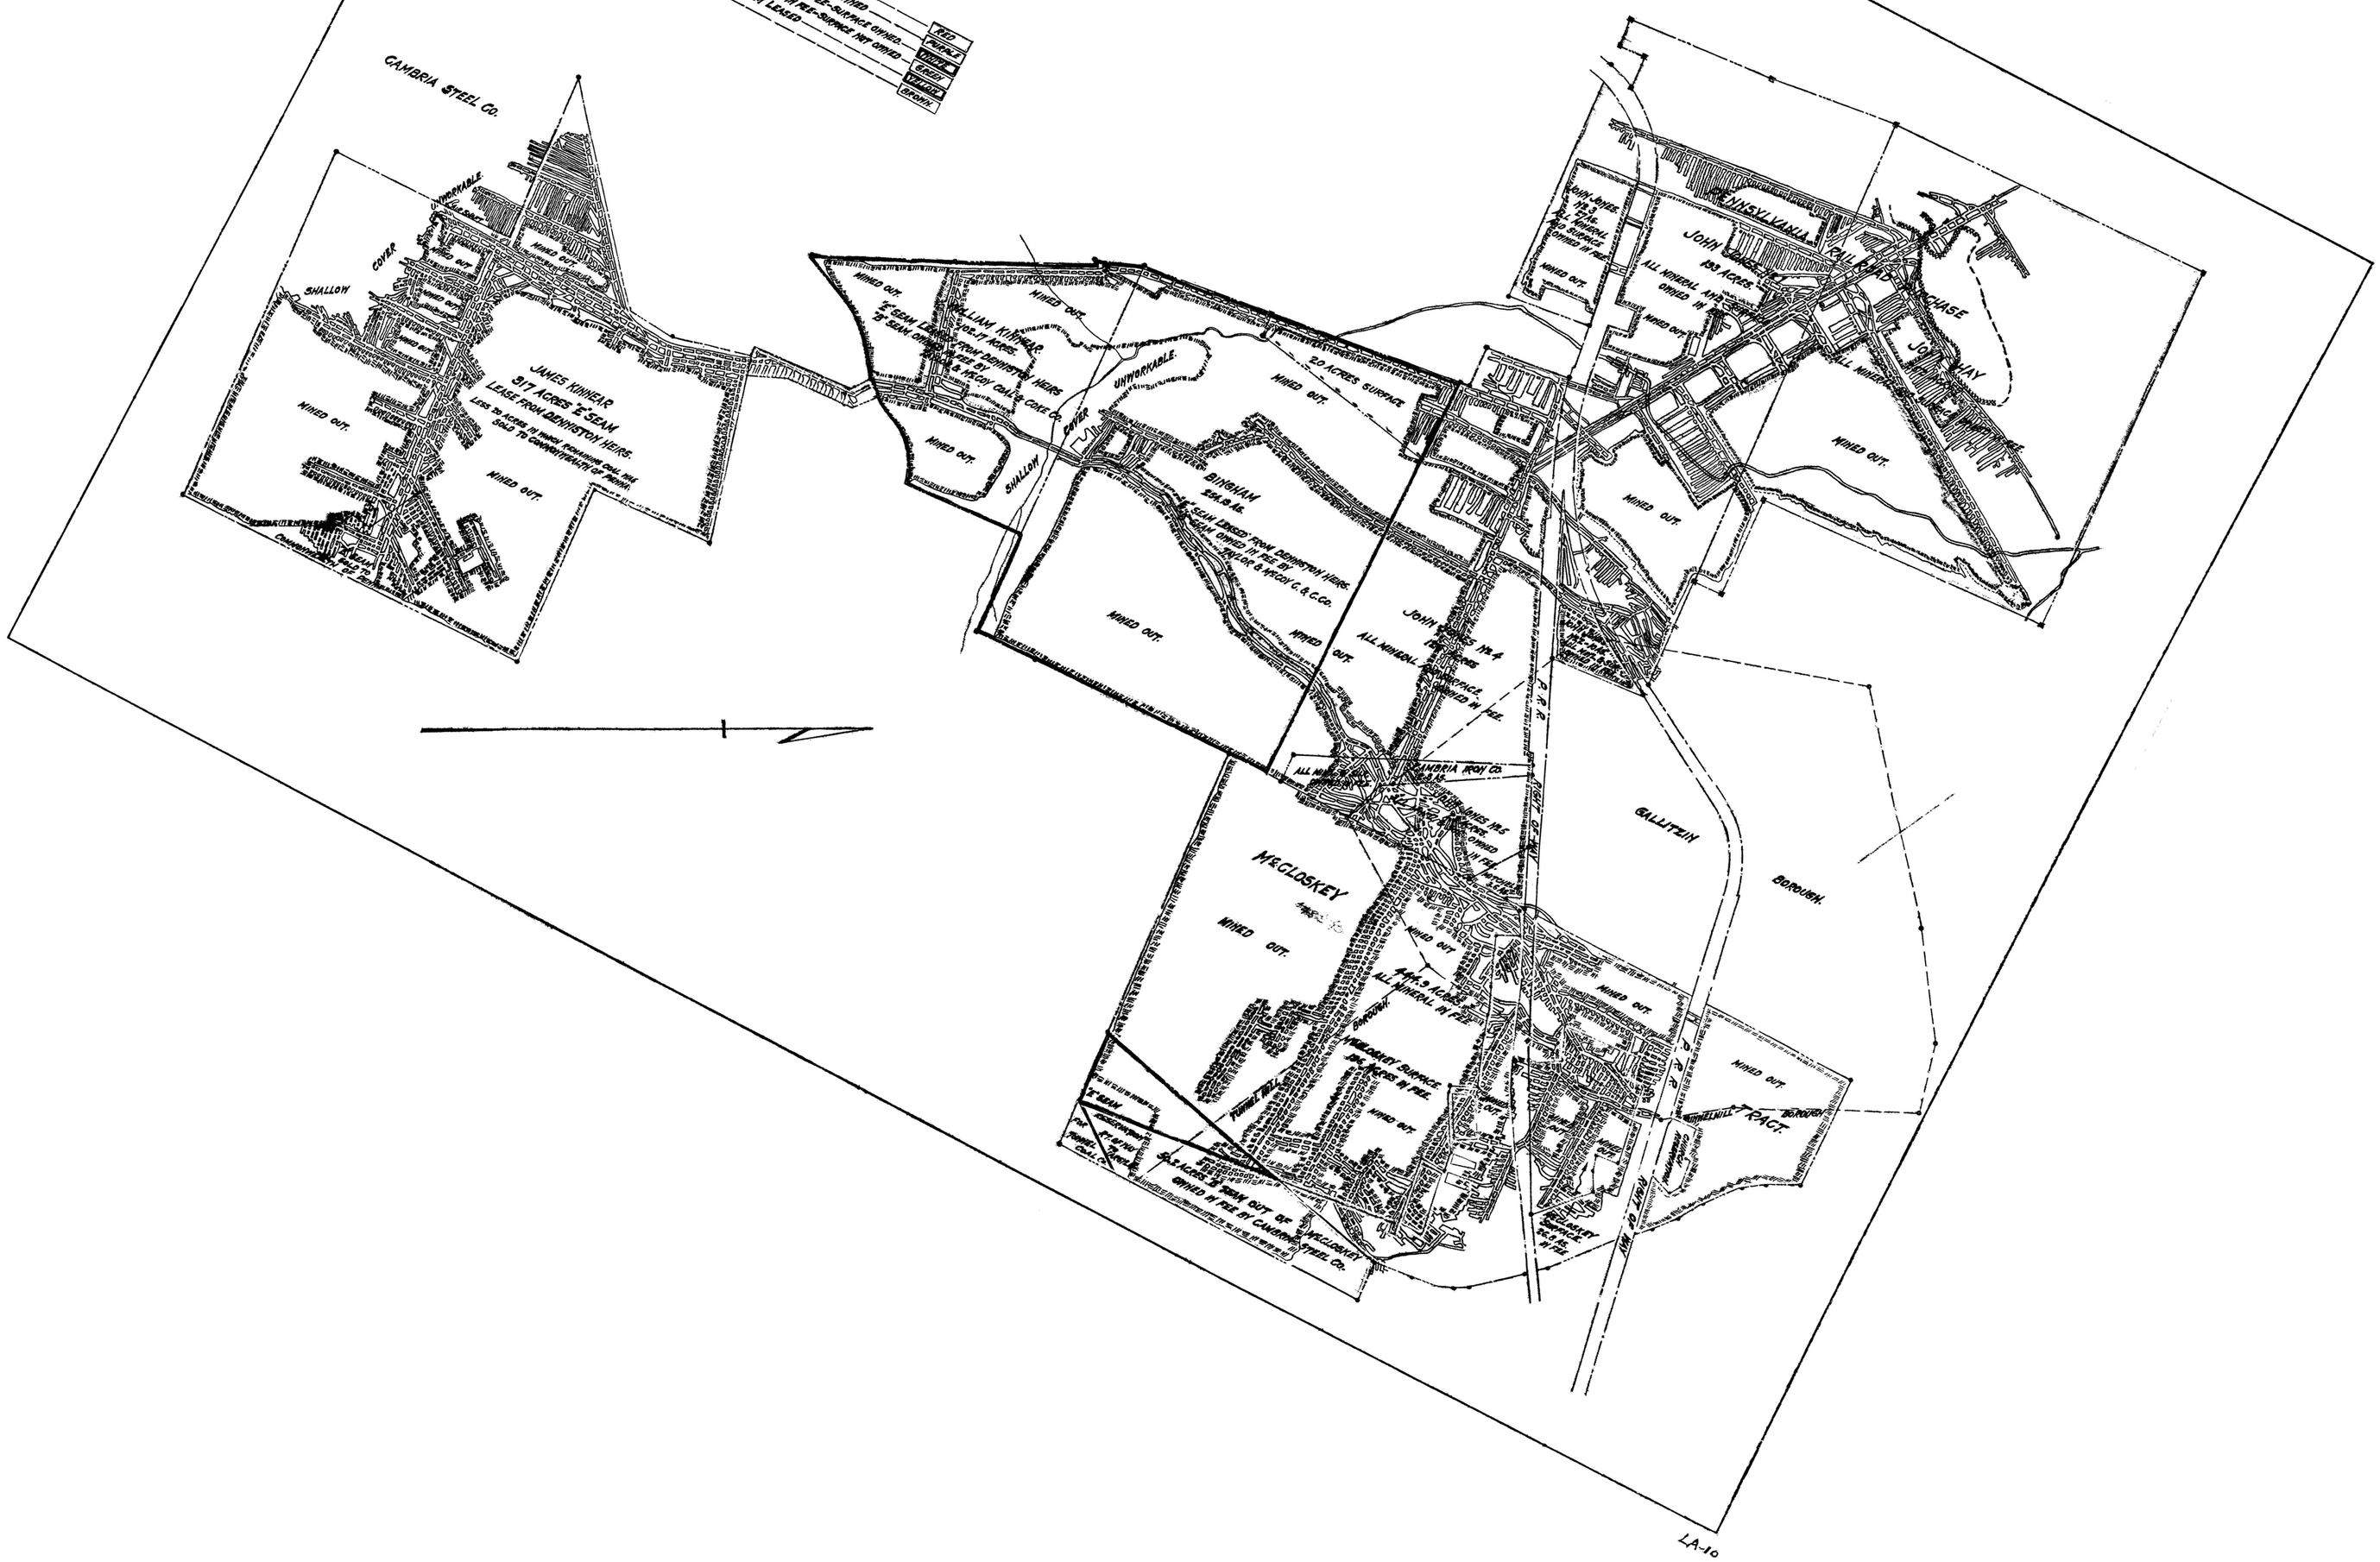
FEE
PURCHASE
LEASE
LEASE & PURCHASE
UNOWNED