


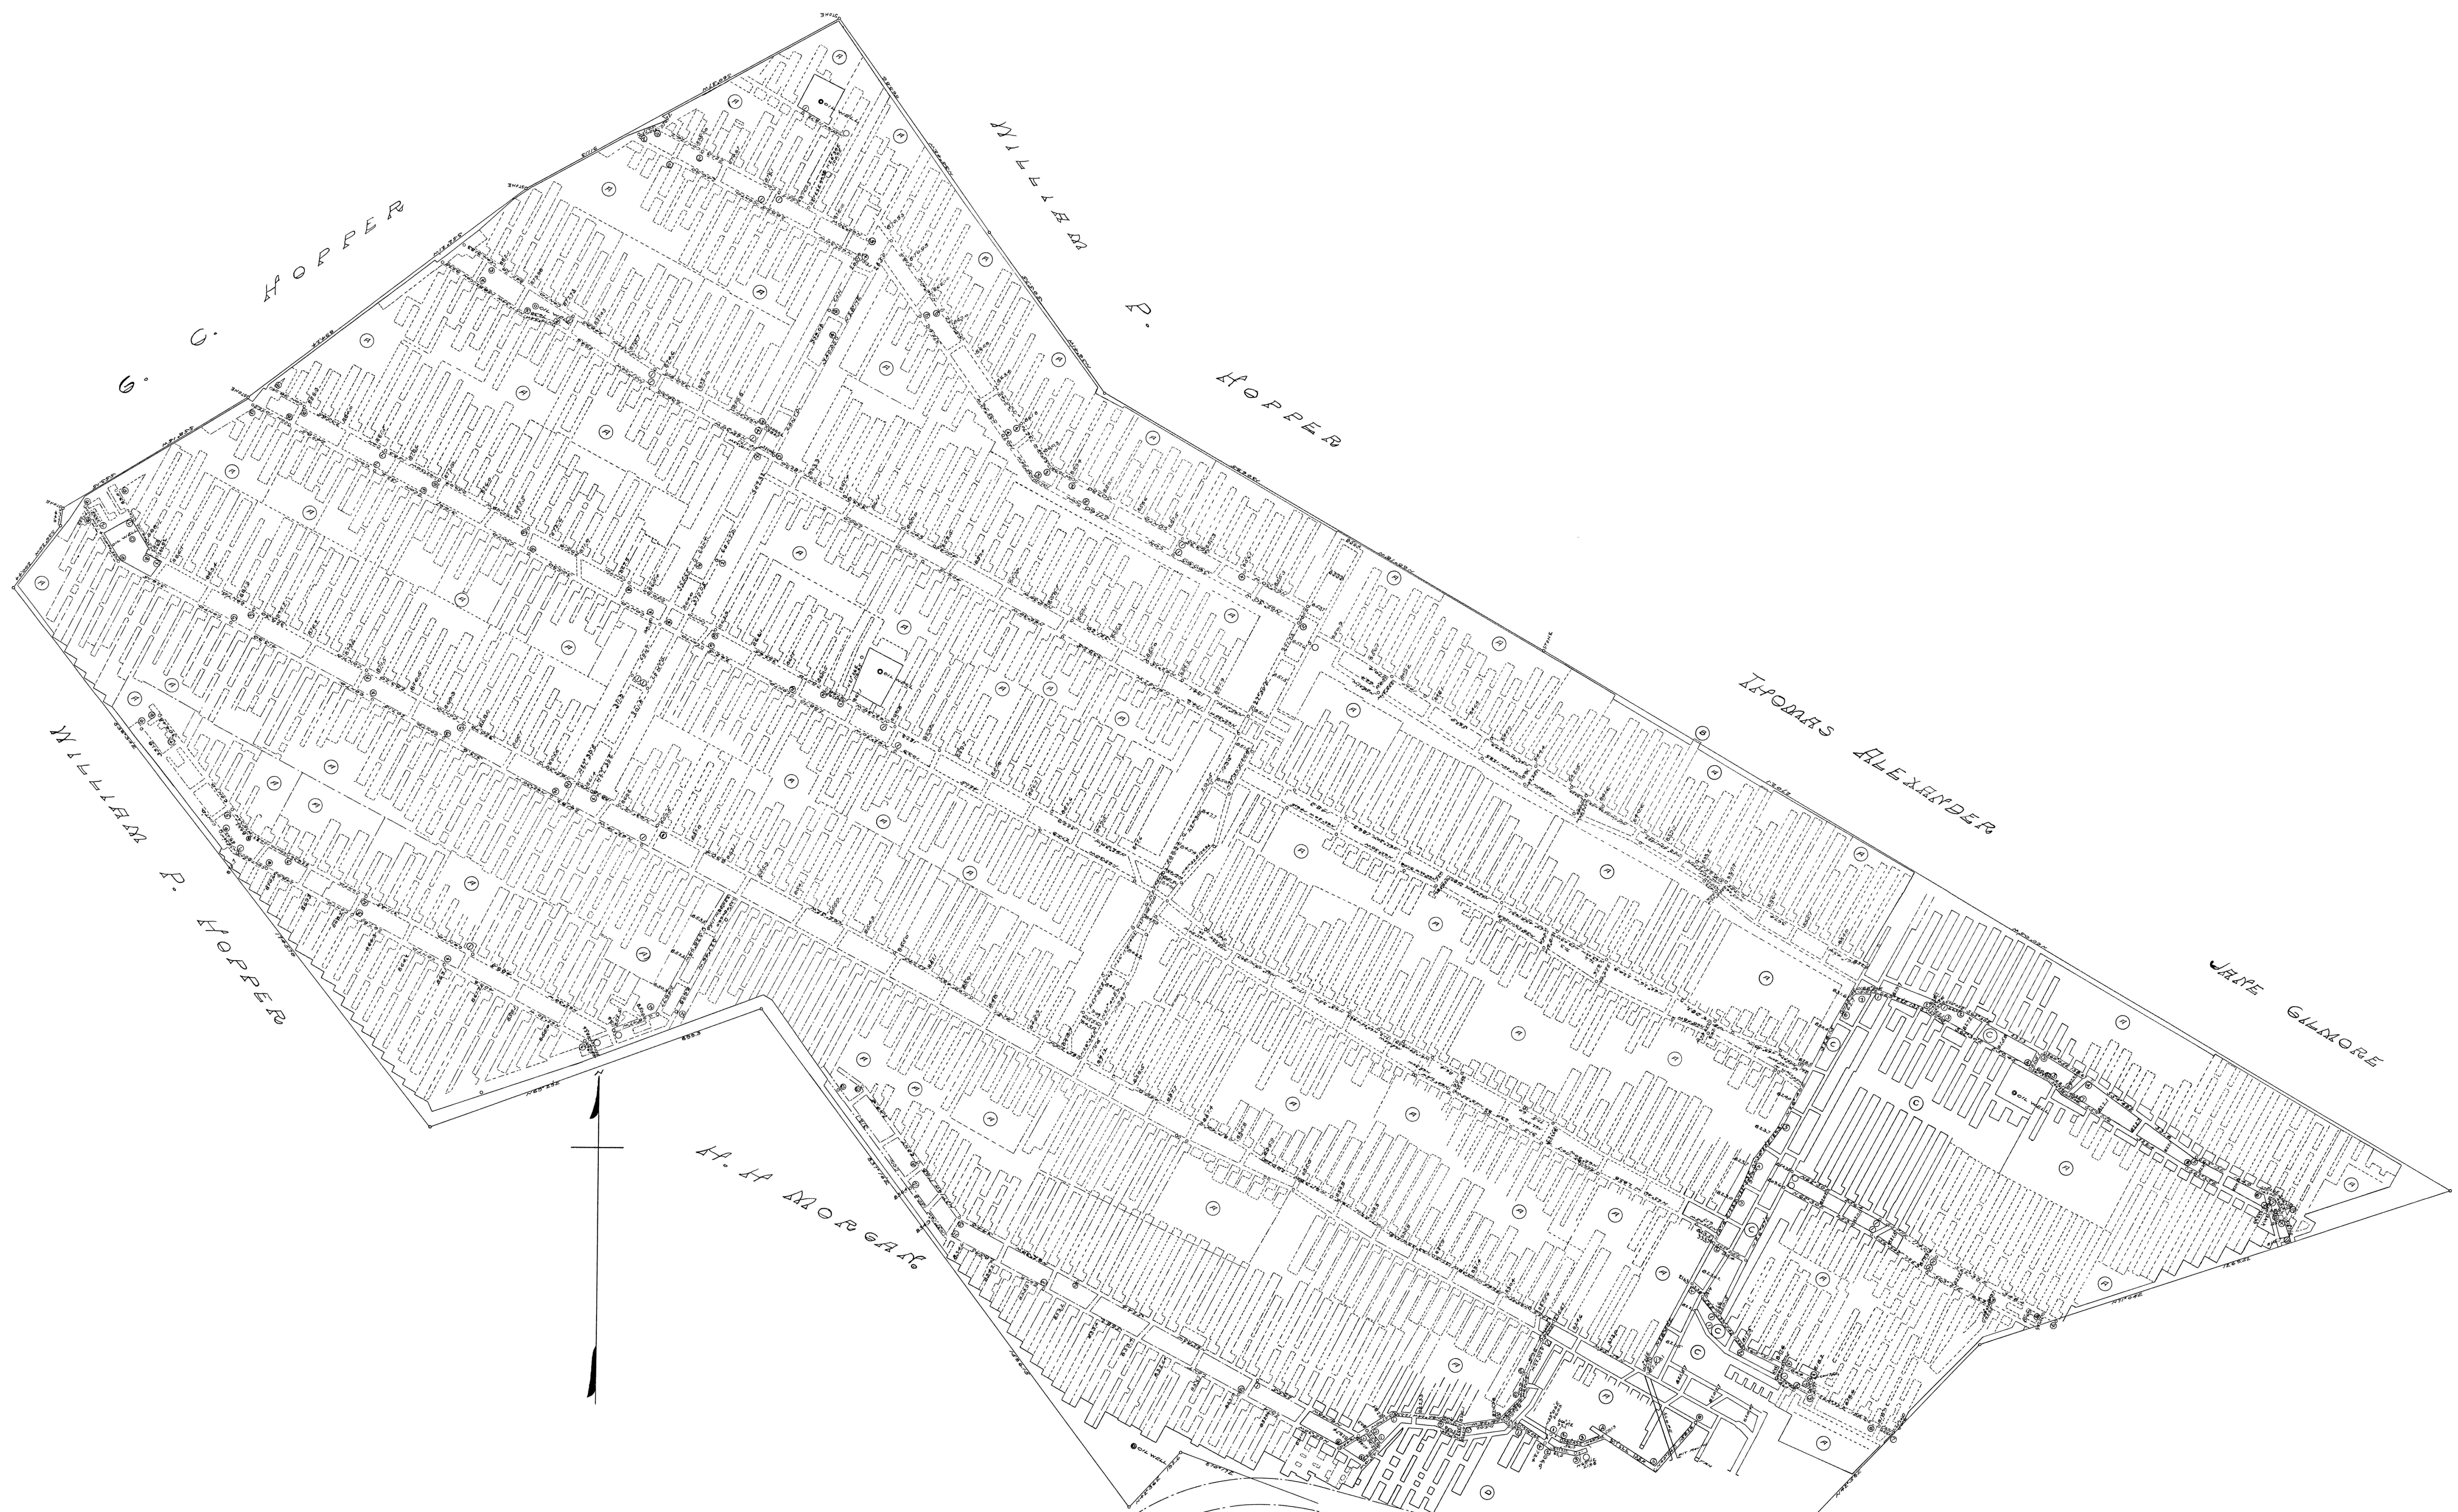

PLAN OF BLYTH MINE
OPERATING AS PAN-HANDLE MINE
OWNED BY JOHN BLYTH MINING COMPANY
LOCATED AT SYGAN BLYTH PENNA.

NOTE:—
① PRESENT OUTLINE OF WORKINGS INDICATED BY RED FIGURES
② MINED ABOVE SHADOWN IN RED FIGURES
③ OVER LINE (SETTLED BY AGREEMENT)
④ SHELLOW SURFACE
⑤ SELL CO. APPROVED BY ACCOUNT OF BRINE FLOODED BY MILLERS RUN

ANDREWS & SOUTHWORTH ENGINEERS,
303-310 CURRY BLVD., PITTS. PA.
Approved by *Chas. R. McKeown*, Mine Inspector