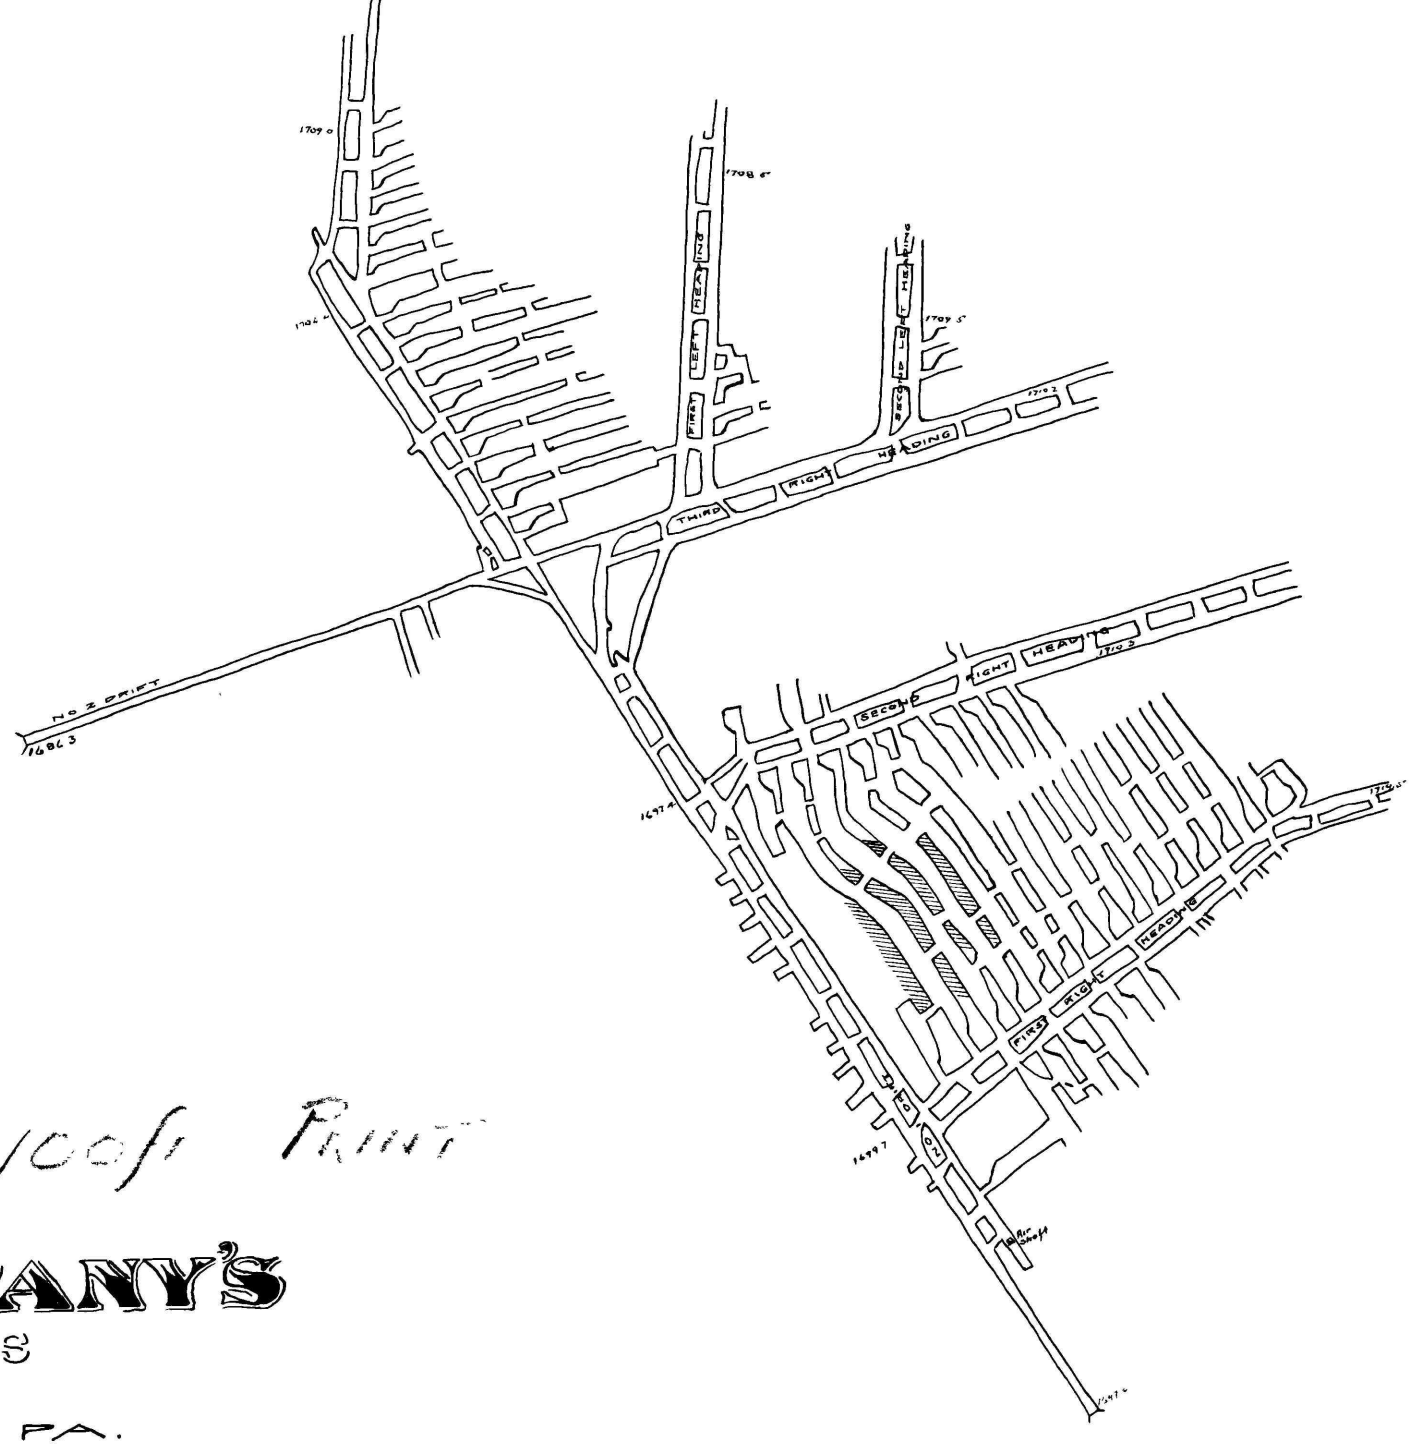

USE 100# PRINT

MAP OF THE

TIOGA COAL COMPANY'S

BLOSS VEIN WORKINGS

AT

RATTLER TIOGA COUNTY PA.

SCALE 1"=200' FEBRUARY 1908 OFFICE OF THE GENERAL SUP'T. MORRIS PENN'A.