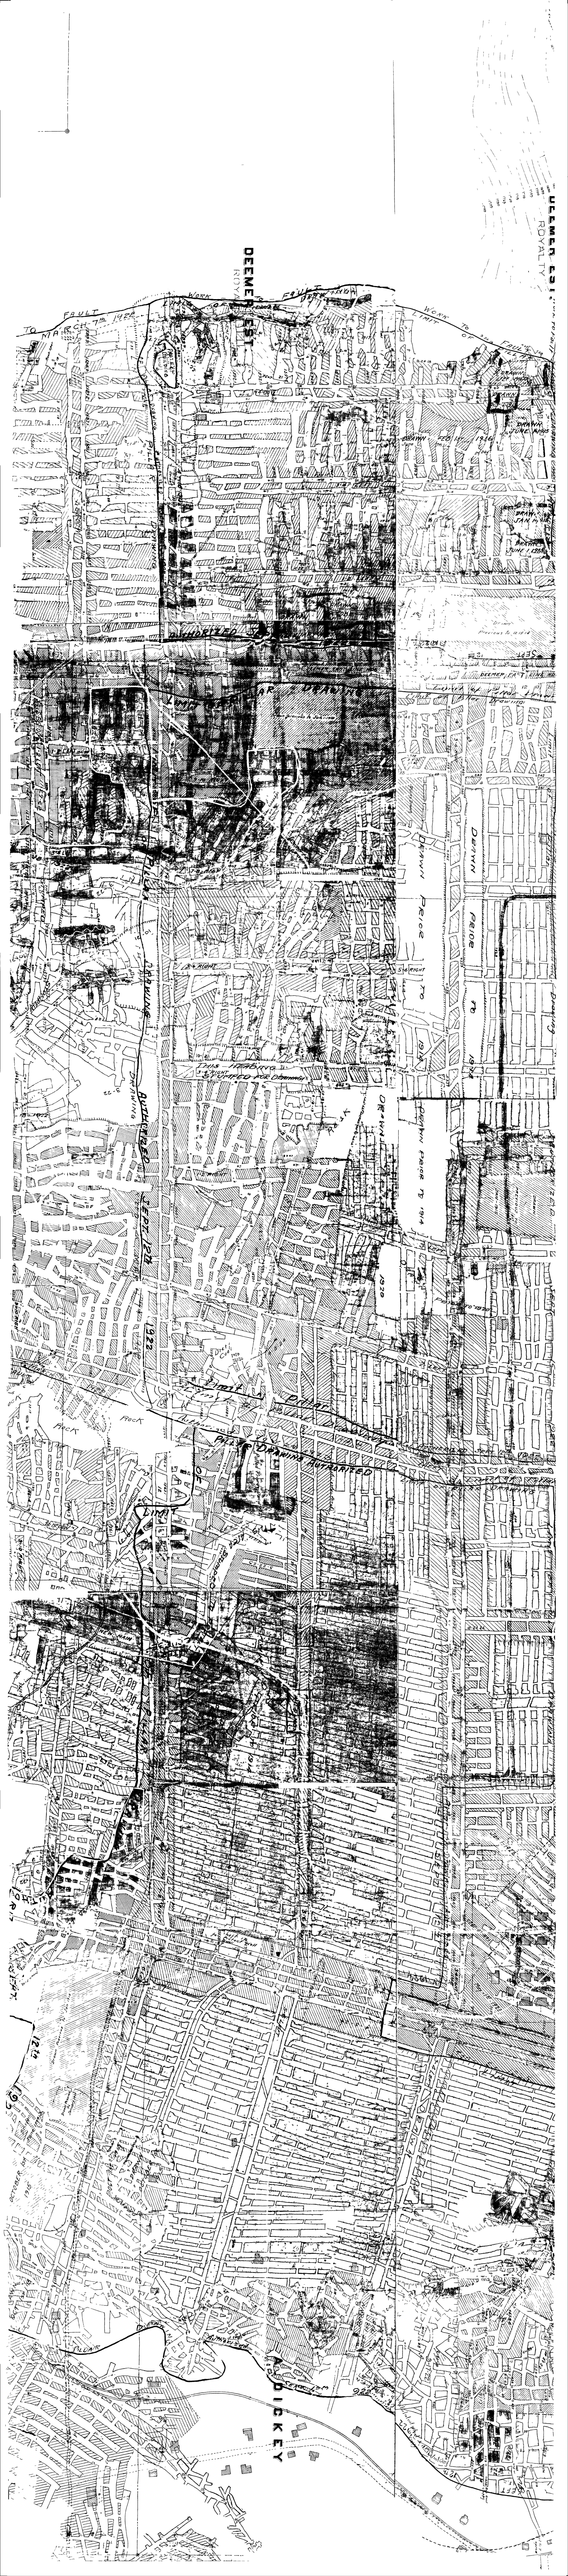

DEEMER EST.
ROYALTY
DEEMER EST.
ROYALTY
WORK TO FAULT
LIMIT OF PILLAR DRAWING
FAULT
TO MARCH 7th 1922
PROTECT BUILDING
PILLAR DRAWING AUTHORIZED
DRAWN FEB 1ST 1916
DRAWN FEB 1916
DRAWN JUNE 1 1915
DRAWN JAN 1 1915
DRAWN JUNE 1 1915
3-4 LEFT
Drawn Previous to 12.15.14
DEEMER EAST MAIN
LIMIT OF PILLAR DRAWING
Drawn previous to Jan 1 1915
DRAWN PRIOR TO 1914
DRAWN PRIOR TO 1914
DRAWN PRIOR TO 1914
5-6 RIGHT
3-4 RIGHT
THIS HEADING STUMPED FOR DRAWING
PILLAR DRAWING AUTHORIZED SEPT 12th 1922
Rock
Rock
1920
PILLAR DRAWING AUTHORIZED
LIMIT OF PILLAR DRAWING
AUTHORIZED SEPT 12th 1922
NEW MAIN
Drawn Previous to Jan 1915
12th
October 1st 1915
DRAWN OCTOBER
PILLAR
A. DICKEY
SEPT 12th 1922
3-4 LEFT
TO 1914