


(Perryfield)
78° 30'
41° 00'

LEWISTOWN 7.3 MI.
CLEARFIELD 2 MI.

(Clearfield 63 500)

(Clearfield)
78° 22' 30"
41° 00'

BIGLER 4.3 MI.
PHILIPSBURG 12 MI.

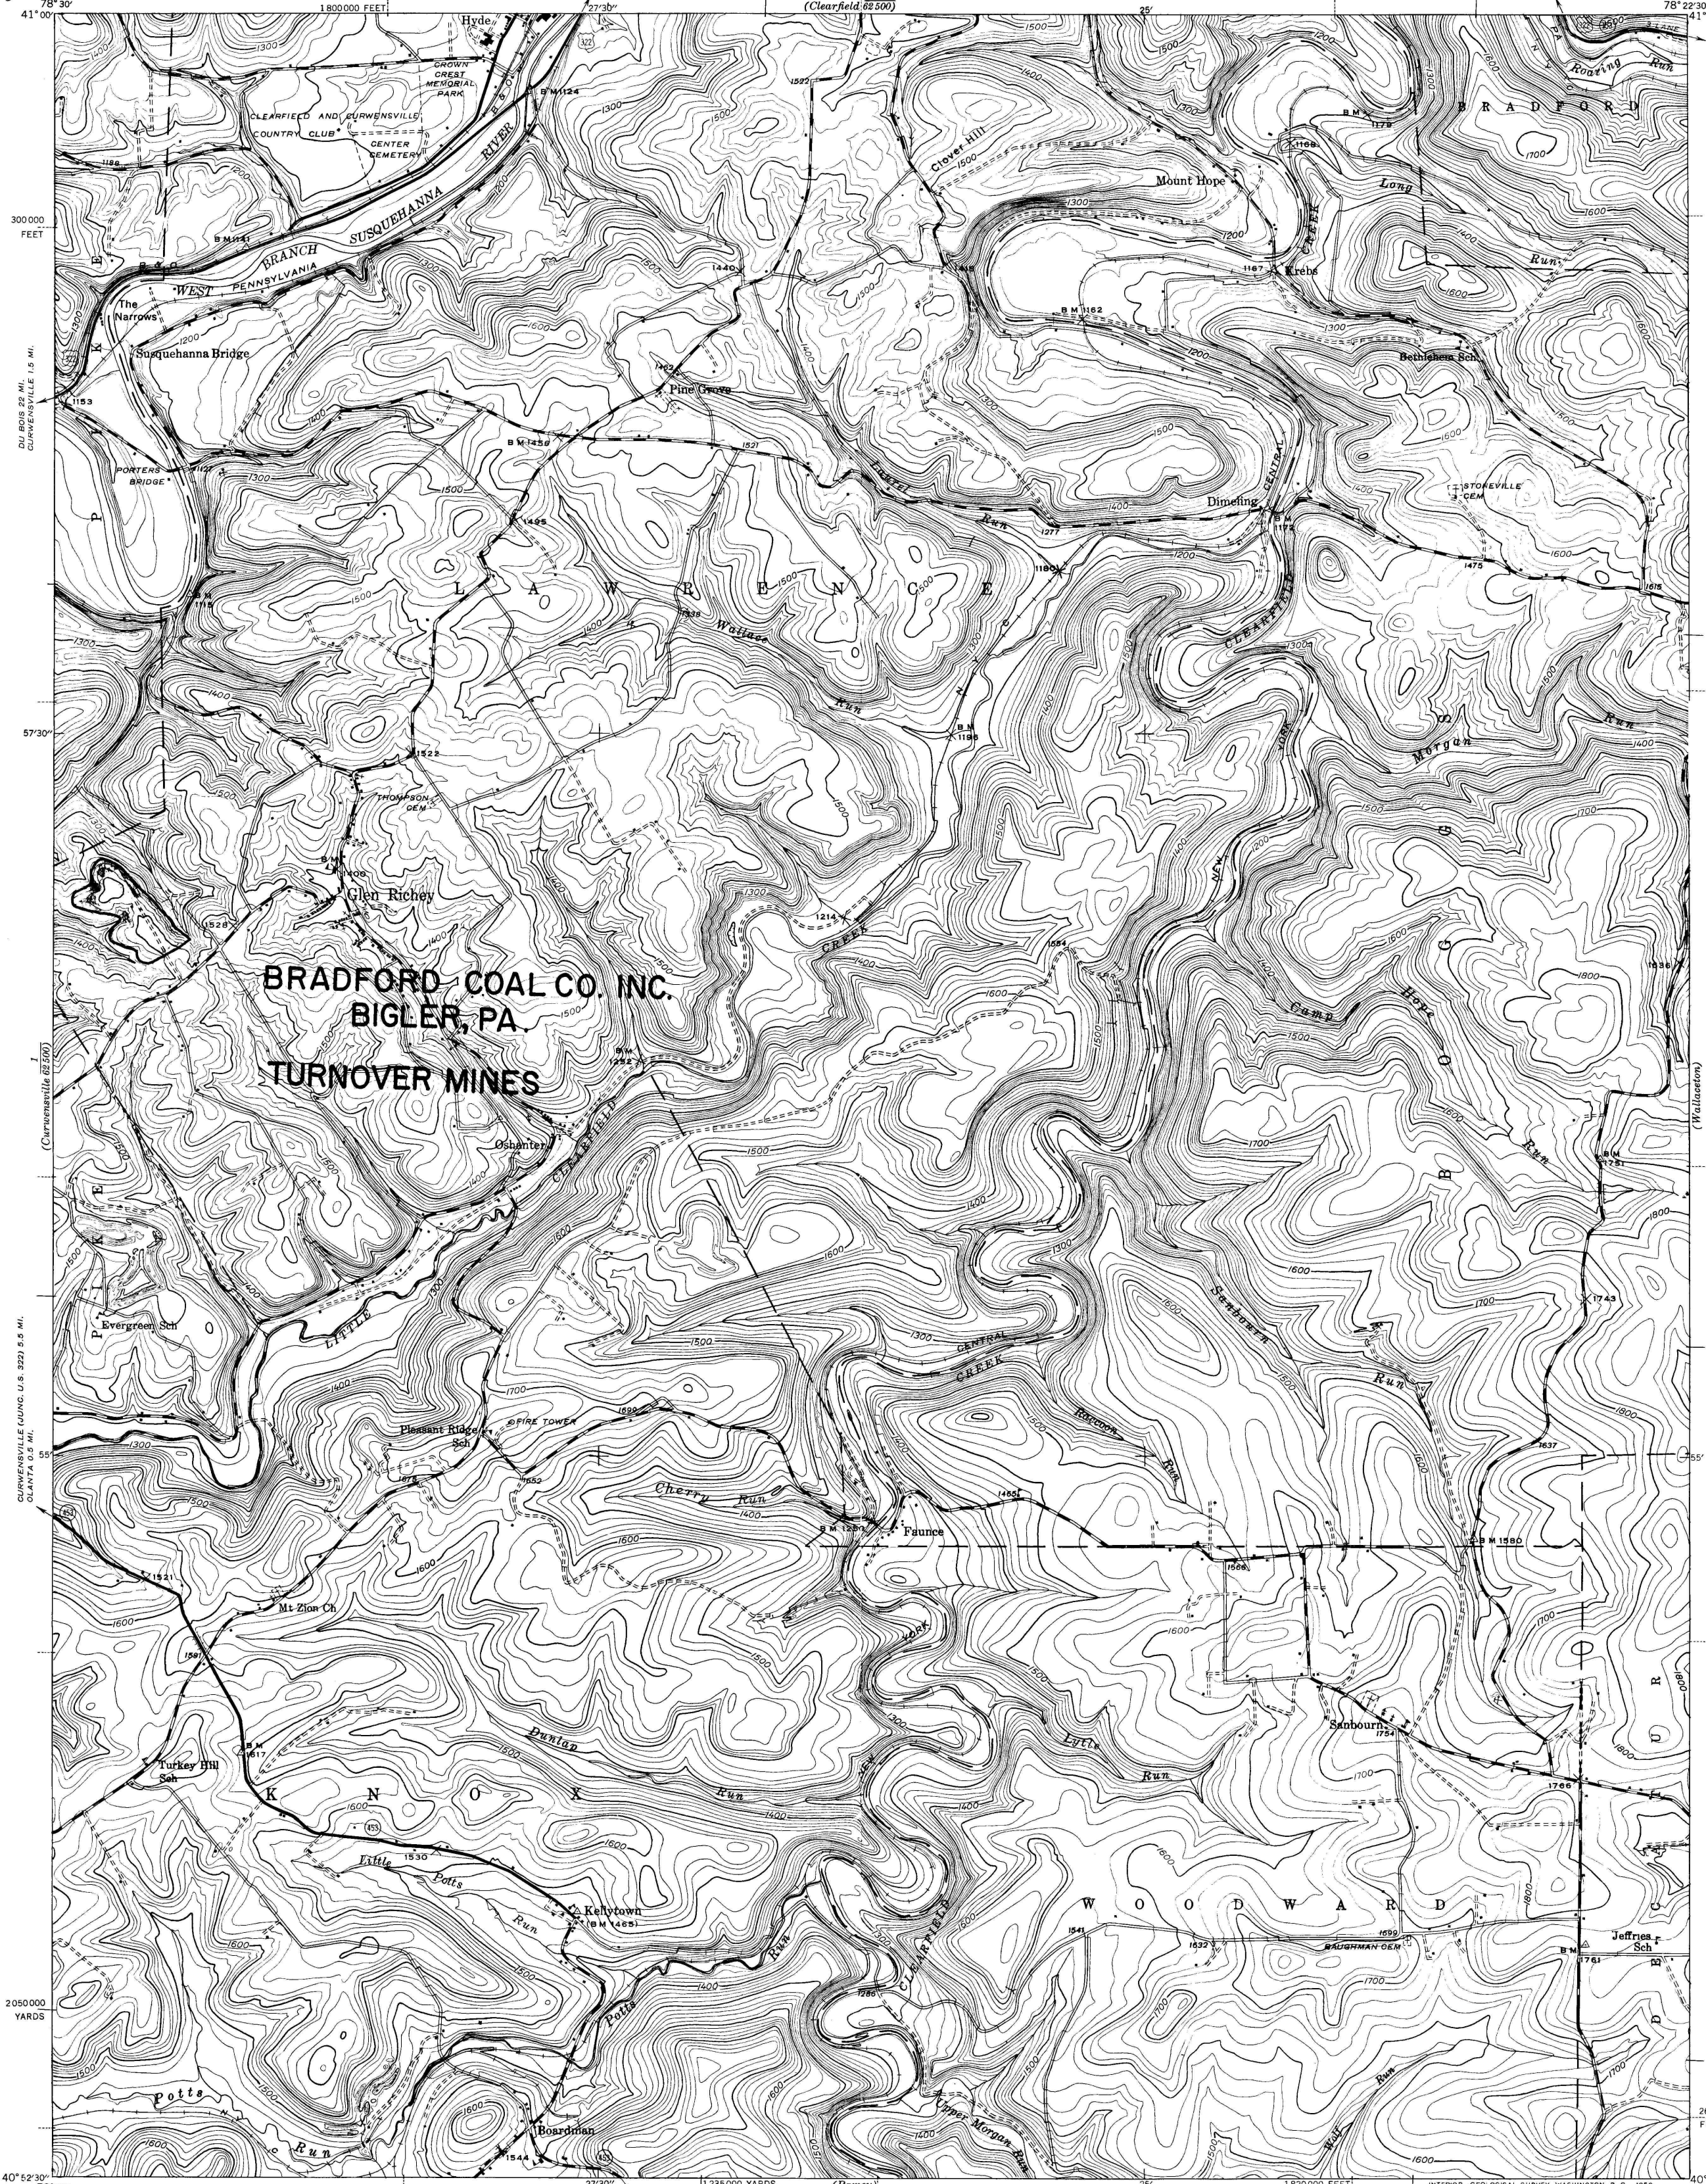

Mapped by the Geological Survey
1944

SCALE 1:24,000

INTERIOR - GEOLOGICAL SURVEY, WASHINGTON, D.C. 1956
M.R. 1972
Polyconic projection, 1927 North American datum
5000 yard grid based on U. S. zone system, B
10000 foot grid based on Pennsylvania (North)
rectangular coordinate system

ROAD CLASSIFICATION
Heavy-duty ——— 4 LANE 6 LANE Light-duty ———
Medium-duty ——— 4 LANE 6 LANE Unimproved dirt ———
U. S. Route ——— State Route ———

APPROXIMATE MEAN
DECLINATION, 1944

Contour interval 20 feet
Datum is mean sea level

LAWRENCE TOWNSHIP
CLEARFIELD COUNTY
PERMIT NUMBER - 309-1
"E" - OR UPPER FREEPORT SEAM

FOR SALE BY U. S. GEOLOGICAL SURVEY, WASHINGTON 25, D. C.
A FOLDER DESCRIBING TOPOGRAPHIC MAPS AND SYMBOLS IS AVAILABLE ON REQUEST

GLEN RICHEY, PA.

N4052.5-W7822.5/7.5
1944

FIELD COPY