

PLAN
 OF
 MINE WORKINGS
 OF
 THE EAST FAYETTE COAL CO.
 STEWART TOWNSHIP
 FAYETTE CO., PA.
 JULY 31, 1920.
 S.M. FOUST, C.E.
 J.E.H.
 LOWER KITTANNING COAL.

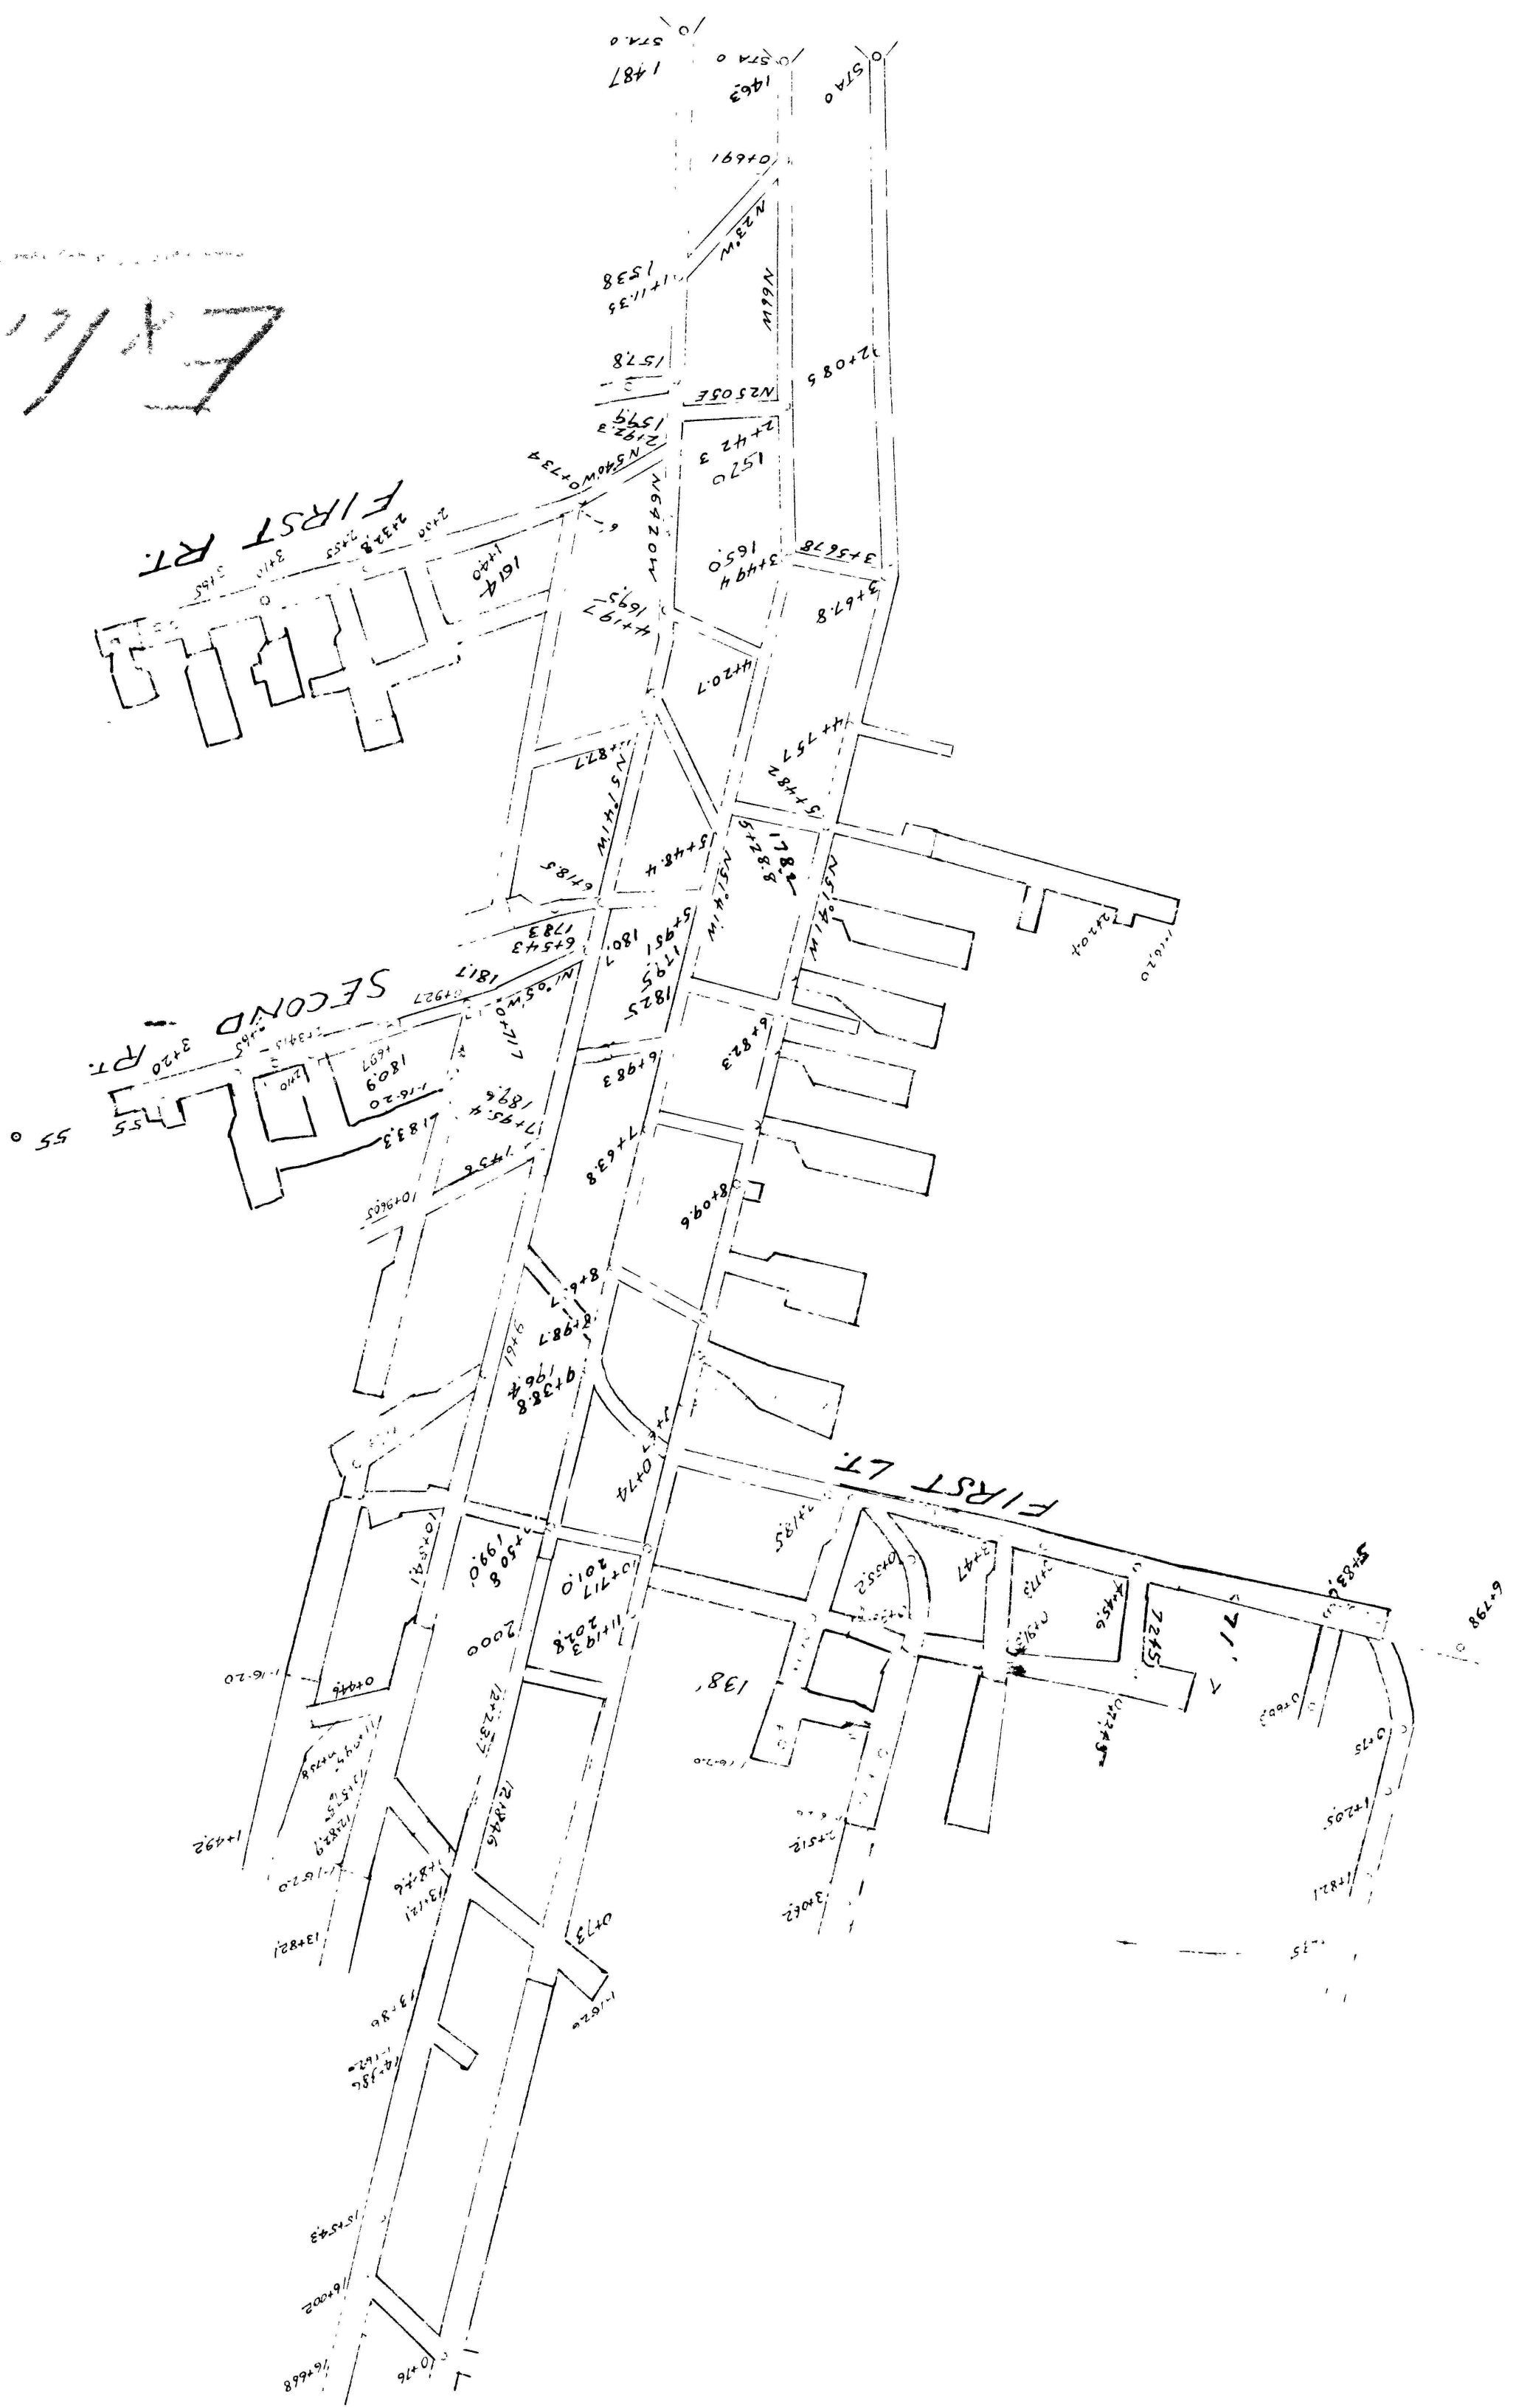


Exhibit B
 N 81° 19' E