
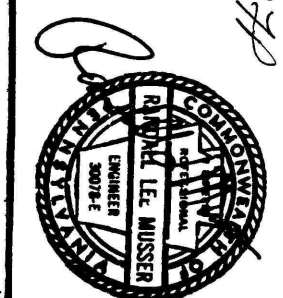
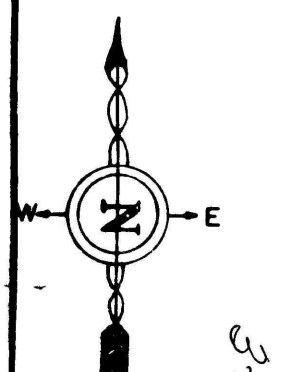


PLAT BOOK 4 DRAWER 11A
PAGE 49A

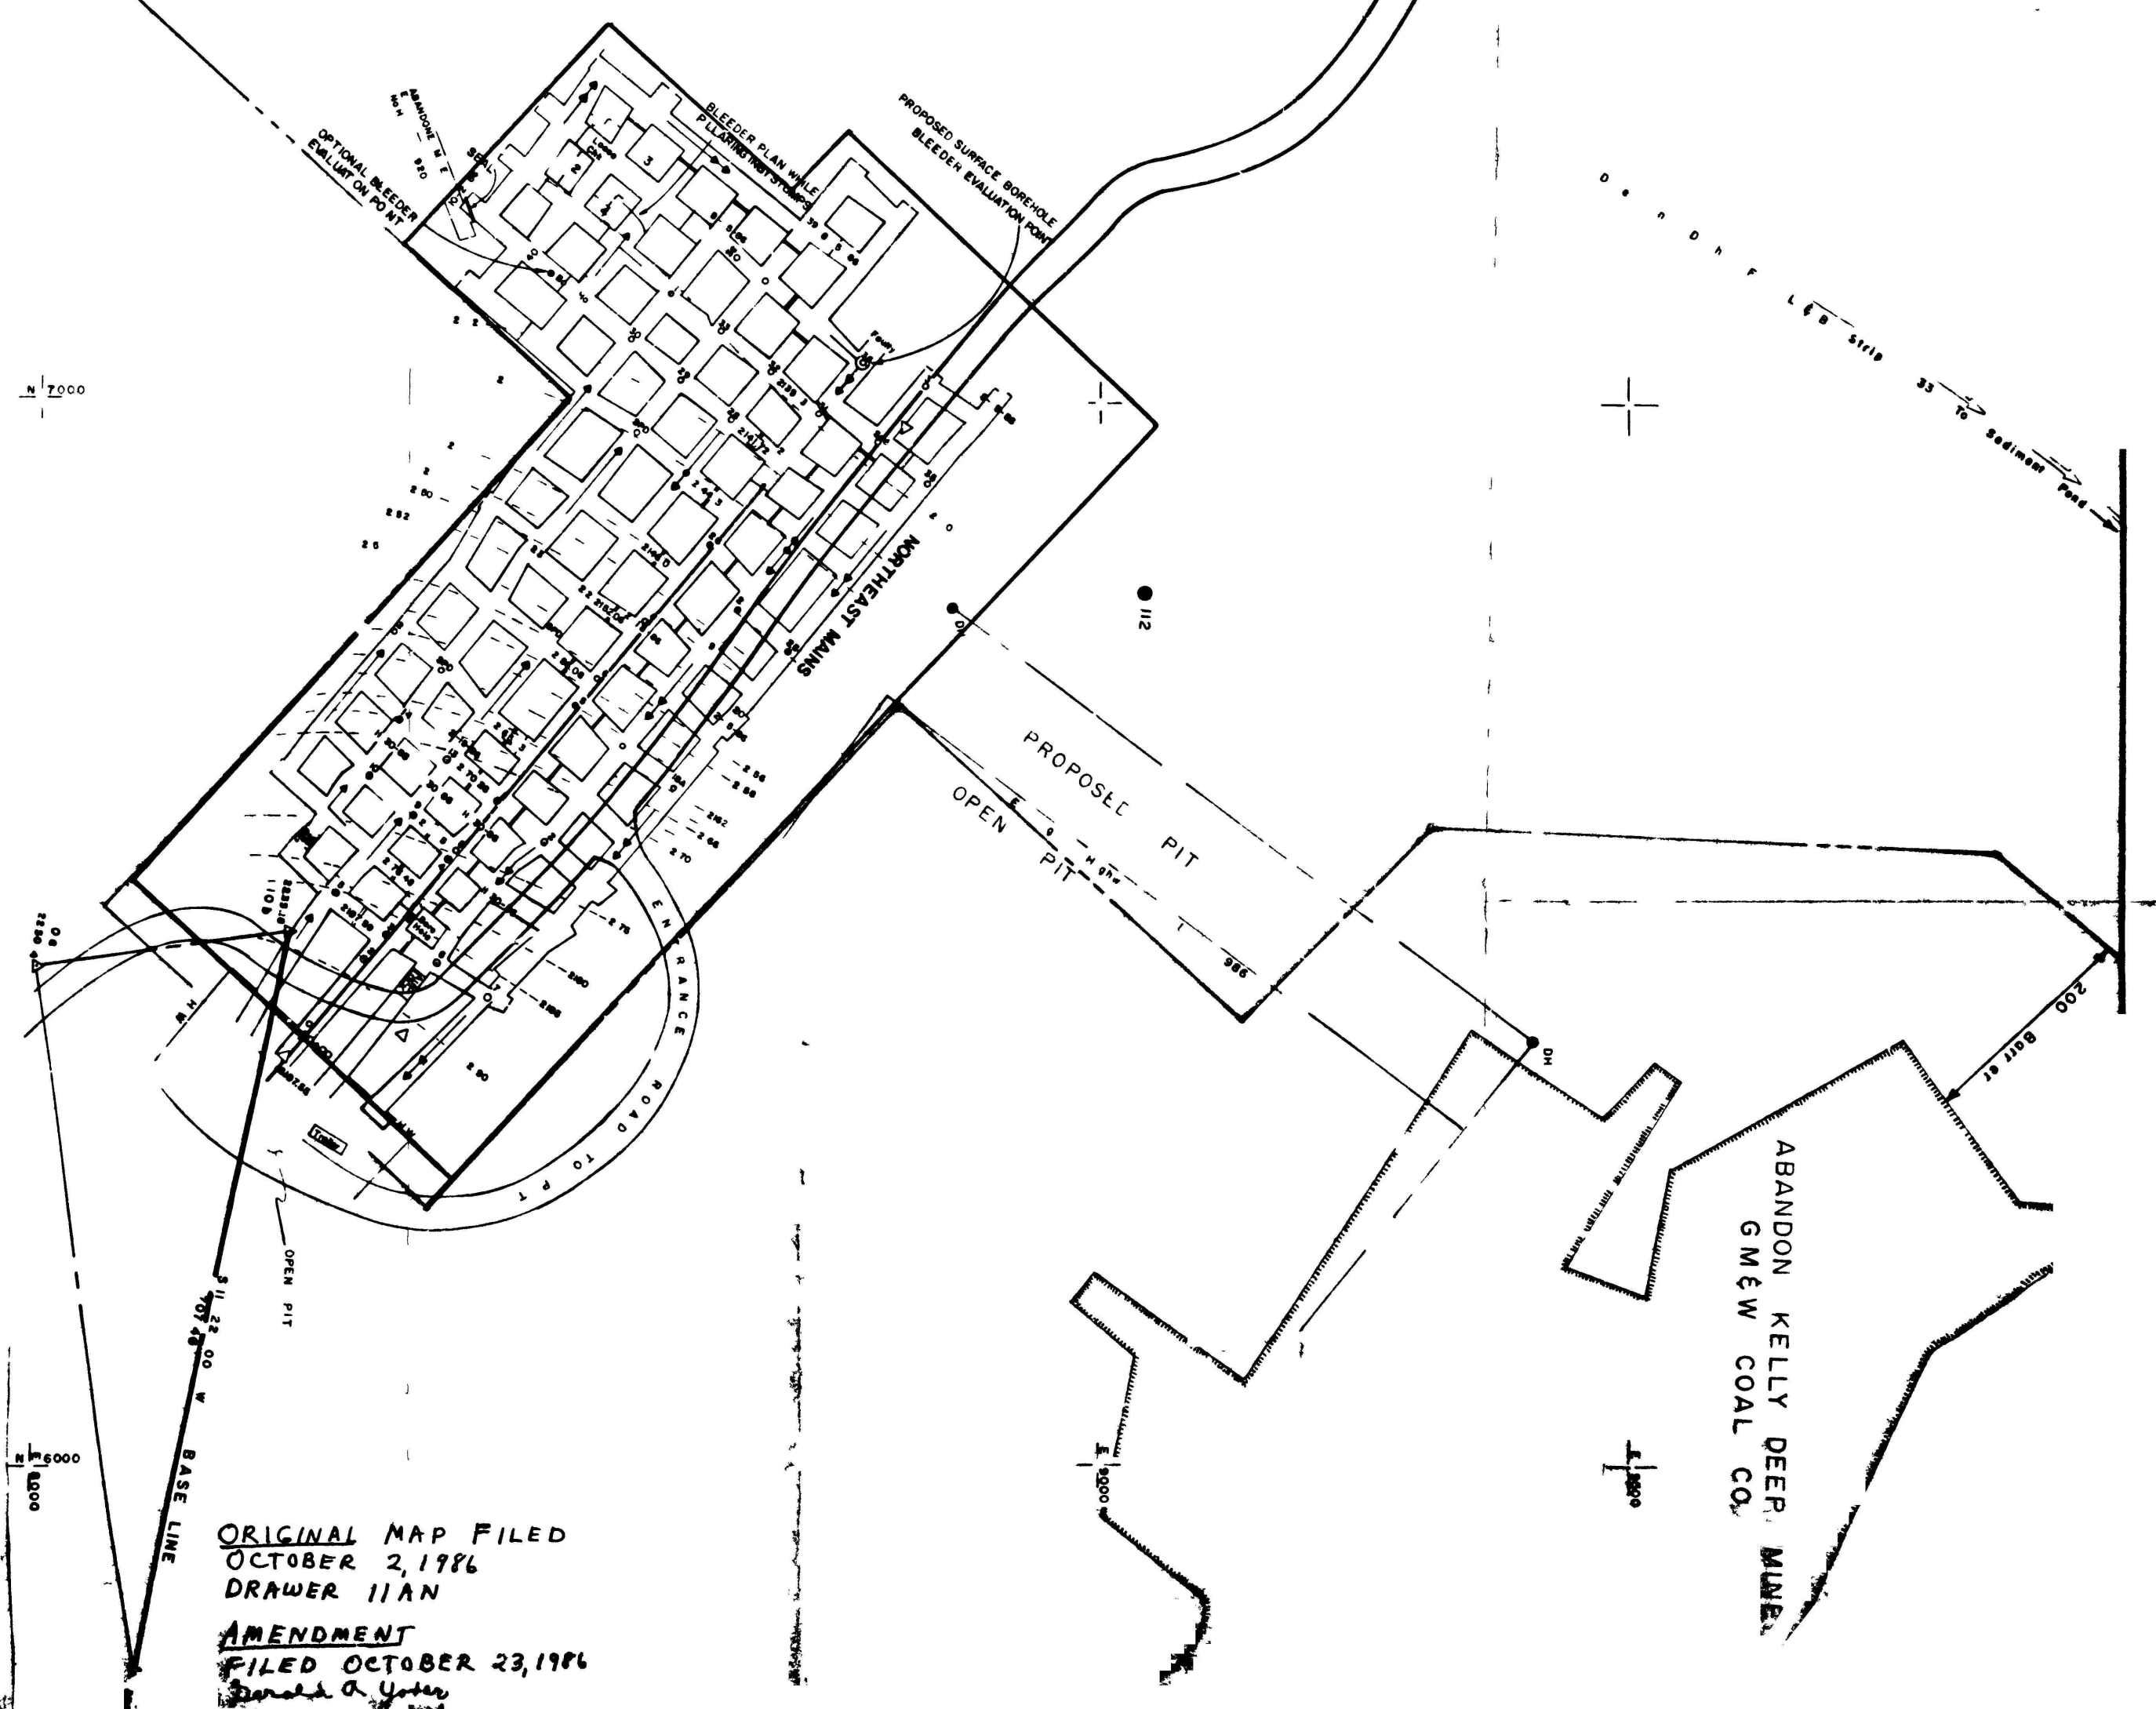

SUBSIDENCE AMENDMENT

Subsidence Permit No 0584301

Mine Subsidence Exhibit "B"

Zelanka Coal Company

TOWERS MINE — KELLY SEAM

Brook Township Bedford County, Pa.

Scale 1" = 100' Date OCT 14 1986

Drawn by TCM

Checked by

Reviewed by

MUSSEY ENGINEERING

R.O. Central City, Pa.

(184) 364 9432

ORIGINAL MAP FILED
OCTOBER 2, 1986
DRAWER 11A

AMENDMENT
FILED OCTOBER 23, 1986
Donald A. Yoder

ABANDON KELLY DEEP MINE
GM&W COAL CO.