

- Existing Permit Area (2005)
Area to be added to permit (2005)
Status of storage sheds
Residence - Built before the Act of 1966
Residence - Built after the Act of 1966
Structure Identification
Affected surface area

- ① Residence - William & Ann Garrity
② Residence - John & Shari Polomint
③ Residence - [redacted] & [redacted]
④ Residence - Korman (Owens - Oaks)
⑤ CAMP - Peter & Margaret Forough

Amended Area (1989) 35.6 Acres

Area of 100' cover or less

Abandoned Area

EXISTING PERMIT BOUNDARY

SURVIVANCE CONTROL PLAN BOUNDARY 268.8 Acres

SURFACE ACTIVITY SITE 6.0 Acres

▲ MONITORING POINT

● WELL

AREAS TO BE MINED:

1989-1990

1991

1992

LEGEND TO MINES


- A UNKNOWN (abandoned)
B SHADE NO 4 - REITZ COAL COMPANY (active as refuse disposal) Upper B Lower Freeport, Upper Kittanning
C REITZ NO 21 - REITZ COAL COMPANY (inactive) Lower Kittanning
D SHADE NO 5 - SHADE MINING COMPANY (backfilled) Lower Freeport, Upper Kittanning
E UNKNOWN (abandoned) Upper B Lower Freeport, Upper Kittanning
F UNKNOWN (abandoned)
G UNKNOWN (abandoned)
H ELMA NO 1 MINE
I ELMA NO 2 MINE
J ELMA NO 3 MINE BAKER WHITELY COAL COMPANY (abandoned) Upper Kittanning
K KNICKERBOCKER NO 1 MINE
L KNICKERBOCKER NO 2 MINE
M KNICKERBOCKER NO 3 MINE
N REITZ NO 21 MINE
O SOLAR NO 4 MINE
P SOLAR NO 3 MINE SOLAR FUEL COMPANY (abandoned) Upper Kittanning
Q WILBUR NO 4 MINE

▲ Samples collected by Reitz Coal Co. (see enclosed analyses)

NOTE: All barriers are minimum of 200 feet from crop lines for all protection works. Scaled distance on print may differ due to shrinkage during copying.

▲ SURF. EL. 2244
● SURF. COAL

JUL 08 2005

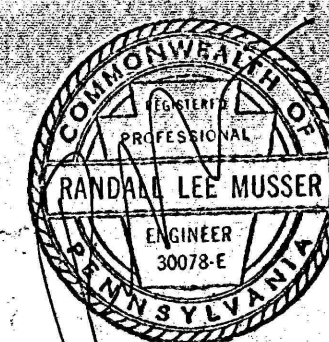

I, Randal L. Musser, a Professional Engineer in the Commonwealth of Pennsylvania, hereby certify that the surveying and mine mapping conducted by Musser Engineering, Inc. after August 9, 1994 was conducted in accordance with generally accepted surveying standards for the mining industry, and is true and correct to the best of my knowledge and belief. All base map preparation for this mine, and all mine surveying and mapping prior to August 9, 1994 was conducted by and certified by other engineering consultants.

MSHA NOTE: Adjacent UK Mines are shown on this Map. UK Mine map and a Hritz Trent #1 Mine Overlay show related Mining below. There is no mining above the Hritz Mine.

EXHIBIT 19.2 MAP
EXHIBIT 19.3 MAP
mine Development Map

TRENT COAL, INC.

HRTIZ (TRENT #1) MINE

UPPER KITTANNING COAL SEAM
SHADE TOWNSHIP SOMERSET COUNTY, PA

Scale 1" = 400' Date

MEI Musser Engineering, Inc.
7785 Lincoln Hwy., Central City, Pa. 15926
914-731-3474

RECEIVED

JUL 08 2005

Dept. of Environmental Protection
California District Office

FINAL MAP

NOTE: ORIGINAL MAPPING BY EARTHTECH

Revision