

Subsidence Legend

CONTEMPLATED MINING: From _____ to _____

PREVIOUS SIX MONTH'S MINING: _____

PROTECTED STRUCTURES: [Symbol]

SUPPORT AREAS: [Symbol]


MINING COMPLETED: [Symbol]

LIMITS OF PERMIT: _____

COAL CONTOURS: _____ 2100 _____

1989-1990 [Symbol]
 1991 [Symbol]
 1992 [Symbol]
 Area of 100' cover or less [Symbol]

I, Randall L. Musser, a Professional Engineer in the Commonwealth of Pennsylvania, hereby certify that the surveying and mine mapping conducted by Musser Engineering, Inc. after August 9, 1994 was conducted in accordance with generally accepted surveying standards for the mining industry, and is true and correct to the best of my knowledge and belief. All base map preparation for the mine, and all mine surveying and mapping prior to August 9, 1994 was conducted by and certified by other engineering consultants.

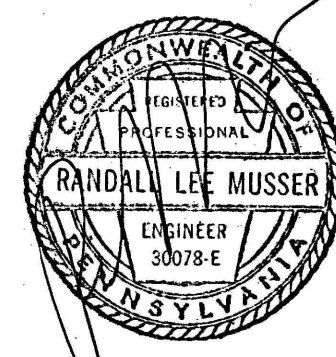

FINAL MAP

PREPARED FOR: CMAP 5683/01 RECEIVED
TRENT COAL, INC.
 JUL 08 2005
HRITZ (TRENT NO. 1) MINE
 UPPER KITTANNING COAL SEAM
 SITUATE
 SHADE TOWNSHIP, SOMERSET COUNTY, PENNSYLVANIA
 SCALE: 1"=100'
 PREPARED BY: 7765 Lincoln Hwy., Central City, PA 15929
 (610) 754-8477
Musser Engineering Inc.

SHEET 5 of 6