


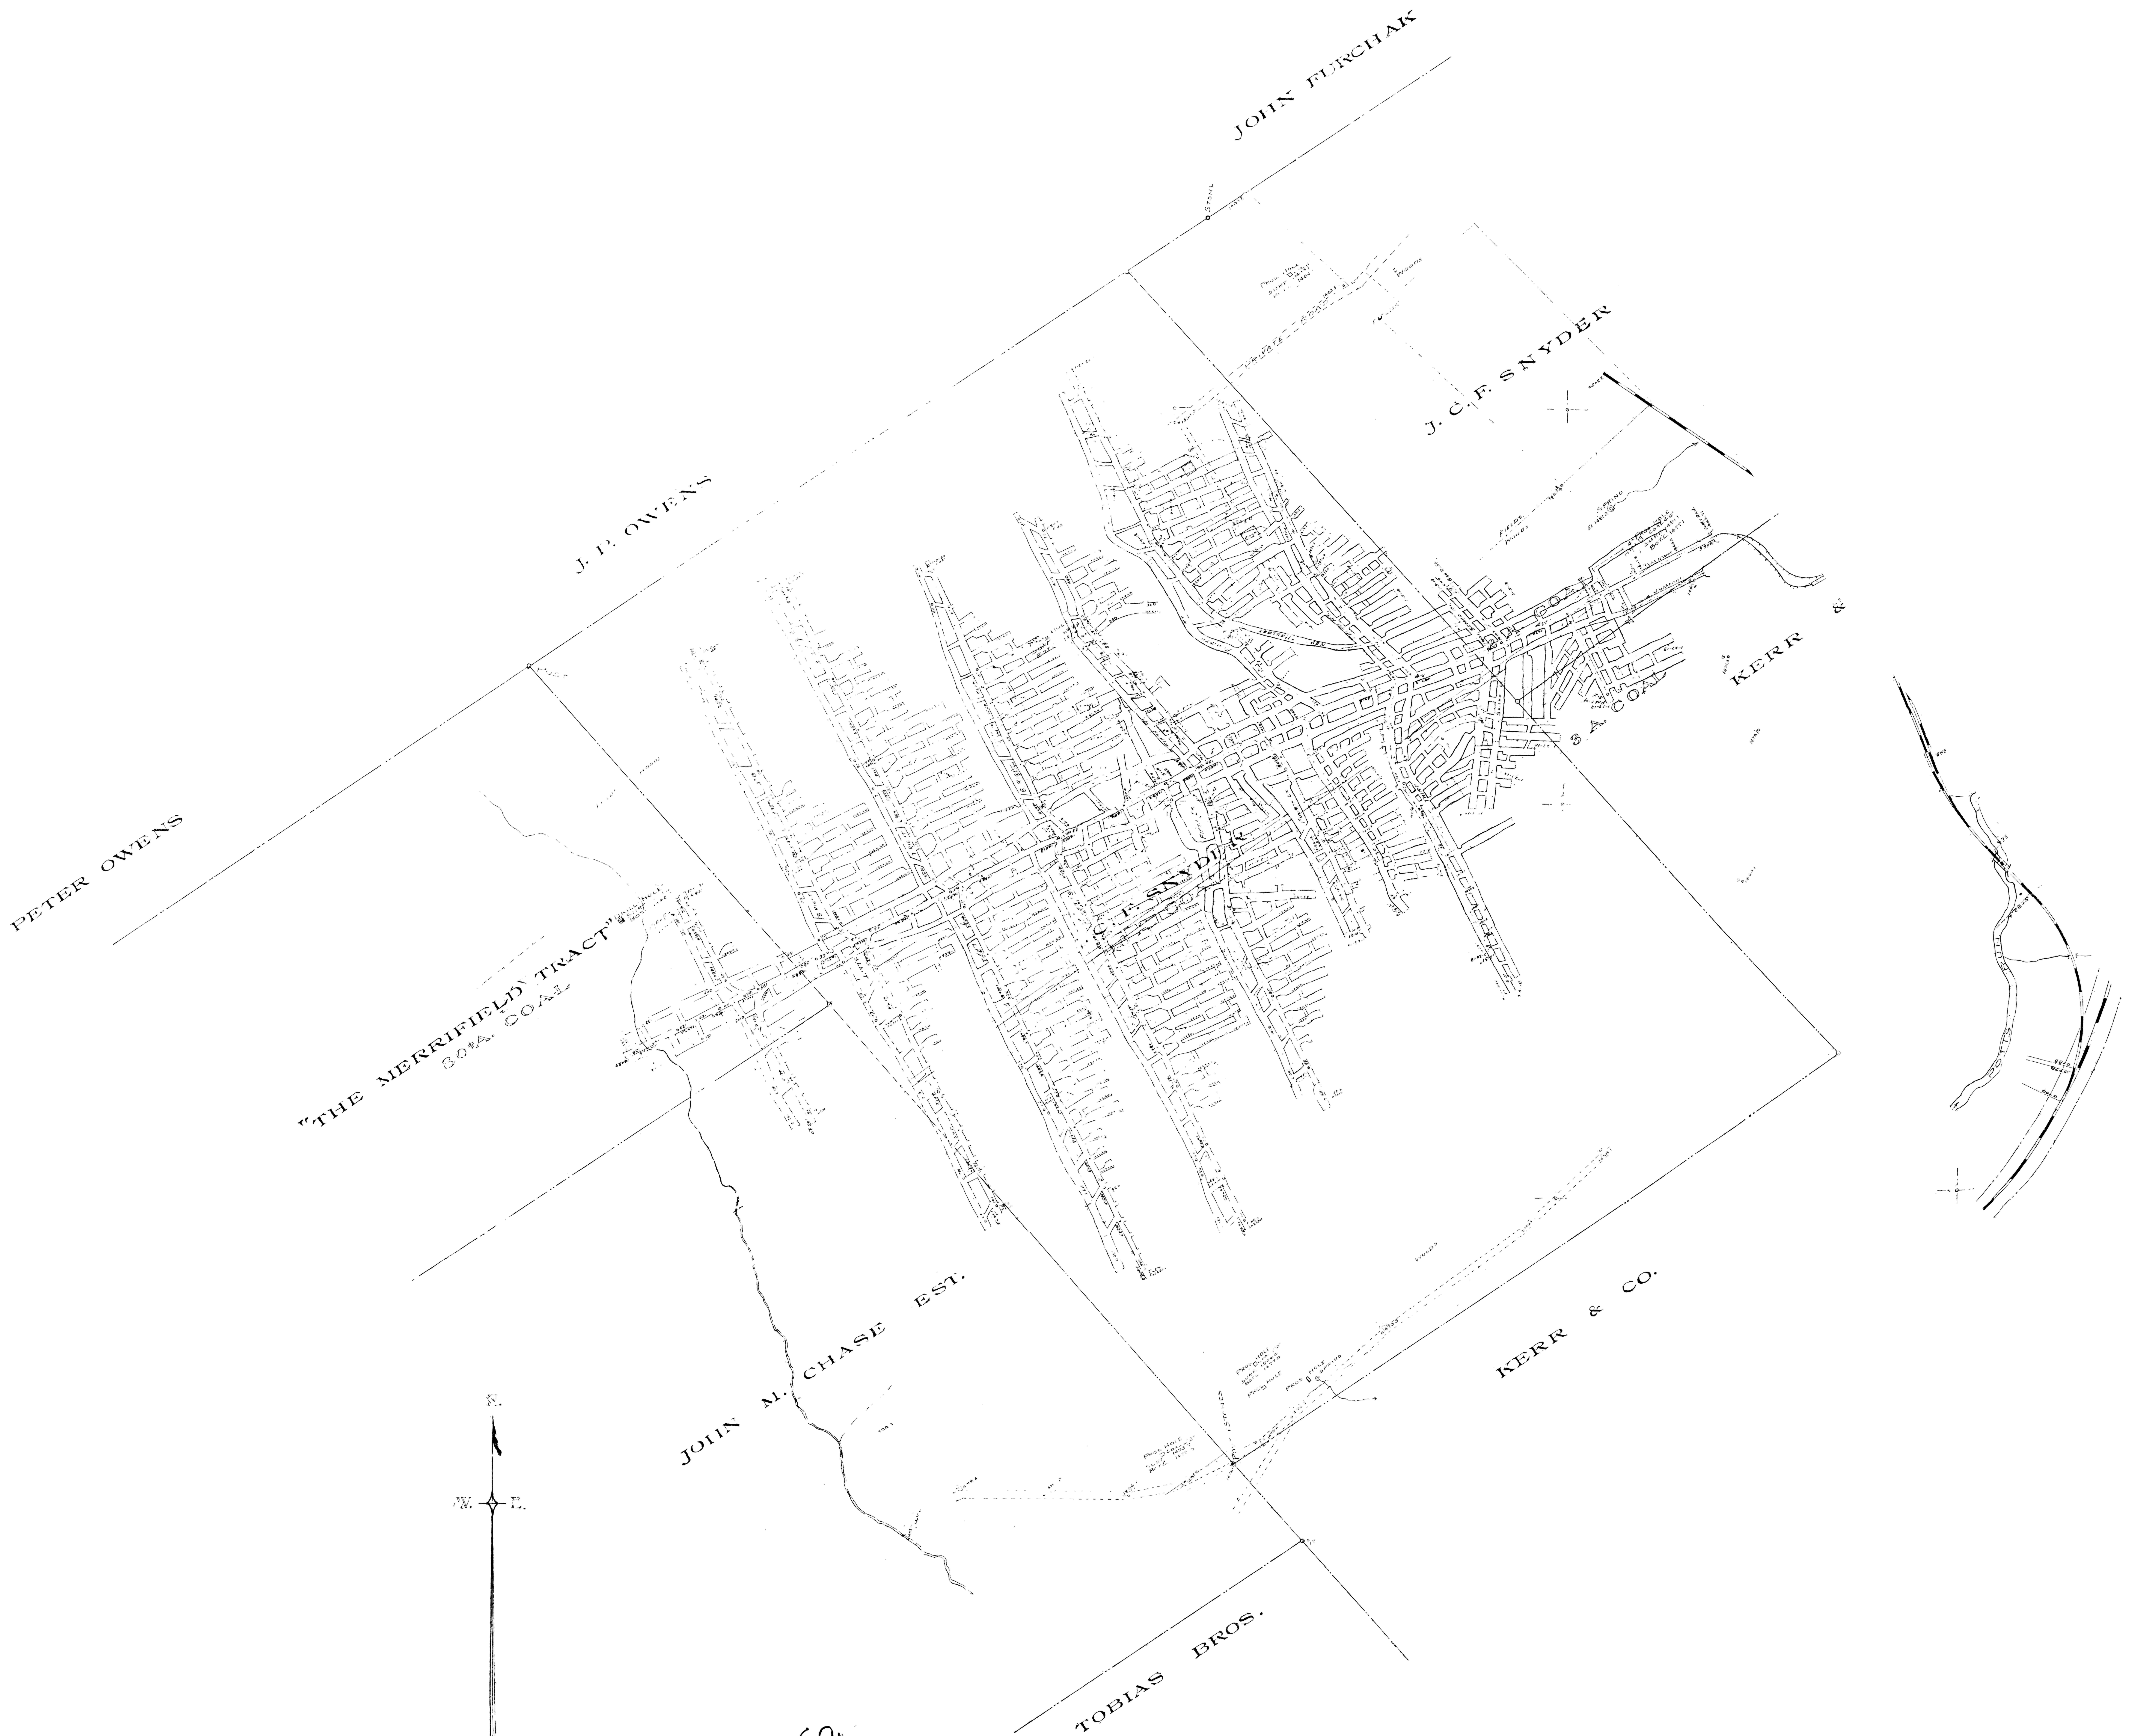

BOARDMAN MINING CO.
MAP OF
NO. 4 MINE
BOARDMAN, KNOX TWP., PENNA.
Scale 1"=100'
Resurveyed
January 1908
May 1908
Office of E. W. Hess
Engineer