


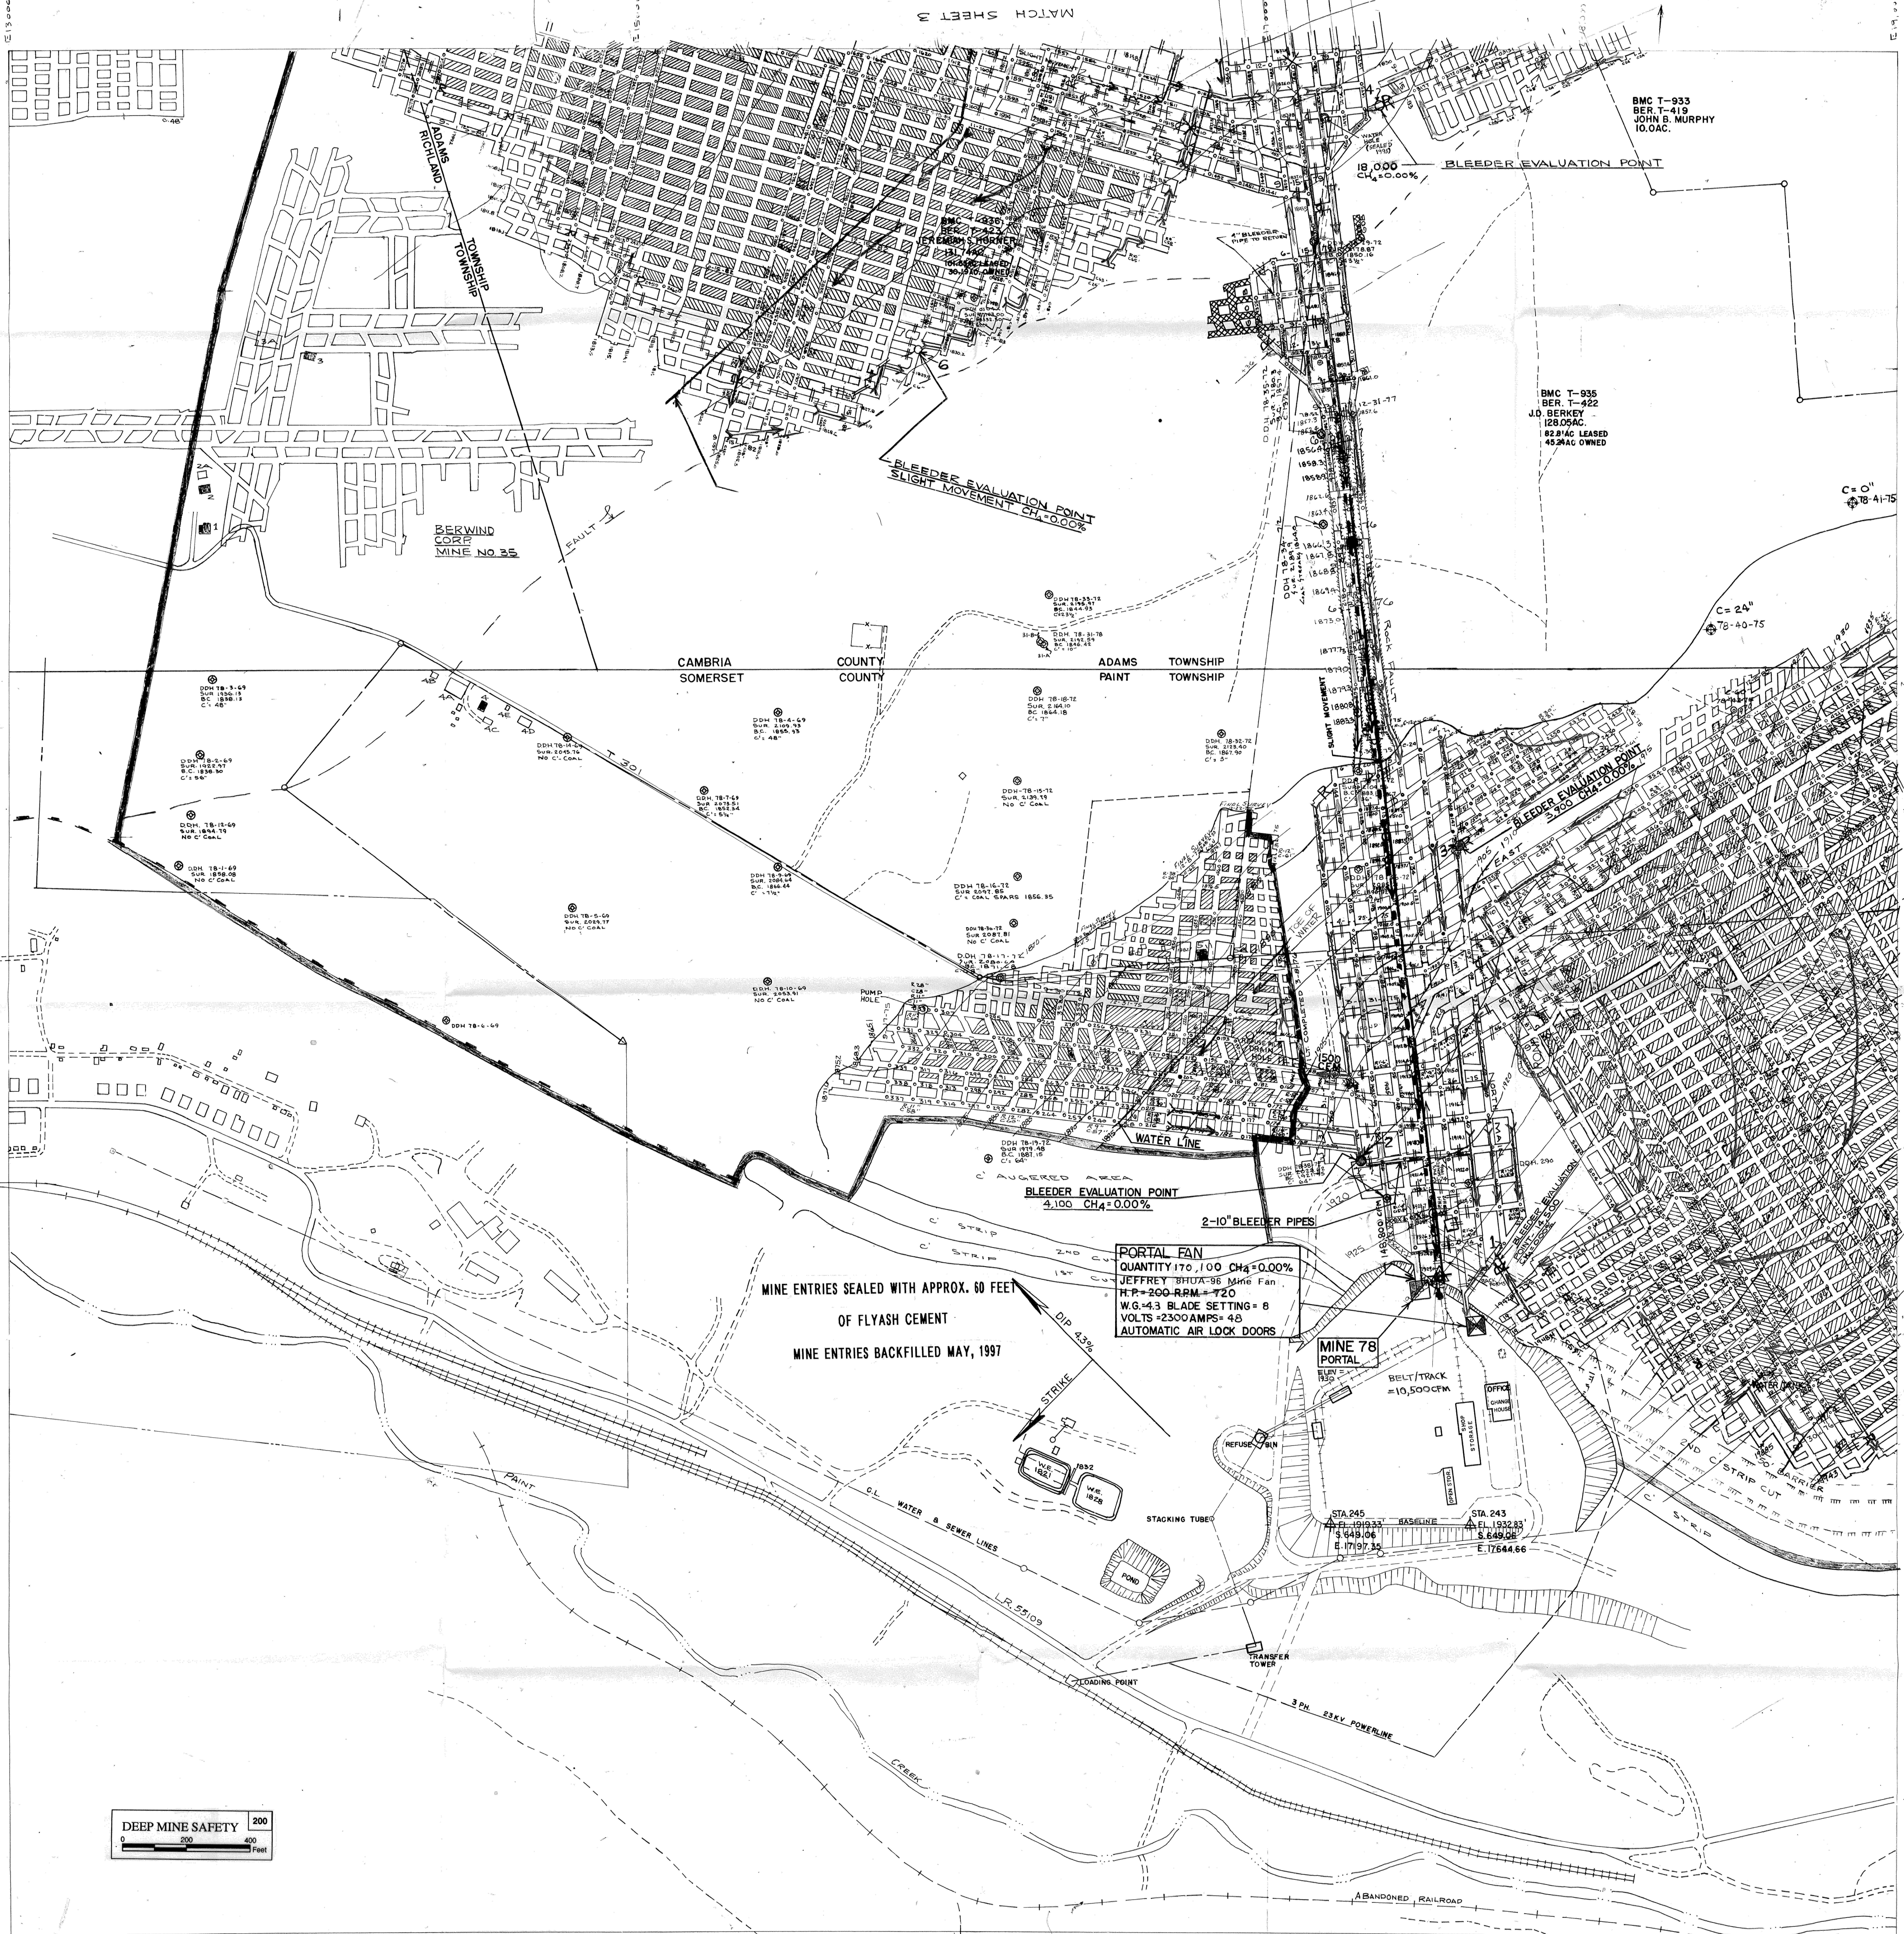

BMC T-933
BER T-419
JOHN B. MURPHY
10.0AC.

BMC T-935
BER T-422
J.D. BERKEY
128.09AC.
82.9AC LEASED
45.2AC OWNED

PORTAL FAN
QUANTITY 170,100 CH₄=0.00%
H.P.=200-R.R.M.=720
W.G.=4.3 BLADE SETTING= 8
VOLTS=2300AMPS= 40
AUTOMATIC AIR LOCK DOORS


MINE 78
PORTAL

BELT/TRACK
=10,500CFM

STA. 245
ELEV. 1919.32
S. 649.06
E. 17197.35

STA. 243
ELEV. 1932.83
S. 649.08
E. 17544.66

DEEP MINE SAFETY 200
0 200 400 Feet

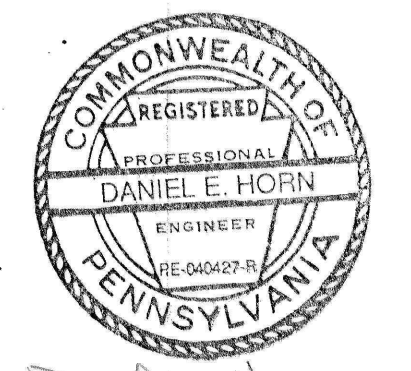

D.E.H.