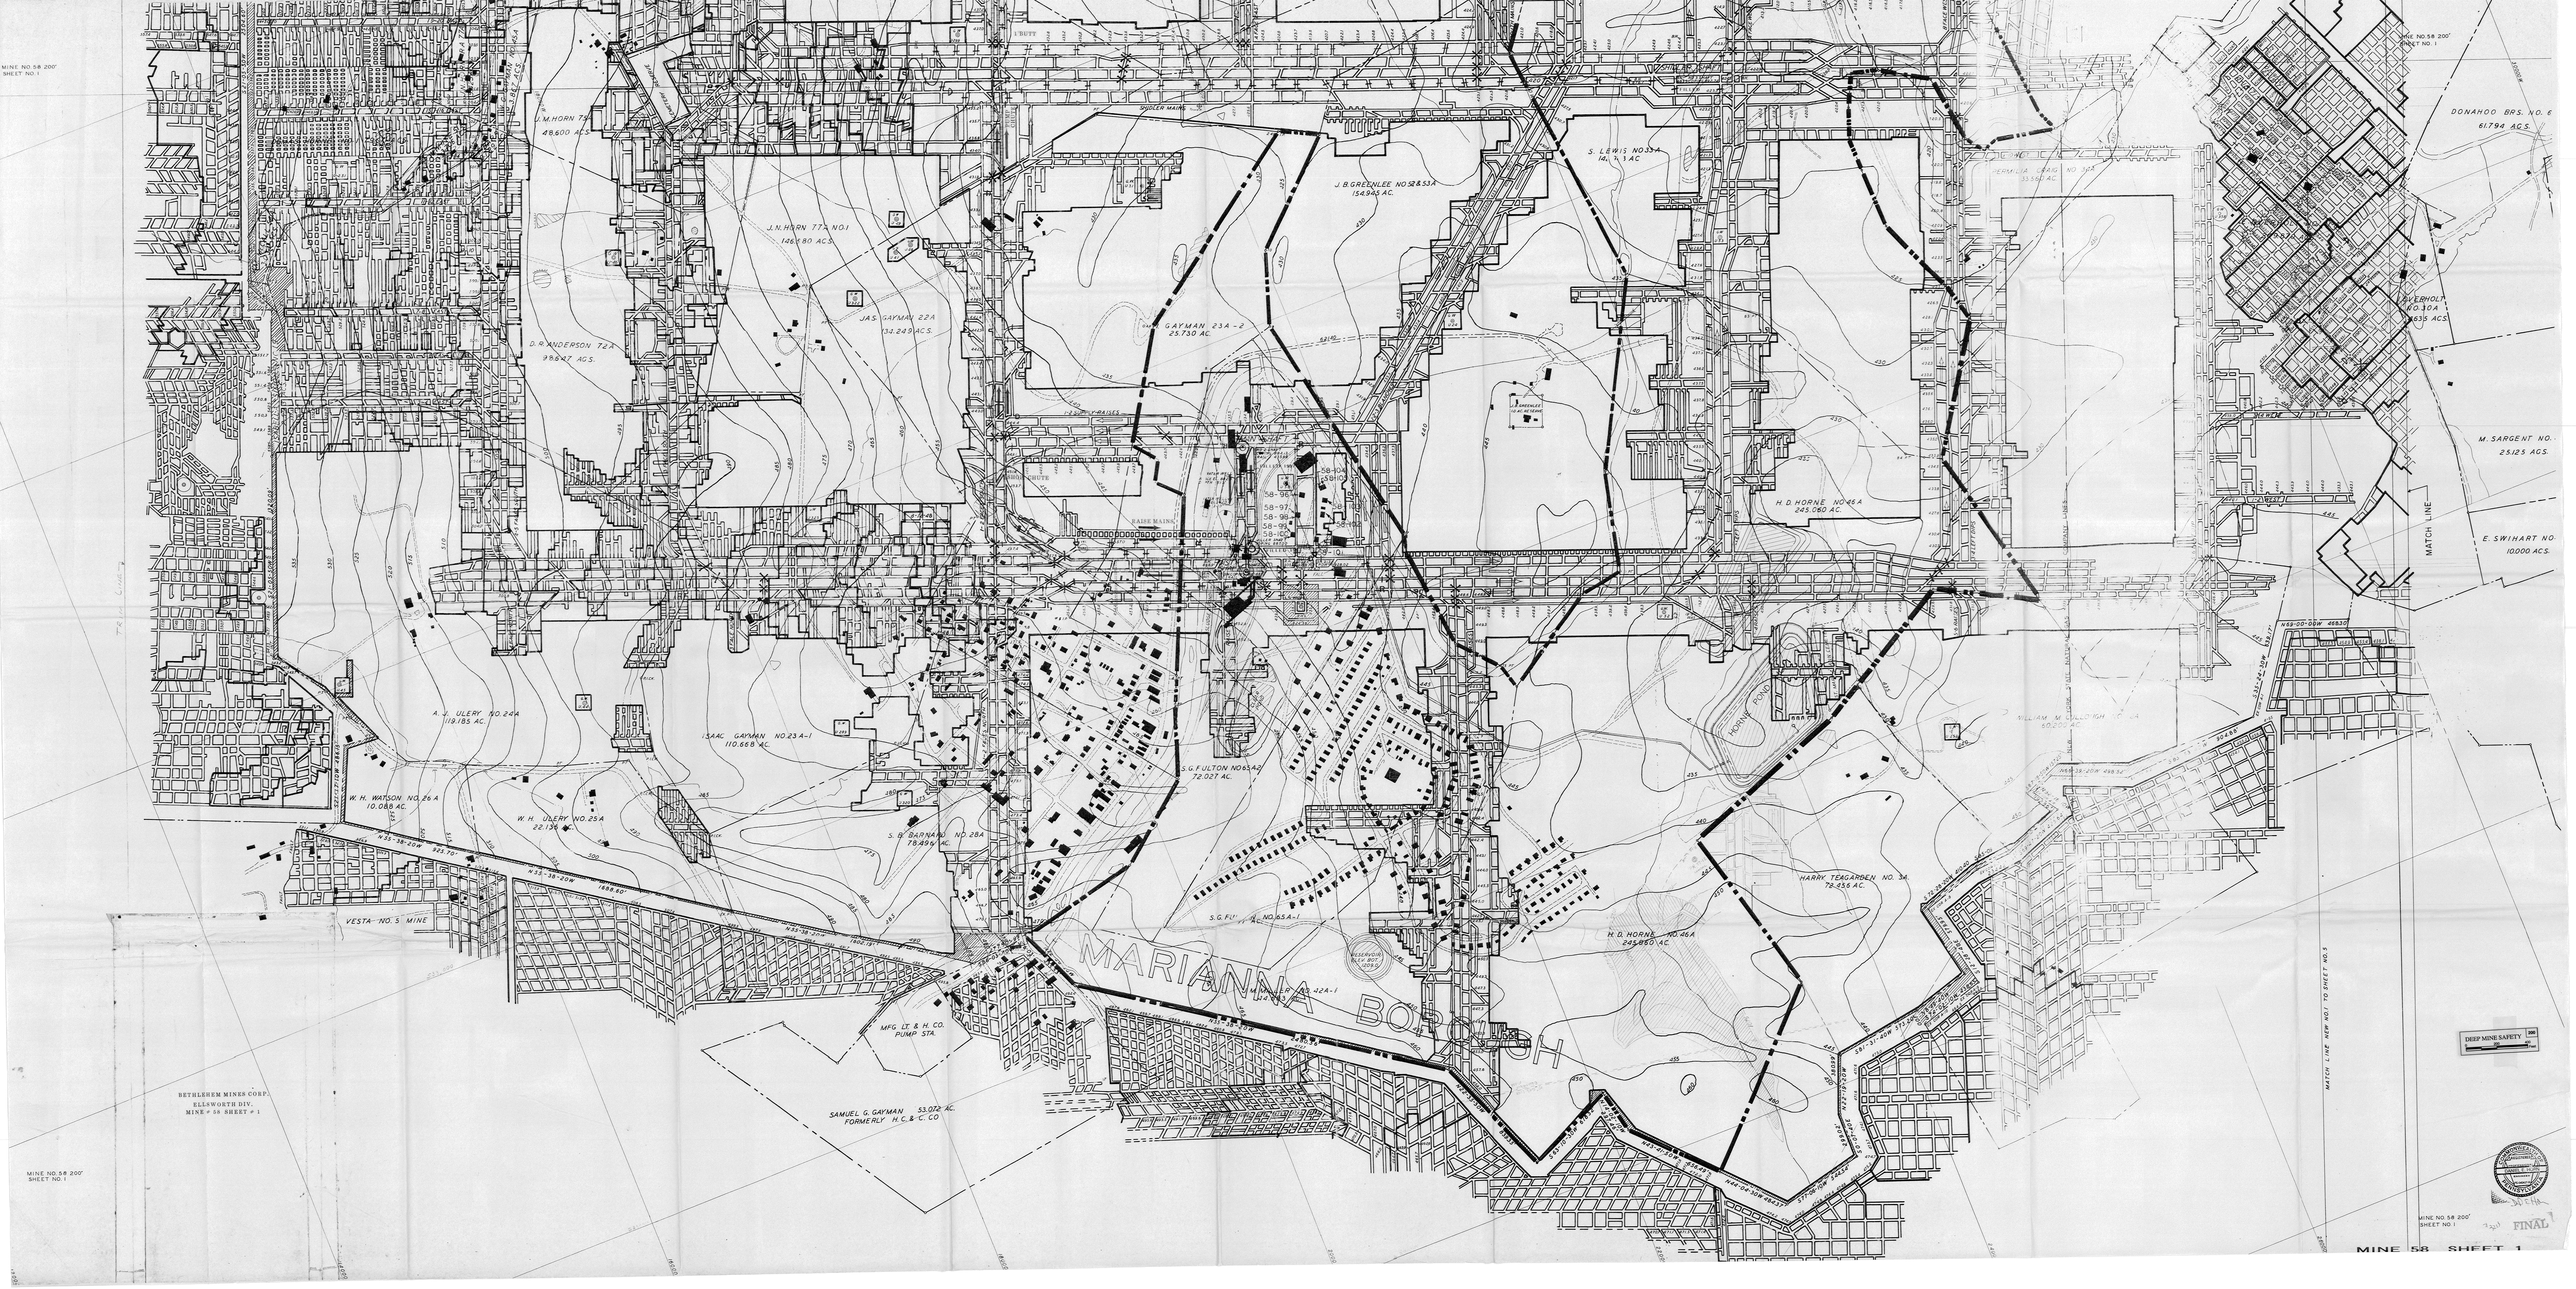
MINE NO. 58 200'
SHEET NO. 1
J.M. HORN 75
48.600 ACS.
J.N. HORN 77A NO. 1
146.680 ACS.
JAS. GAYMAN 22A
134.249 ACS.
D.R. ANDERSON 72A
98.647 ACS.
GAYMAN 23A-2
25.730 AC.
J.B. GREENLEE NO. 52 & 53A
154.945 AC.
S. LEWIS NO. 33A
DONAHOO BRS. NO. 6
61.794 ACS.
M. SARGENT NO.
25.125 ACS.
E. SWIHART NO.
10.000 ACS.
MATCH LINE
H.D. HORNE NO. 46A
245.060 AC.
A.J. ULERY NO. 24A
119.185 AC.
ISAAC GAYMAN NO. 23A-1
110.668 AC.
S.G. FULTON NO. 65A-2
72.027 AC.
W.H. WATSON NO. 26A
10.088 AC.
W.H. ULERY NO. 25A
22.136 AC.
S.B. BARNARD NO. 28A
78.496 AC.
HORNE POND
HARRY TEAGARDEN NO. 3A
72.456 AC.
VESTA NO. 5 MINE
MARIANNA BOROUGH
MFG. LT. & H. CO.
PUMP STA.
SAMUEL G. GAYMAN 53.072 AC.
FORMERLY H.C. & C. CO.
BETHLEHEM MINES CORP.
ELLSWORTH DIV.
MINE # 58 SHEET # 1
MATCH LINE NEW NO. 1 TO SHEET NO. 5
DEEP MINE SAFETY
FINAL
MINE 58 SHEET 1