FINAL

#3213

DEEP MINE SAFETY

200

0 200 400 Feet

COMMONWEALTH OF PENNSYLVANIA
REGISTERED PROFESSIONAL ENGINEER
DANIEL E. HORN
PE-040427-R

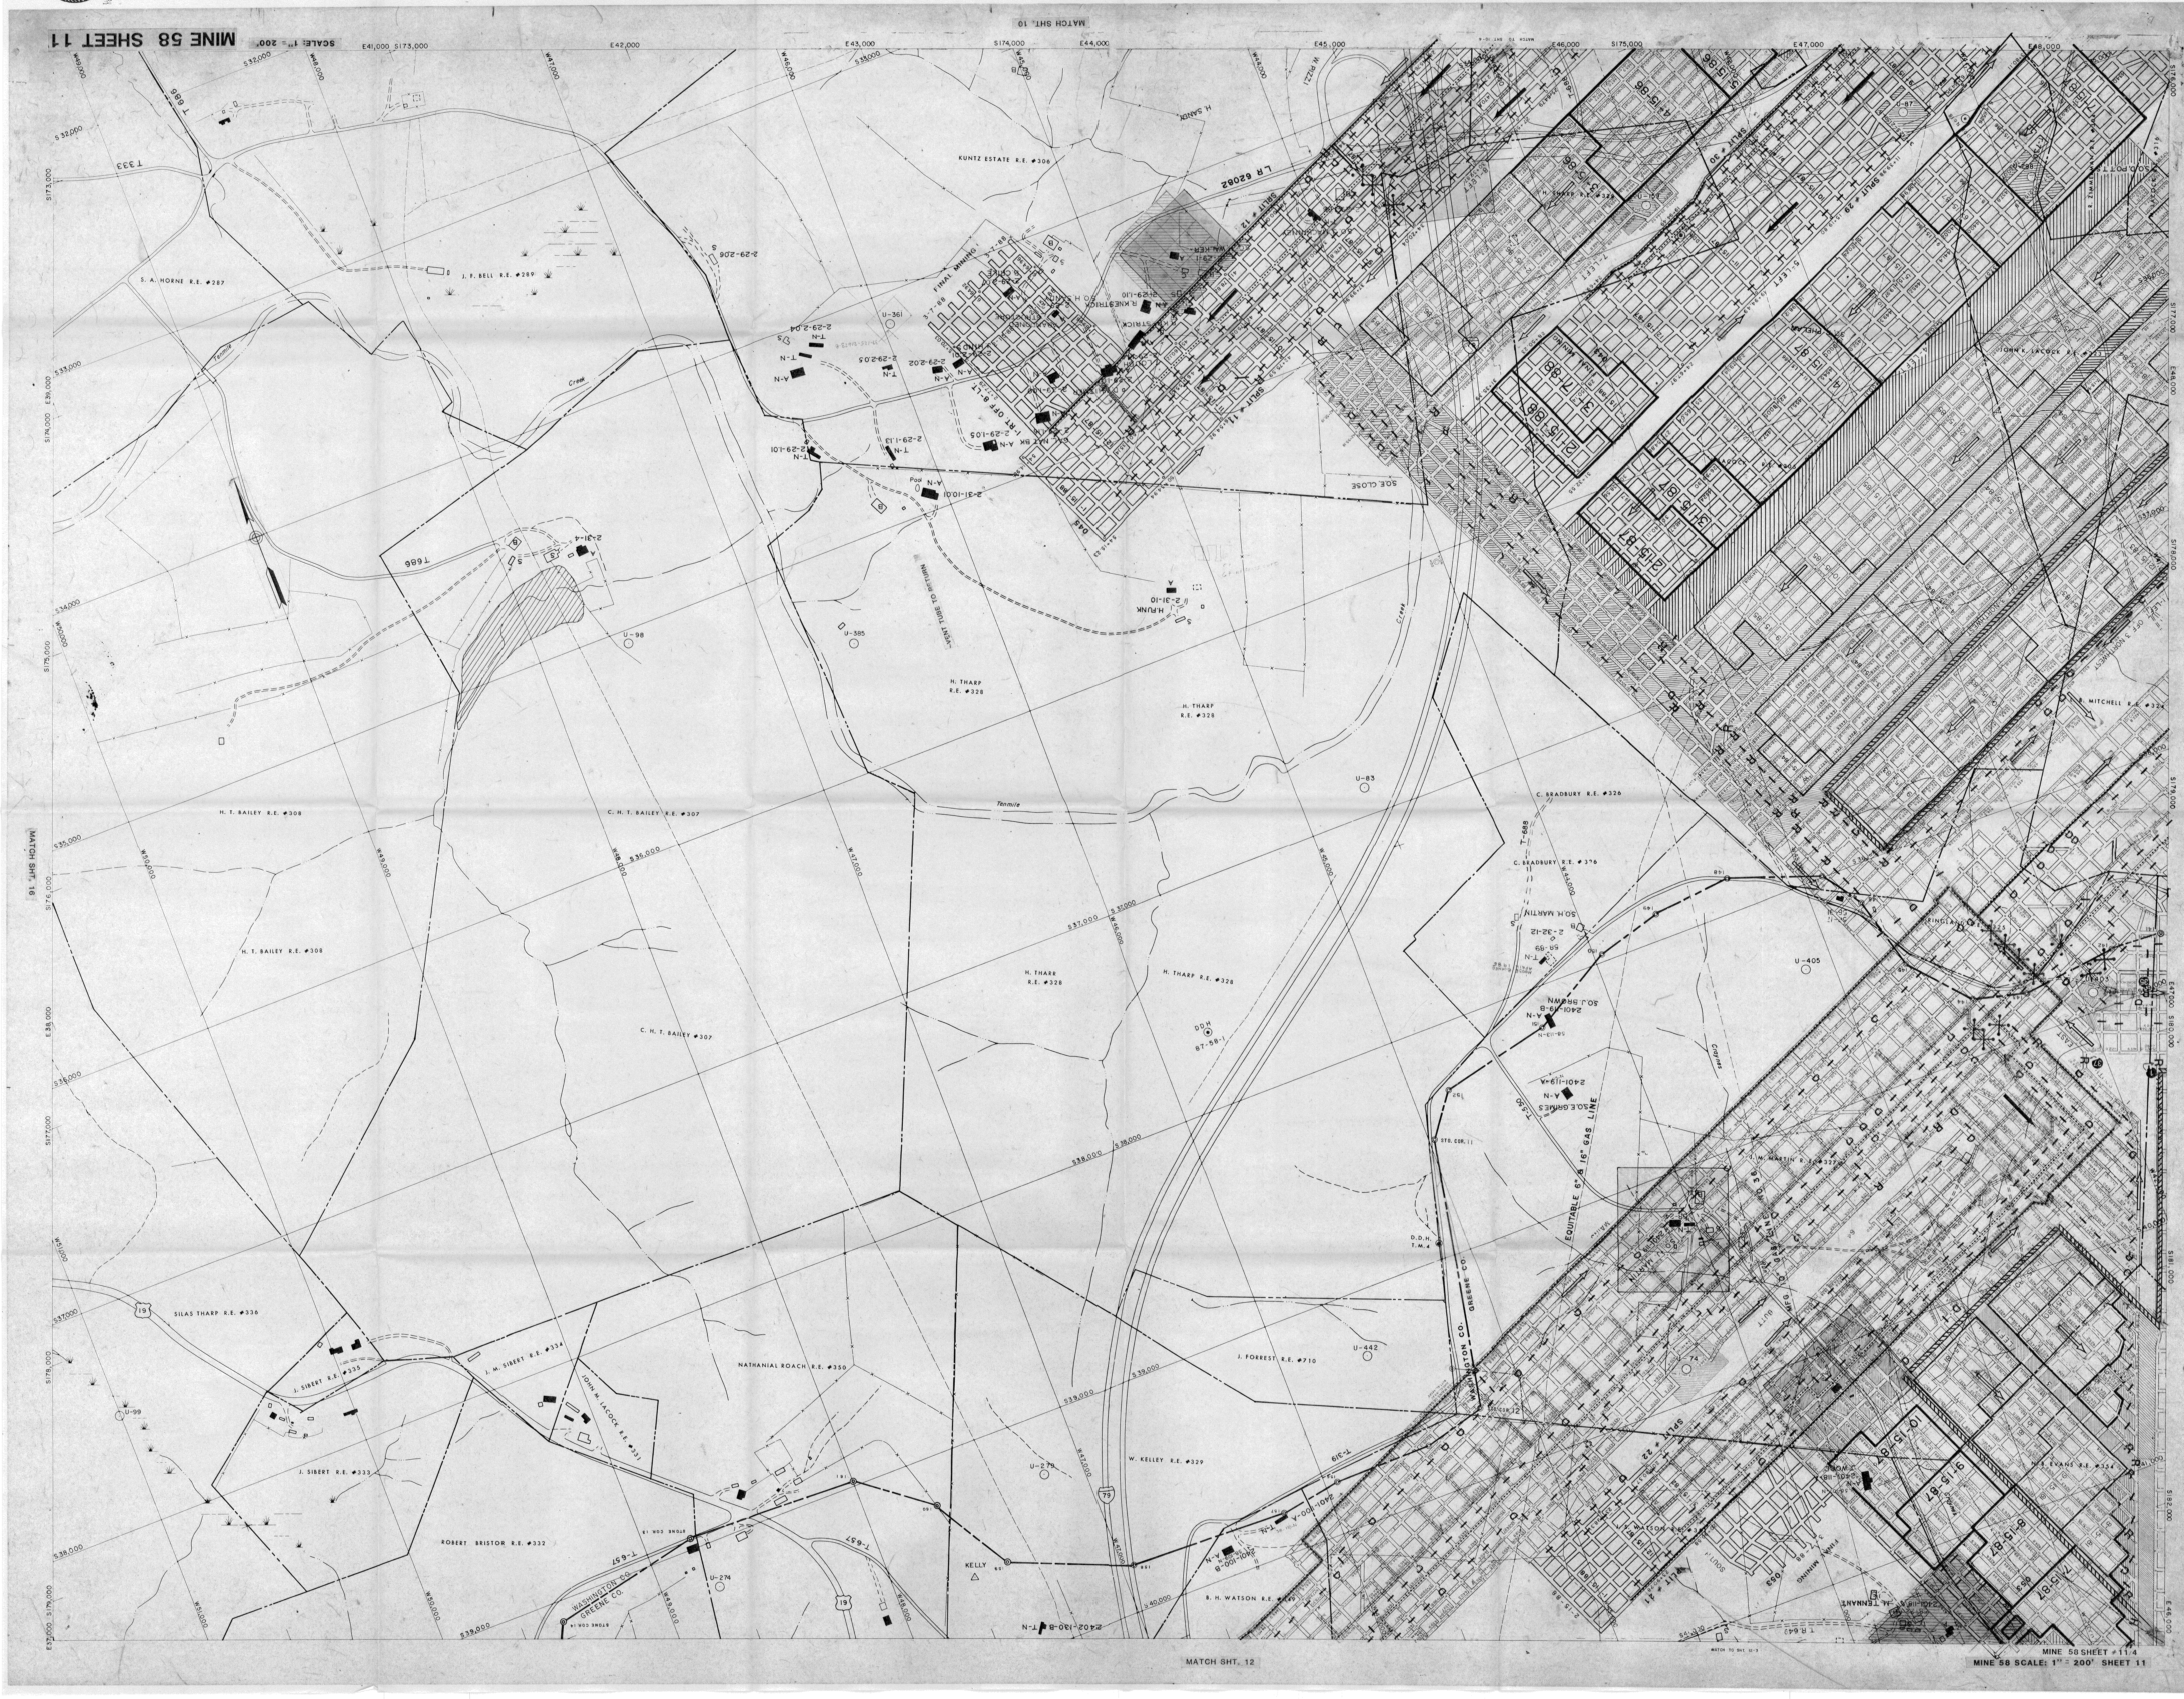
MINE 58 SHEET 11
SCALE: 1" = 200'
MATCH SHT. 10
MATCH TO SHT. 10-4
MATCH SHT. 6
MATCH SHT. 16
MATCH SHT. 12
MATCH TO SHT. 12-3
E41,000 S173,000
E42,000
E43,000
S174,000
E44,000
E45,000
E46,000
S175,000
E47,000
E48,000
S176,000
S177,000
S178,000
S179,000
S180,000
S181,000
S182,000
E46,000
E47,000
E48,000
E39,000
E38,000
E37,000
S32,000
S33,000
S34,000
S35,000
S36,000
S37,000
S38,000
S39,000
S40,000
S41,000
W44,000
W45,000
W46,000
W47,000
W48,000
W49,000
W50,000
W51,000
T 686
T333
T686
T-688
T-550
T-657
T-319
T.R.643
LR 62082
19
79
Tenmile Creek
Craynes
S. A. HORNE R.E. #287
J. F. BELL R.E. #289
KUNTZ ESTATE R.E. #306
H. SANDY
W. PIZZI
H. THARP R.E. #328
H. THARR R.E. #328
H. T. BAILEY R.E. #308
C. H. T. BAILEY R.E. #307
C. BRADBURY R.E. #326
JOHN K. LACOCK R.E. #323
LACOCK R.E. #305
R. ZIMMERMAN R.E. #304
S.O.D. POTTS
B. MITCHELL R.E. #324
RINGLAND R.E. #325
J. M. MARTIN R.E. #327
N. B. EVANS R.E. #354
S. WATSON R.E. #330
B. H. WATSON R.E.
W. KELLEY R.E. #329
J. FORREST R.E. #710
NATHANIAL ROACH R.E. #350
SILAS THARP R.E. #336
J. SIBERT R.E. #335
J. M. SIBERT R.E. #334
J. SIBERT R.E. #333
JOHN M. LACOCK R.E. #331
ROBERT BRISTOR R.E. #332
M. TENNANT
S.O.H. MARTIN
S.O.J. BROWN
S.O.E. GRIMES
S.O.E. CLOSE
S.O. PHELAN
S.O.H. SANDY
R. KNESTRICK
S.O. WALKER
S.O.J. MACKINNEY
H. FUNK
J. WOOL
KELLY
WASHINGTON CO.
GREENE CO.
EQUITABLE 6" & 16" GAS LINE
VENT TUBE TO RETURN
ABANDONED STRUCTURE
FINAL MINING
SPLIT #11
SPLIT #12
SPLIT #22
SPLIT #29
SPLIT #30
SPLIT #41
1-RT. OFF 8-LT.
8-LEFT
7-LEFT
5-LEFT
4-LEFT
1-LEFT OFF 3 NORTHWEST
EAST
SOUTH
BUTT
MFG.
2-29-2.06
2-29-2.04
2-29-2.05
2-29-2.02
2-29-1.13
2-29-1.01
2-29-1.05
2-29-1.10
2-31-10.01
2-31-10
2-31-4
2-32-12
2401-119-B
2401-119-A
2401-100-A
2401-100-B
2402-130-B
2401-118
58-89
58-113-N
58-110-N
58-101-N
A-N
T-N
Pool
U-361
U-385
U-98
U-83
U-87
U-159
U-298
U-405
U-403
U-74
U-442
U-279
U-274
U-99
DDH 87-58-1
D.D.H. T.M.4
STO. COR. 11
STO. COR. 12
STONE COR. 13
STONE COR. 14
148
149
150
151
152
156
157
158
159
160
161
045
053
043
2-15-88
3-7-88
15-88
7-15-88
3-15-86
4-15-86
12-15-87
2-15-87
3-15-87
4-15-87
7-15-87
8-15-87
9-15-87
10-15-87
5-15-87
S

MINE 58 SHEET #11/4

MINE 58 SCALE: 1" = 200' SHEET 11